


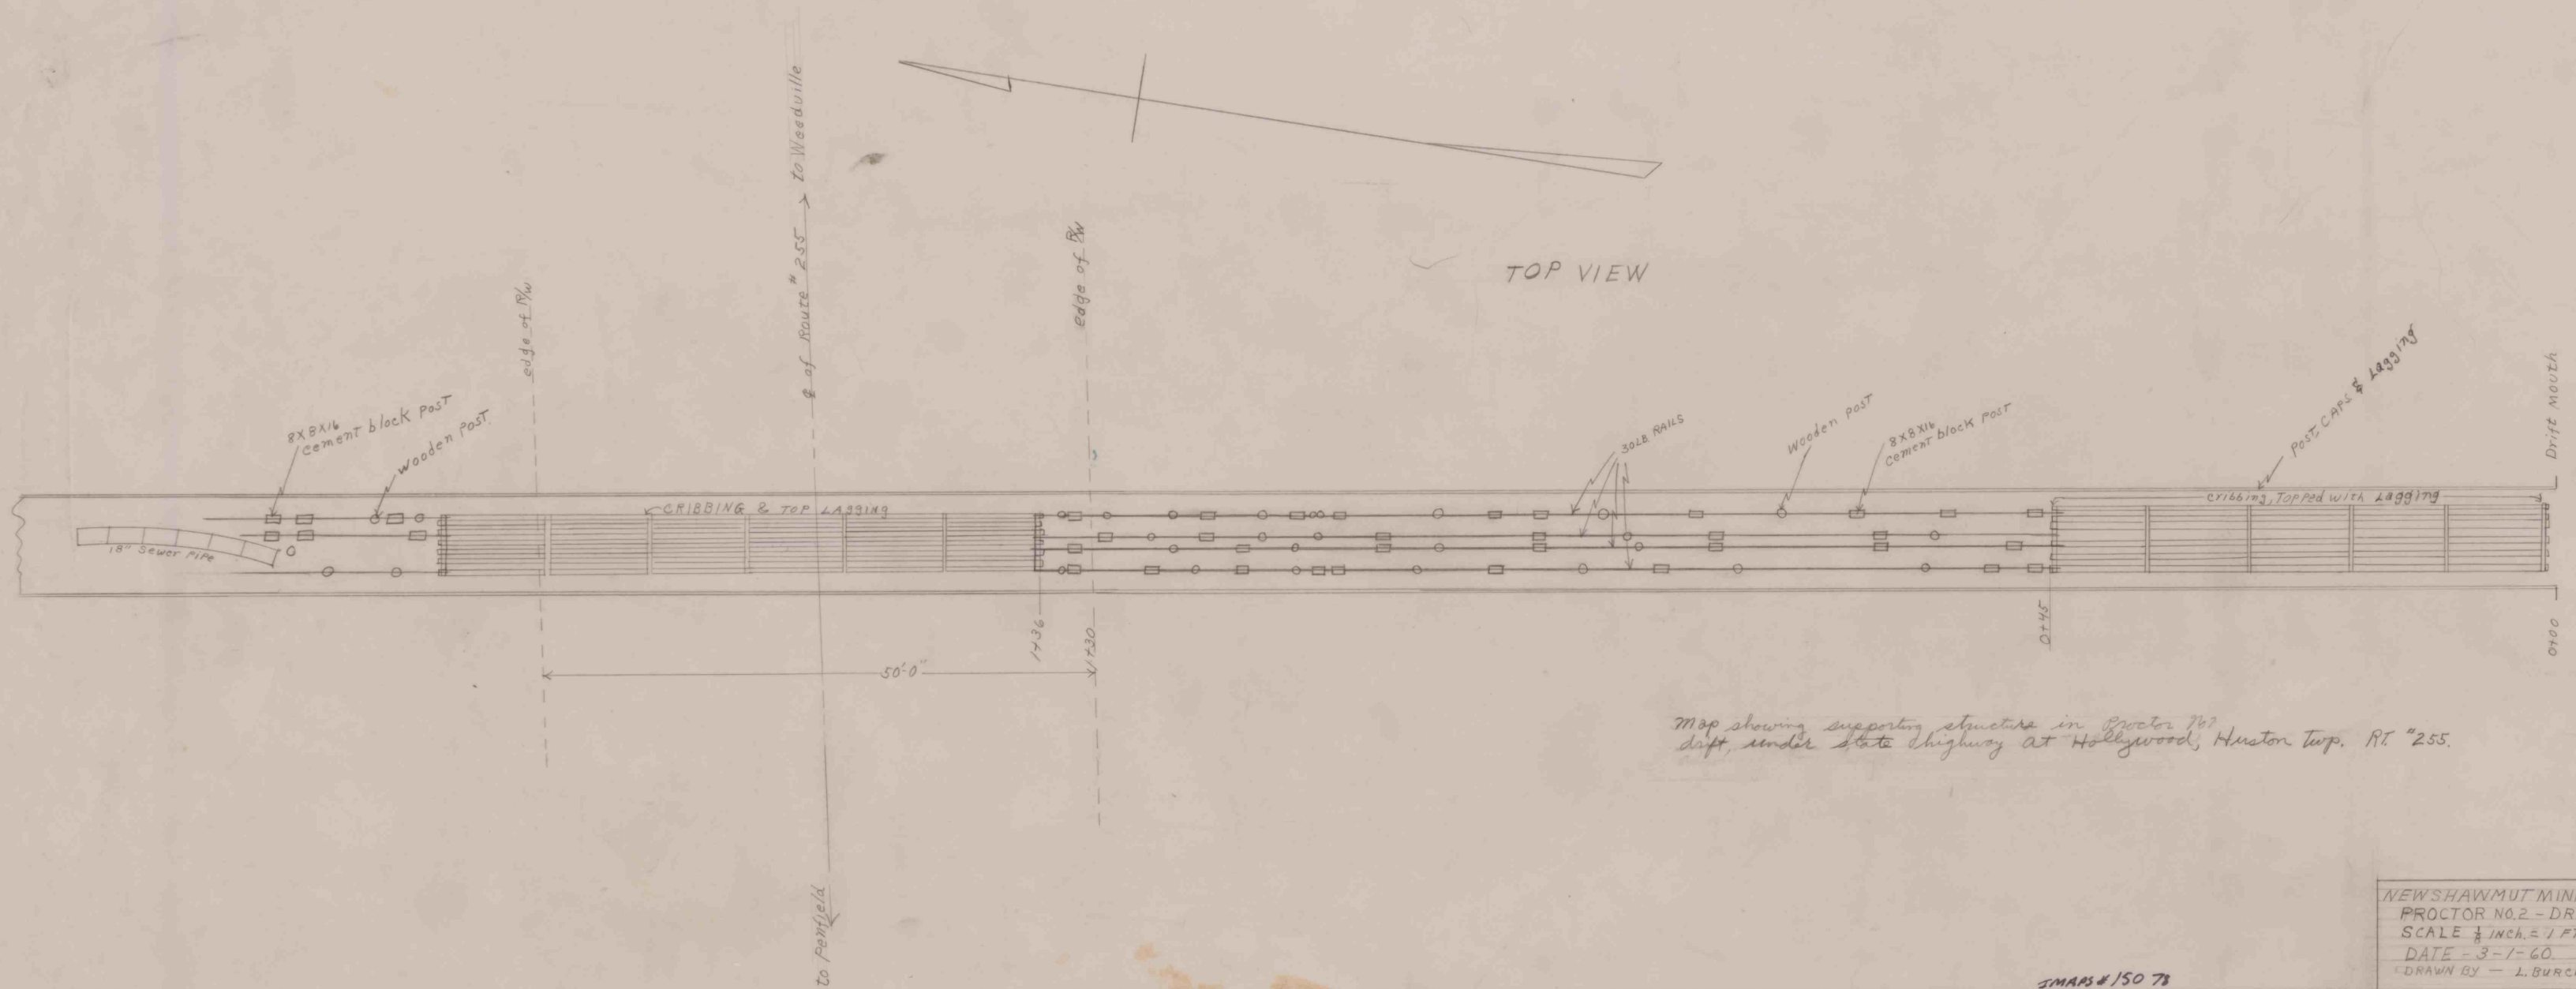

Map showing supporting structure in Proctor No. 2 drift, under state highway at Hollywood, Hurston Twp. RT. #255.

NEWSHAWMUT MINING CO.
 PROCTOR NO. 2 - DRIFT.
 SCALE $\frac{1}{8}$ inch = 1 FT.
 DATE - 3-1-60.
 DRAWN BY - L. BURCH

MAPS # 150 78