


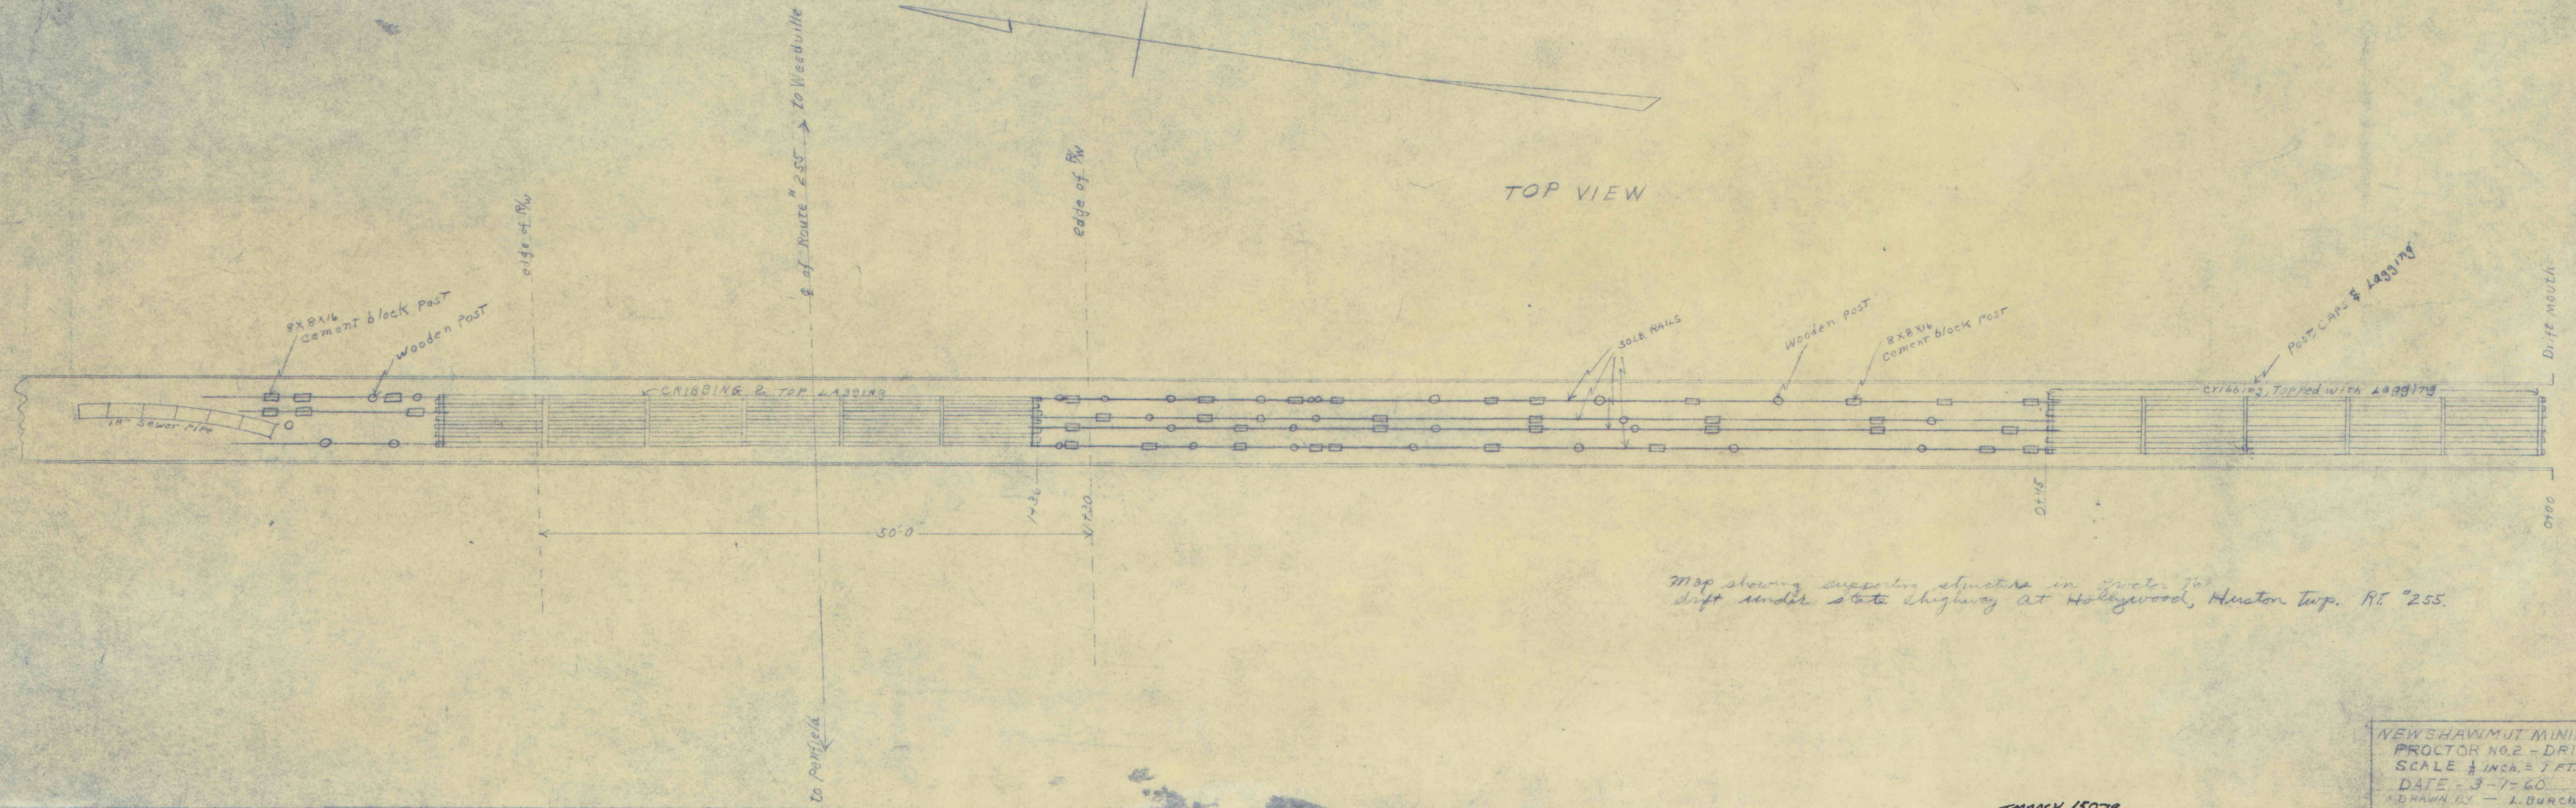

Map showing supporting structure in Proctor No. 2 drift under state highway at Hollywood, Houston Twp. RT. 255.

NEWSHAWMUT MINING CO.
PROCTOR NO. 2 - DRIFT.
SCALE 1/8" INCH. = 1 FT.
DATE - 3-7-60
DRAWN BY - L. BURCH

2MARS 15079