


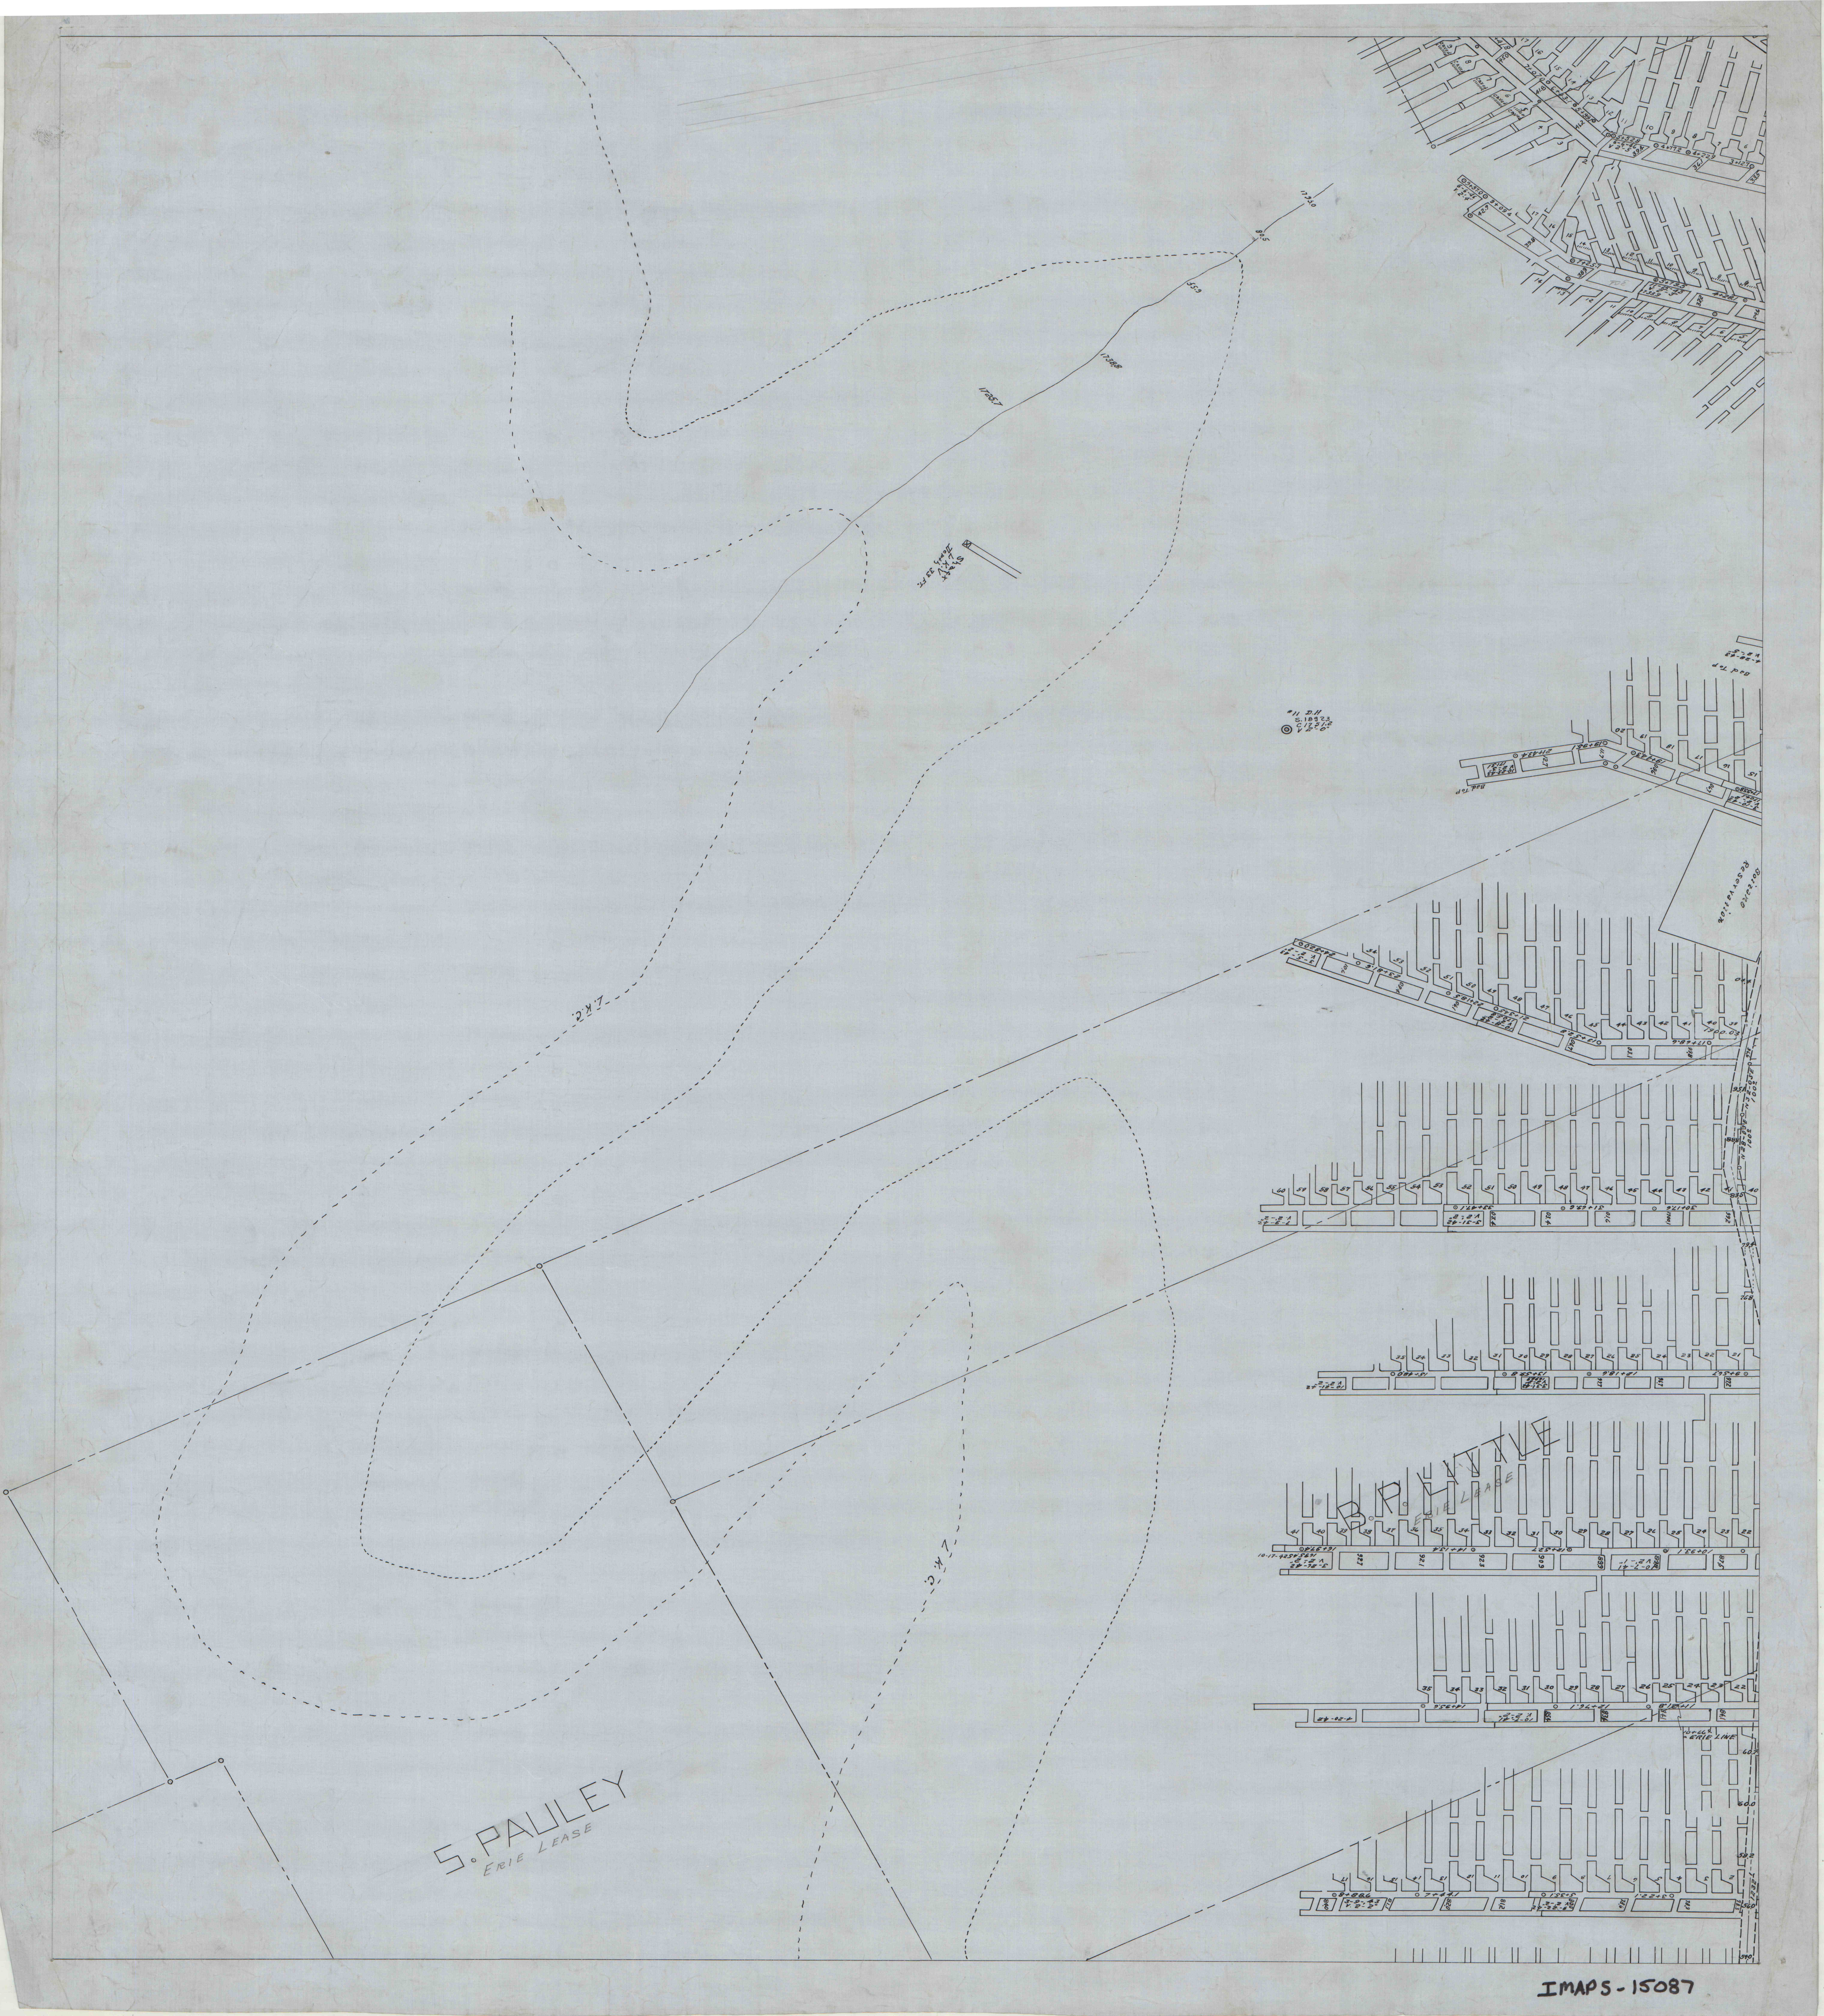

S. PAULEY  
ERIE LEASE