


#1 Proctor

#90
S1330.9
V12379
C.3-0"

1-11-34
V3-0

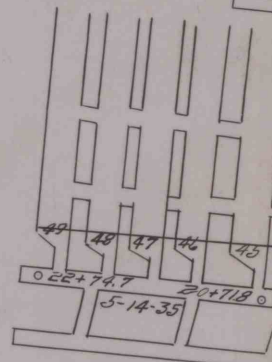

#79
S12920
V1257.2
C.3-4"

IMAPS 15091