


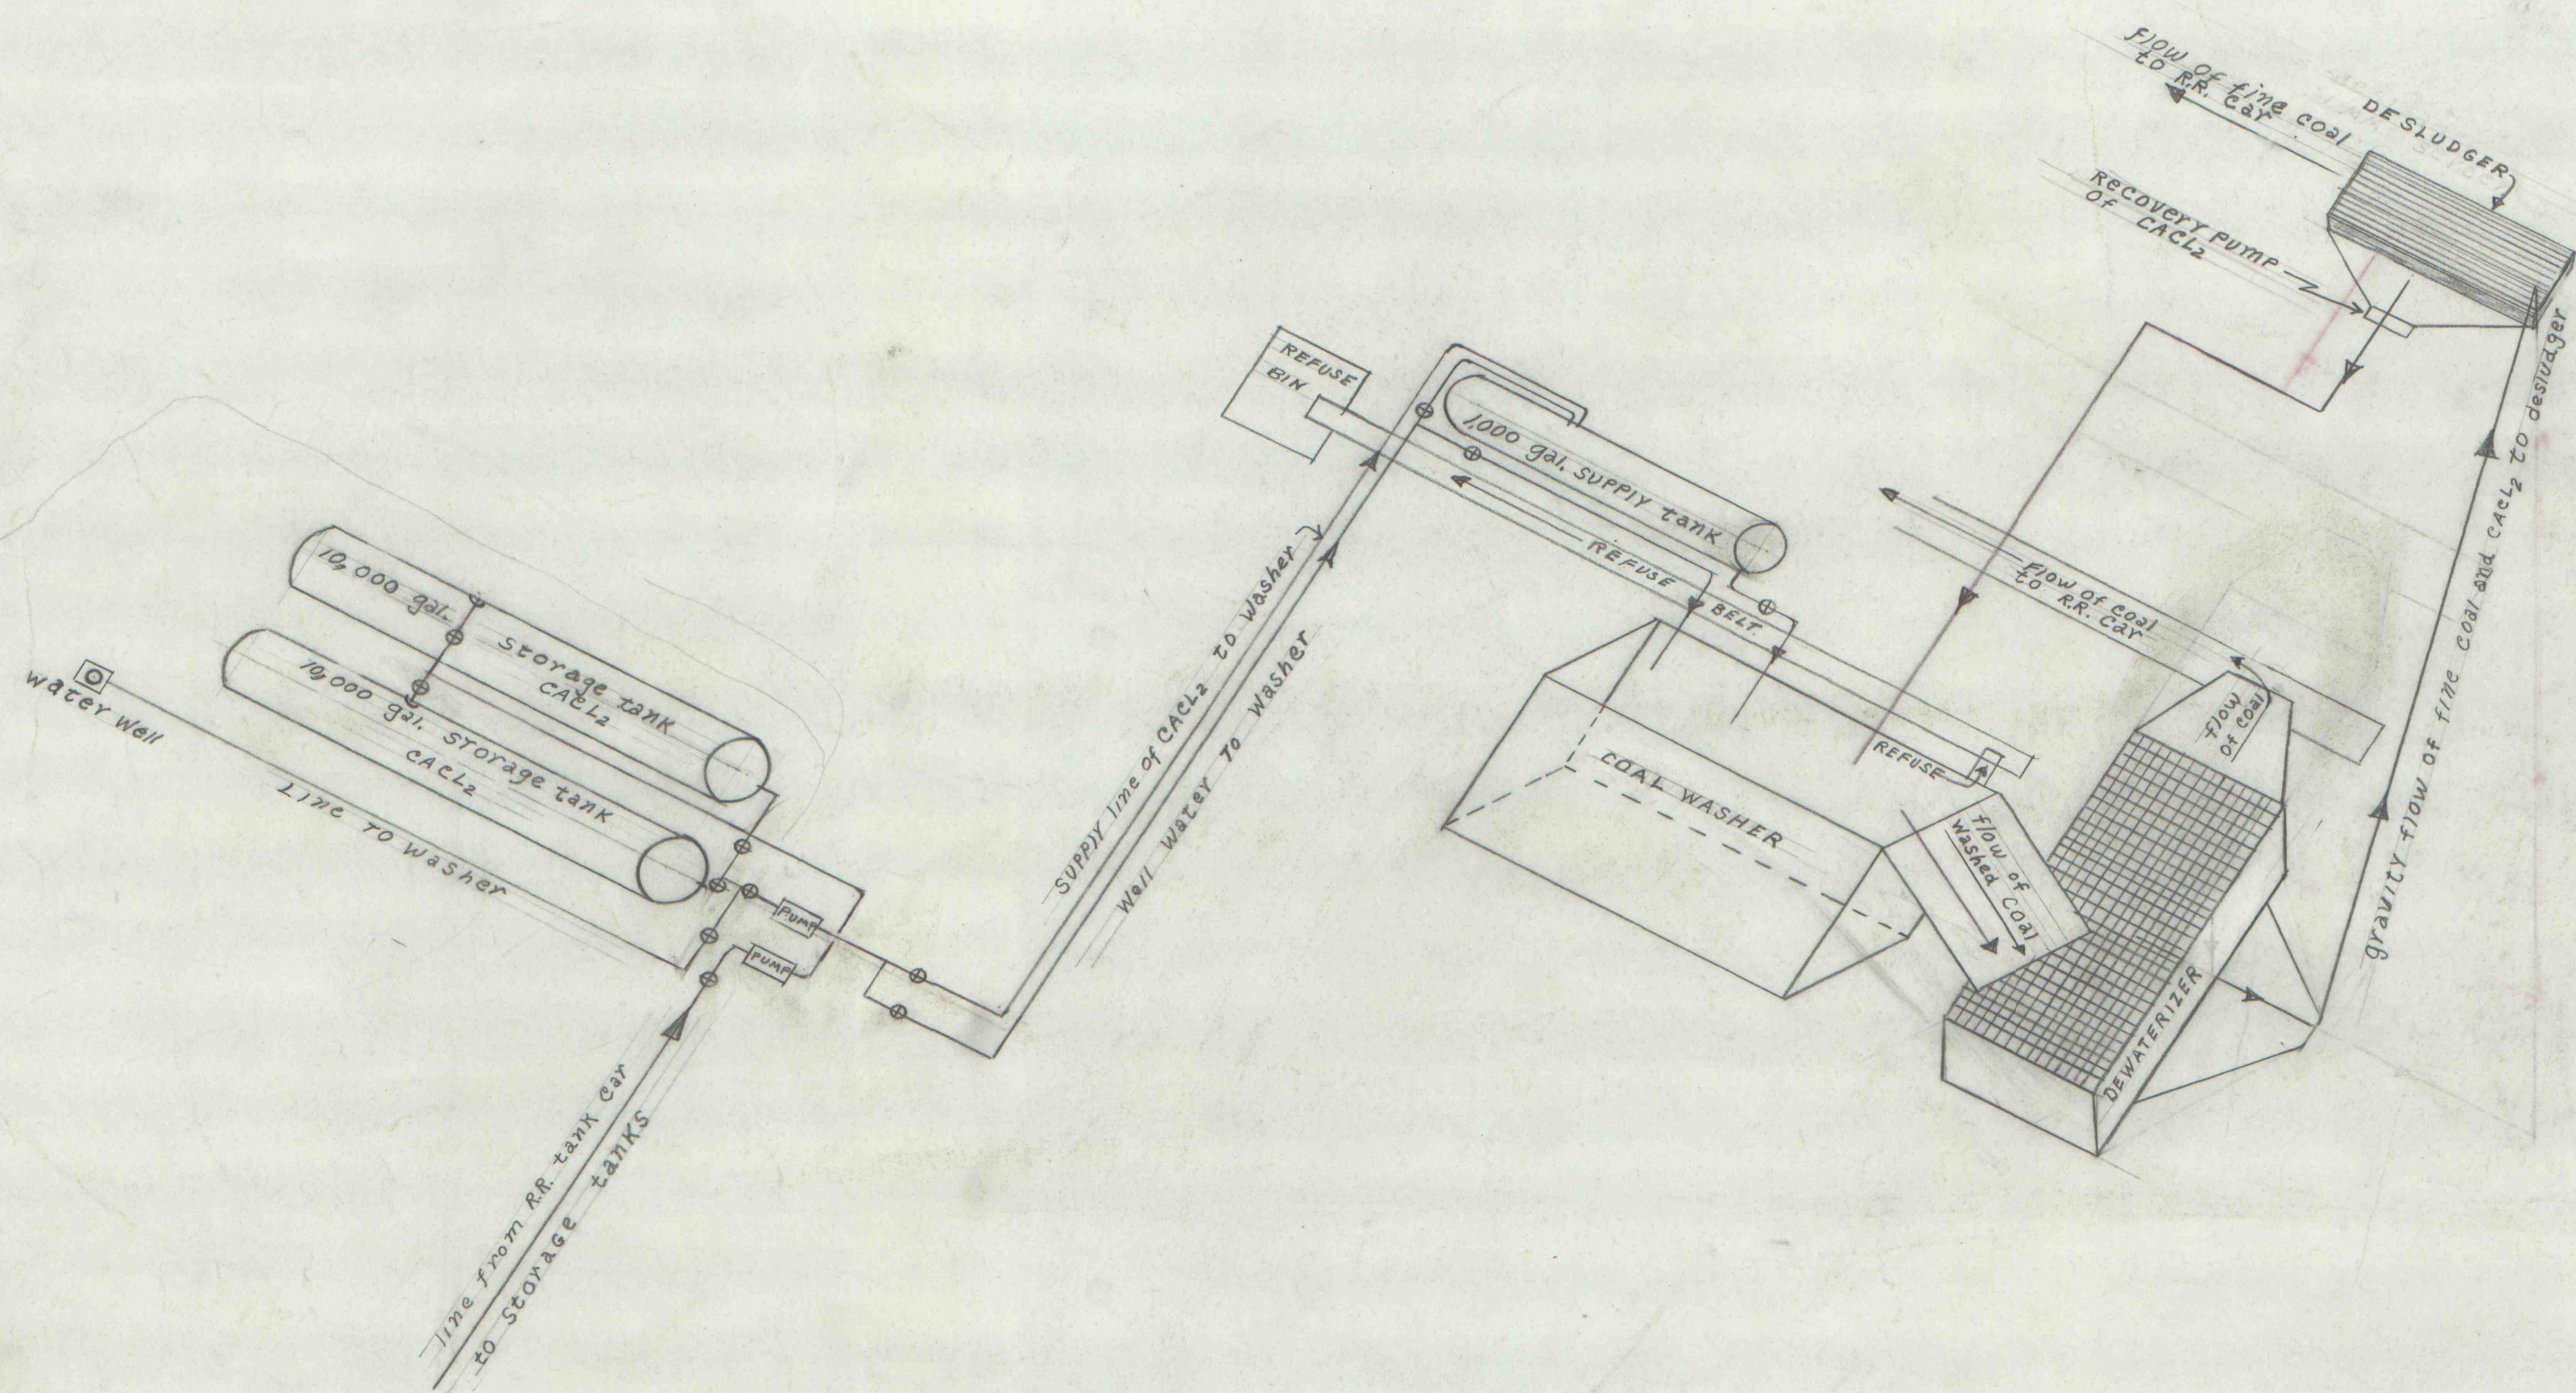

⊕ VALVE

— FLOW OF CaCl_2

- - - FLOW OF WELL WATER

NEW SHAWMUT MINING CO.
 ST. MARYS, PA.
 SCHEMATIC SKETCH OF CALCIUM
 CHLORIDE COAL WASHER INSTALLATION
 AT PROCTOR NO. 3 TIPPLE, TYLER, PA.
 DRAWN BY - LEWIS H. BURCH
 APPROVED BY -
 DATE - NOV. 23 1964 P-1-PR. 1-2

REVISED - ADDED REFUSE BELT & BIN, JAN-6-1964.
 FOR REGIONAL OFFICE IN WILLIAMSPORT

IMAPS # 15096

1022
 1053
 928
 3093