


TYLER EST.

817-37W
N 77-37E
91-37

91-37
77-37
N 12-00 W

100-00
77-37
20-21

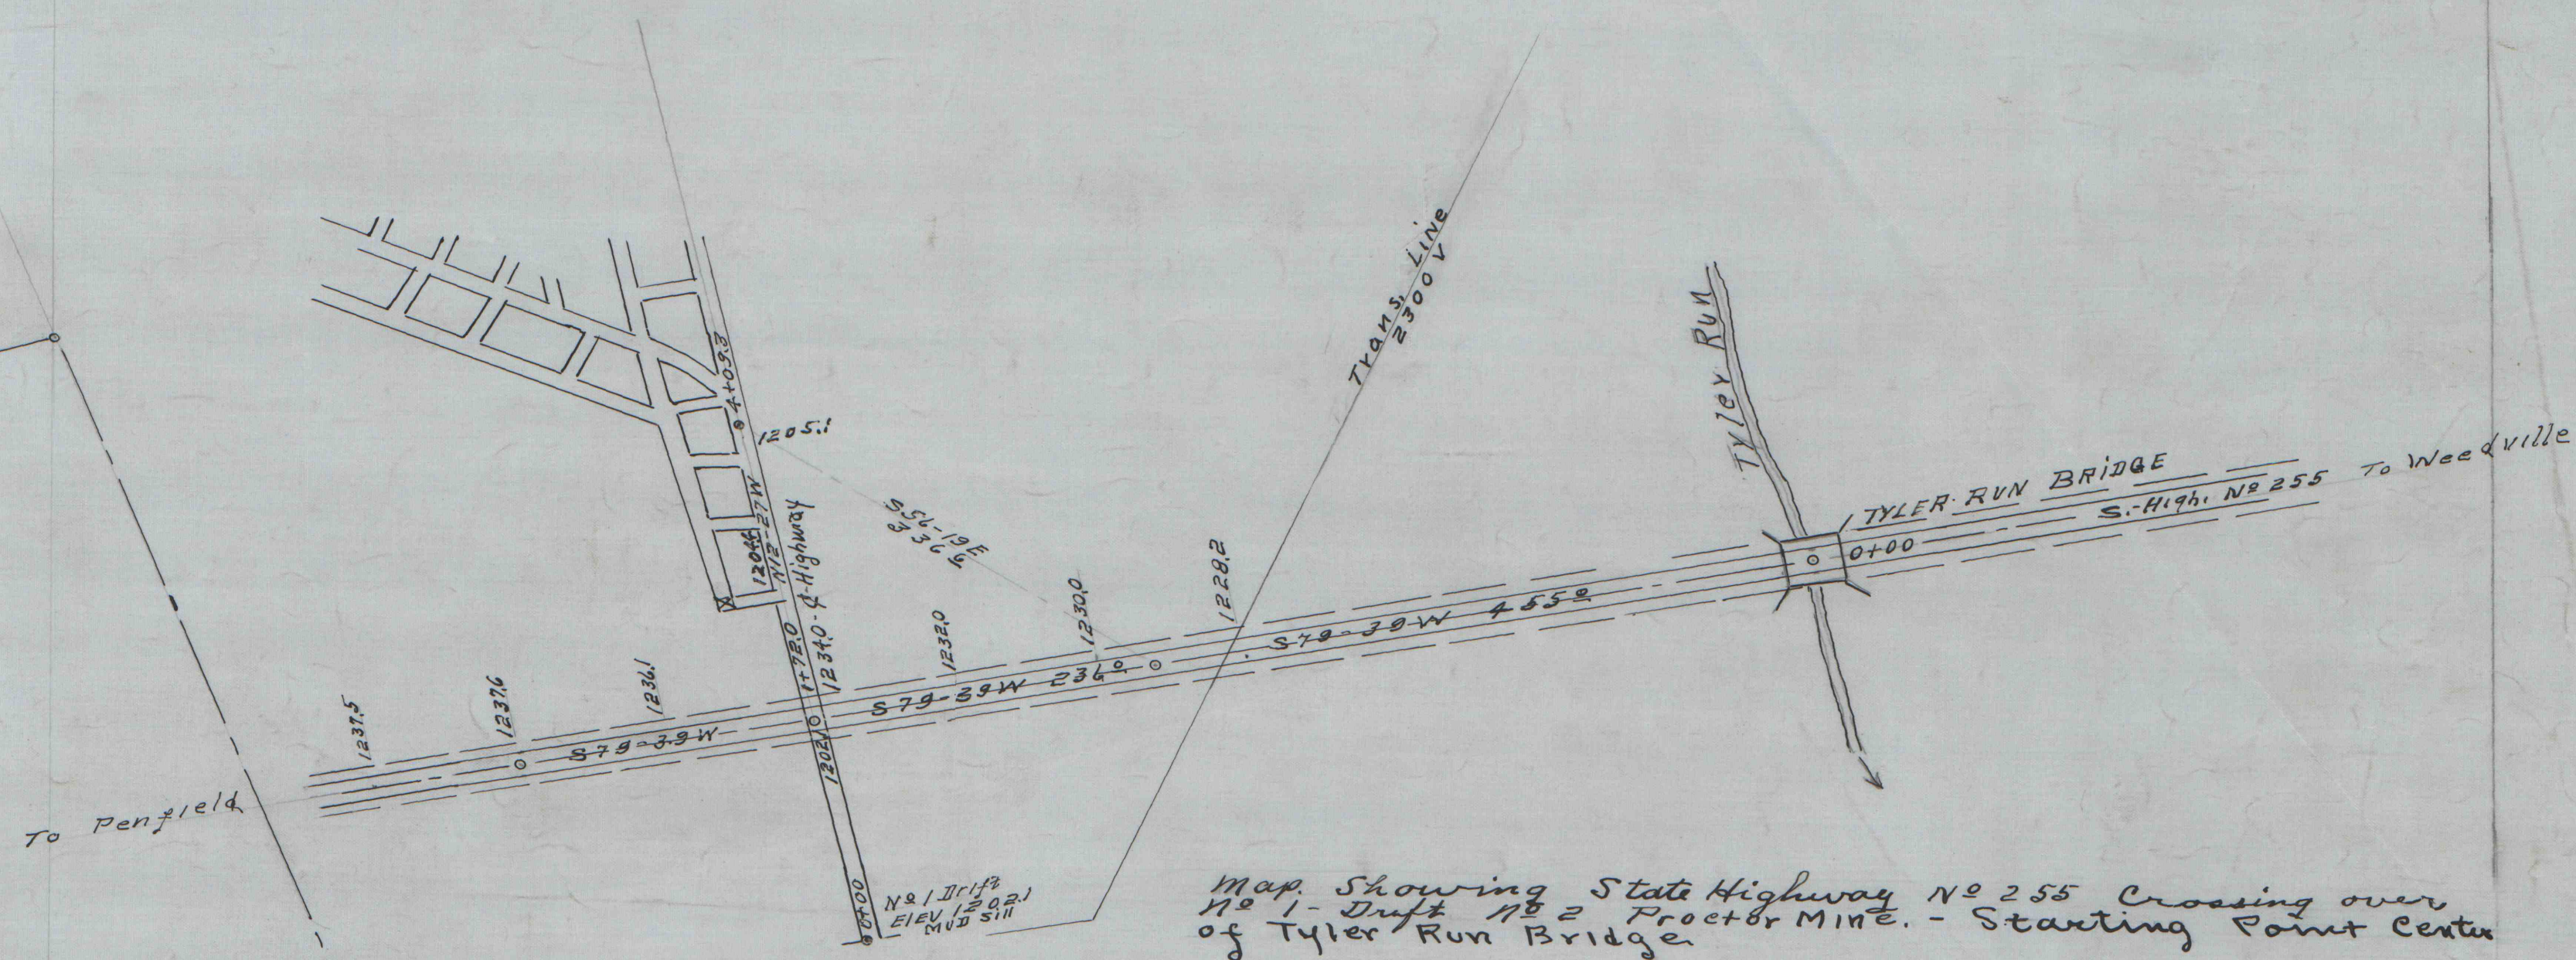

Map. Showing State Highway No 255 Crossing over
No 1 - Duff No 2 Proctor Mine. - Starting Point Center
of Tyler Run Bridge
3-4-1938

NEW SHAWMUT MINING CO. NO 2
MINE. HOLLYWOOD. PA.
OWNER S.M.CO. SURFACE-AND
1/4-INST. OF COAL.

Shawmut Mining Co. St. Marys. Pa.
R. R. Brown, Engr. Byrnedale, Pa.
Scale - 1-INCH = 100 FT.