


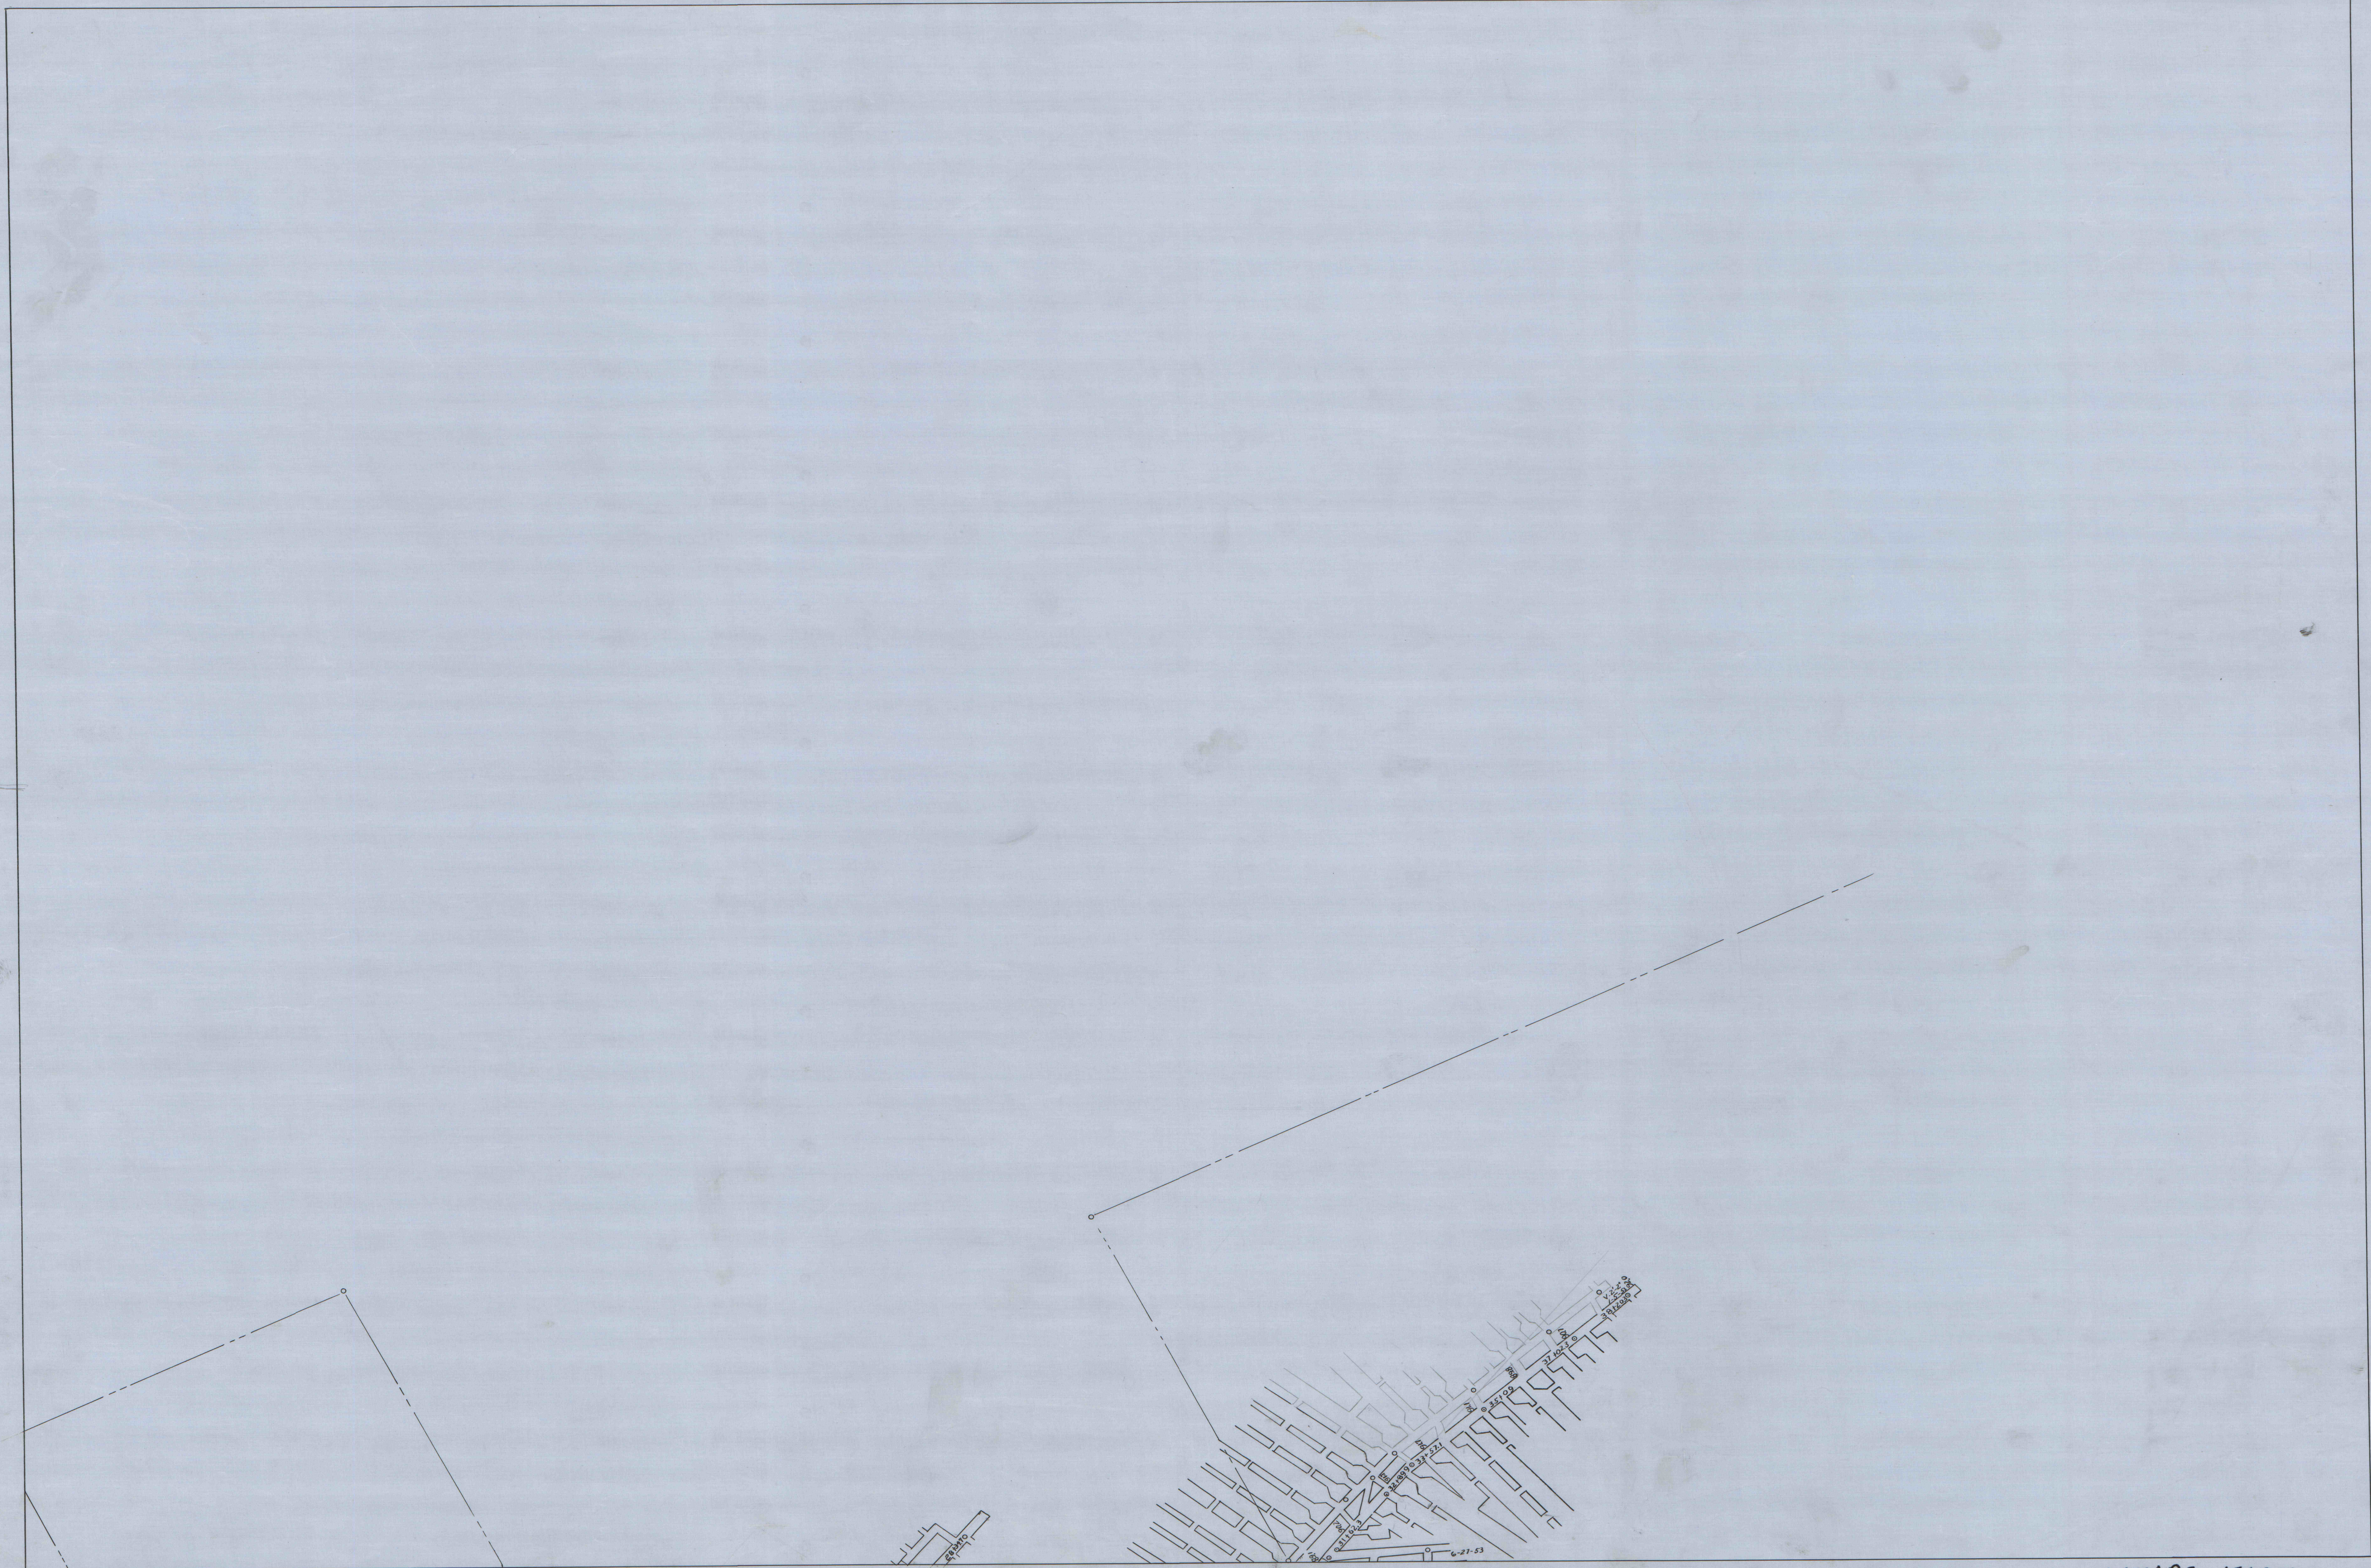

IMAPS-15105