


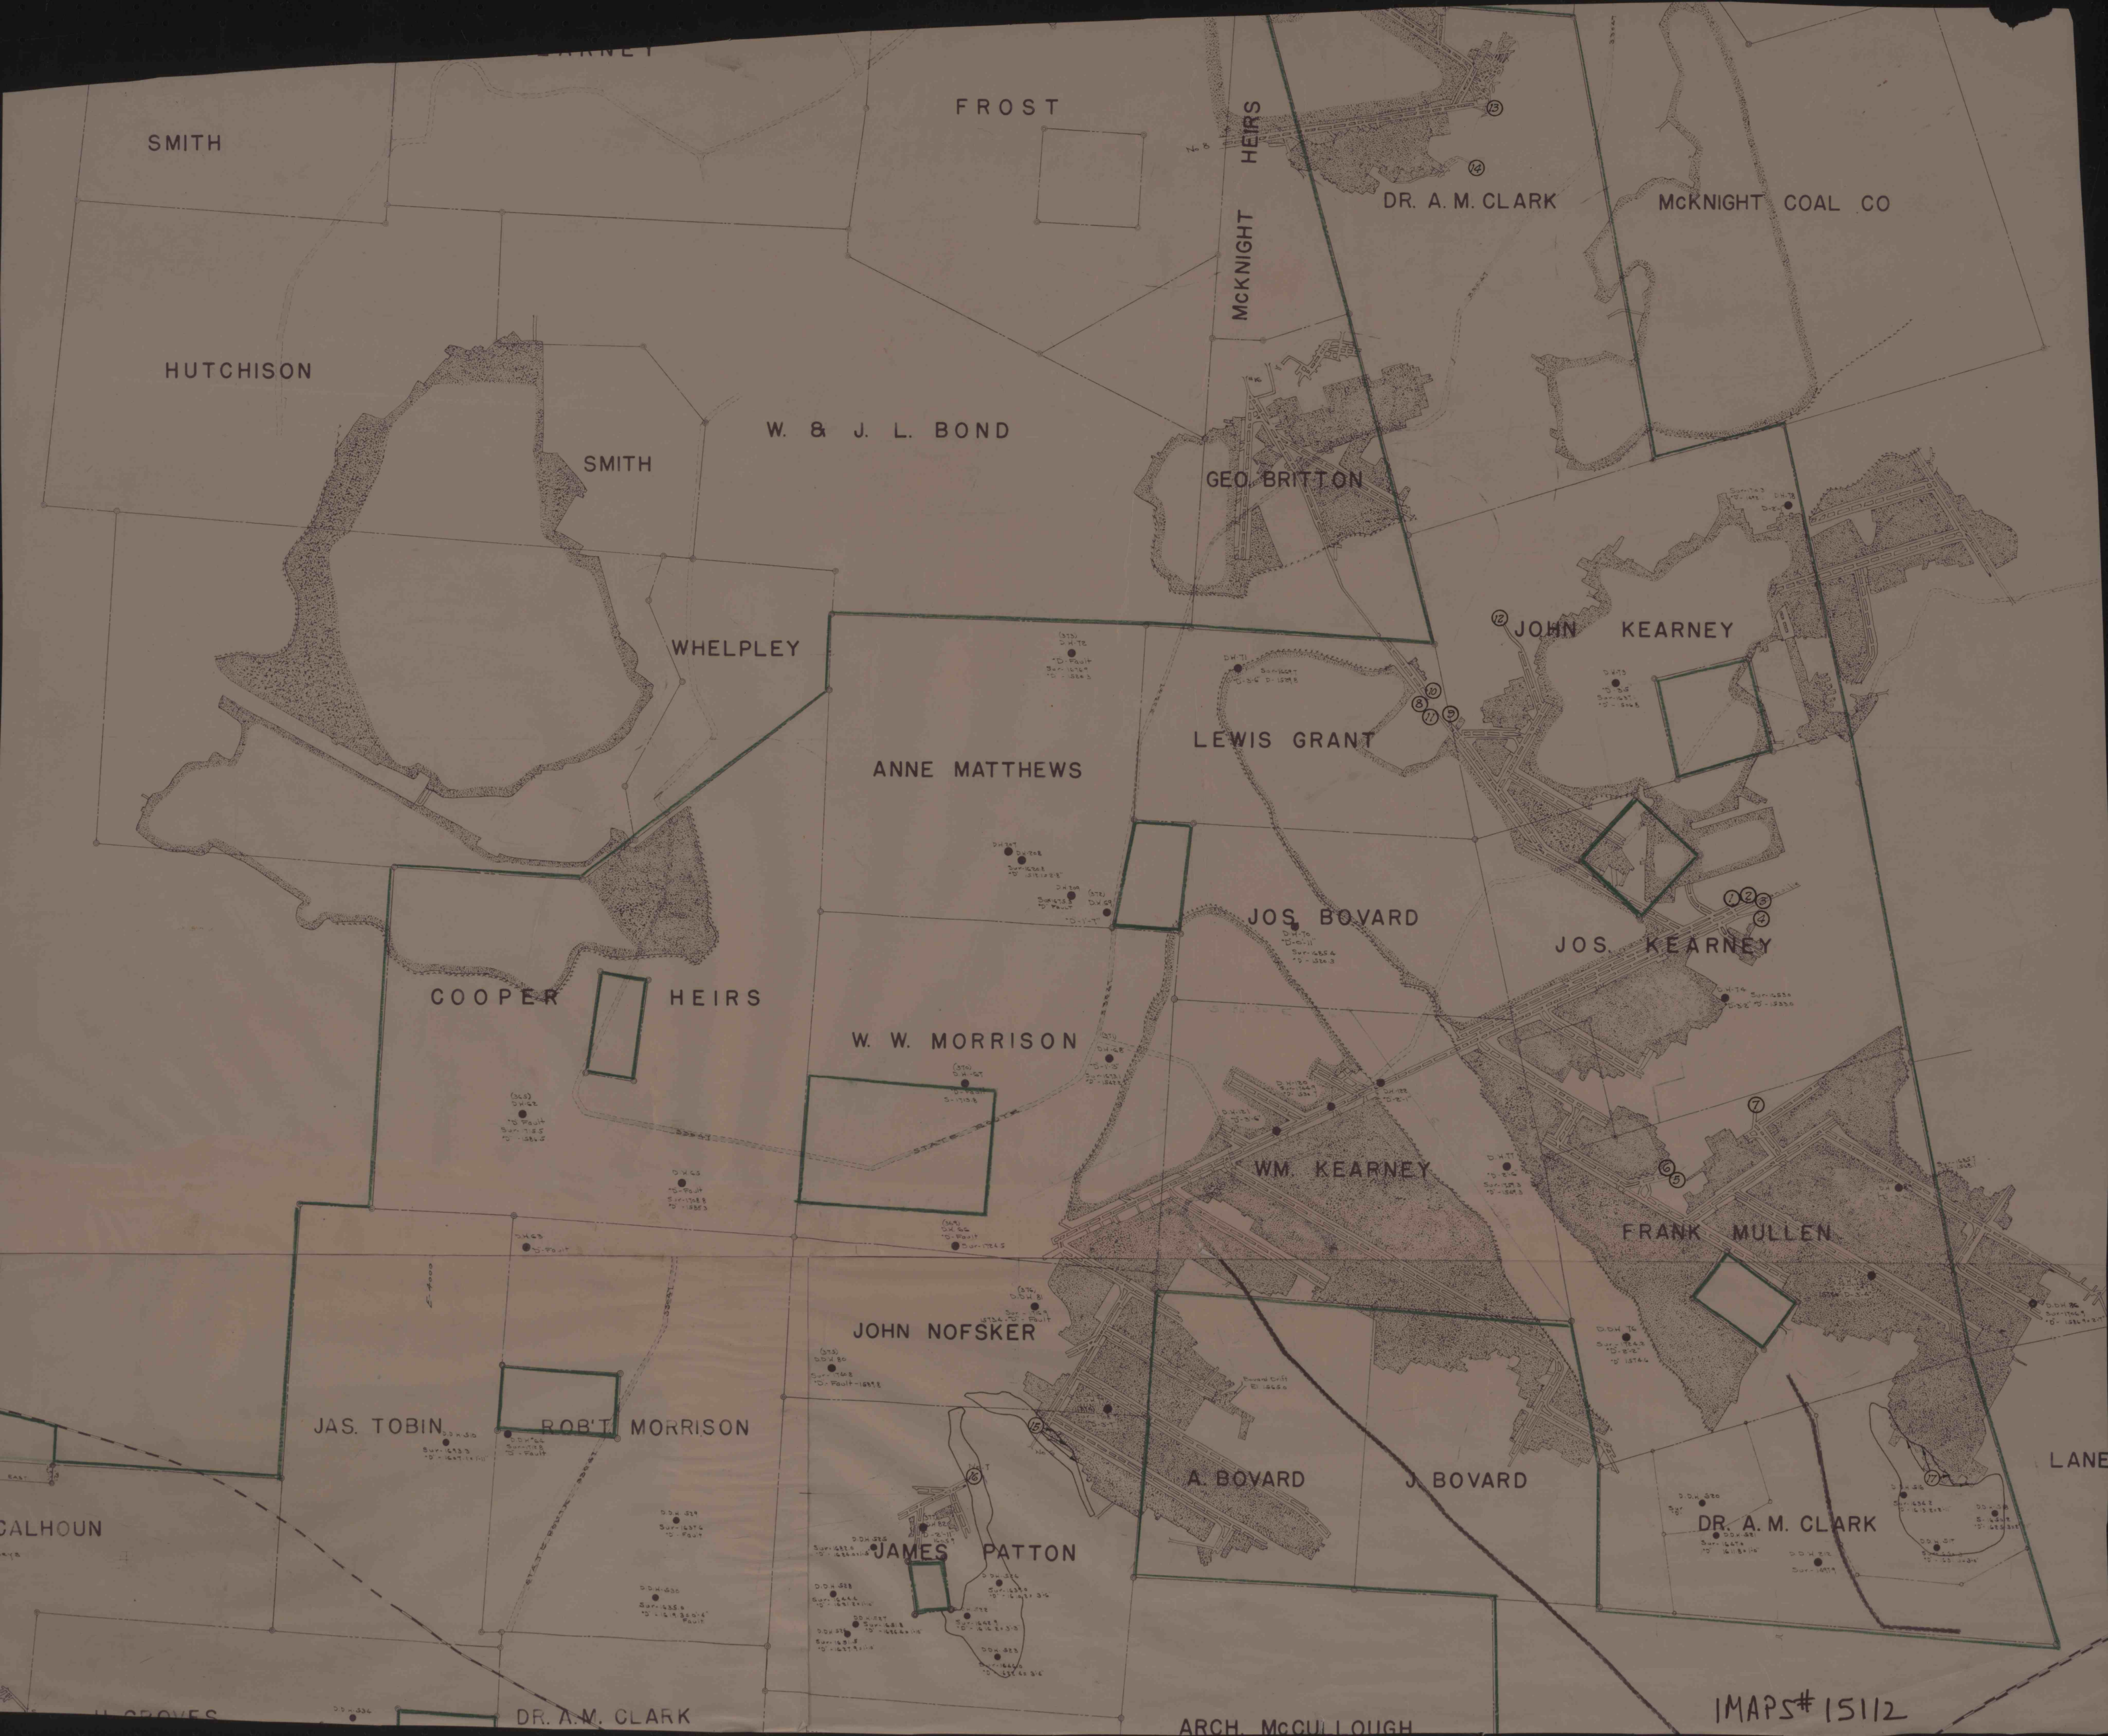

IMAPS# 15112