


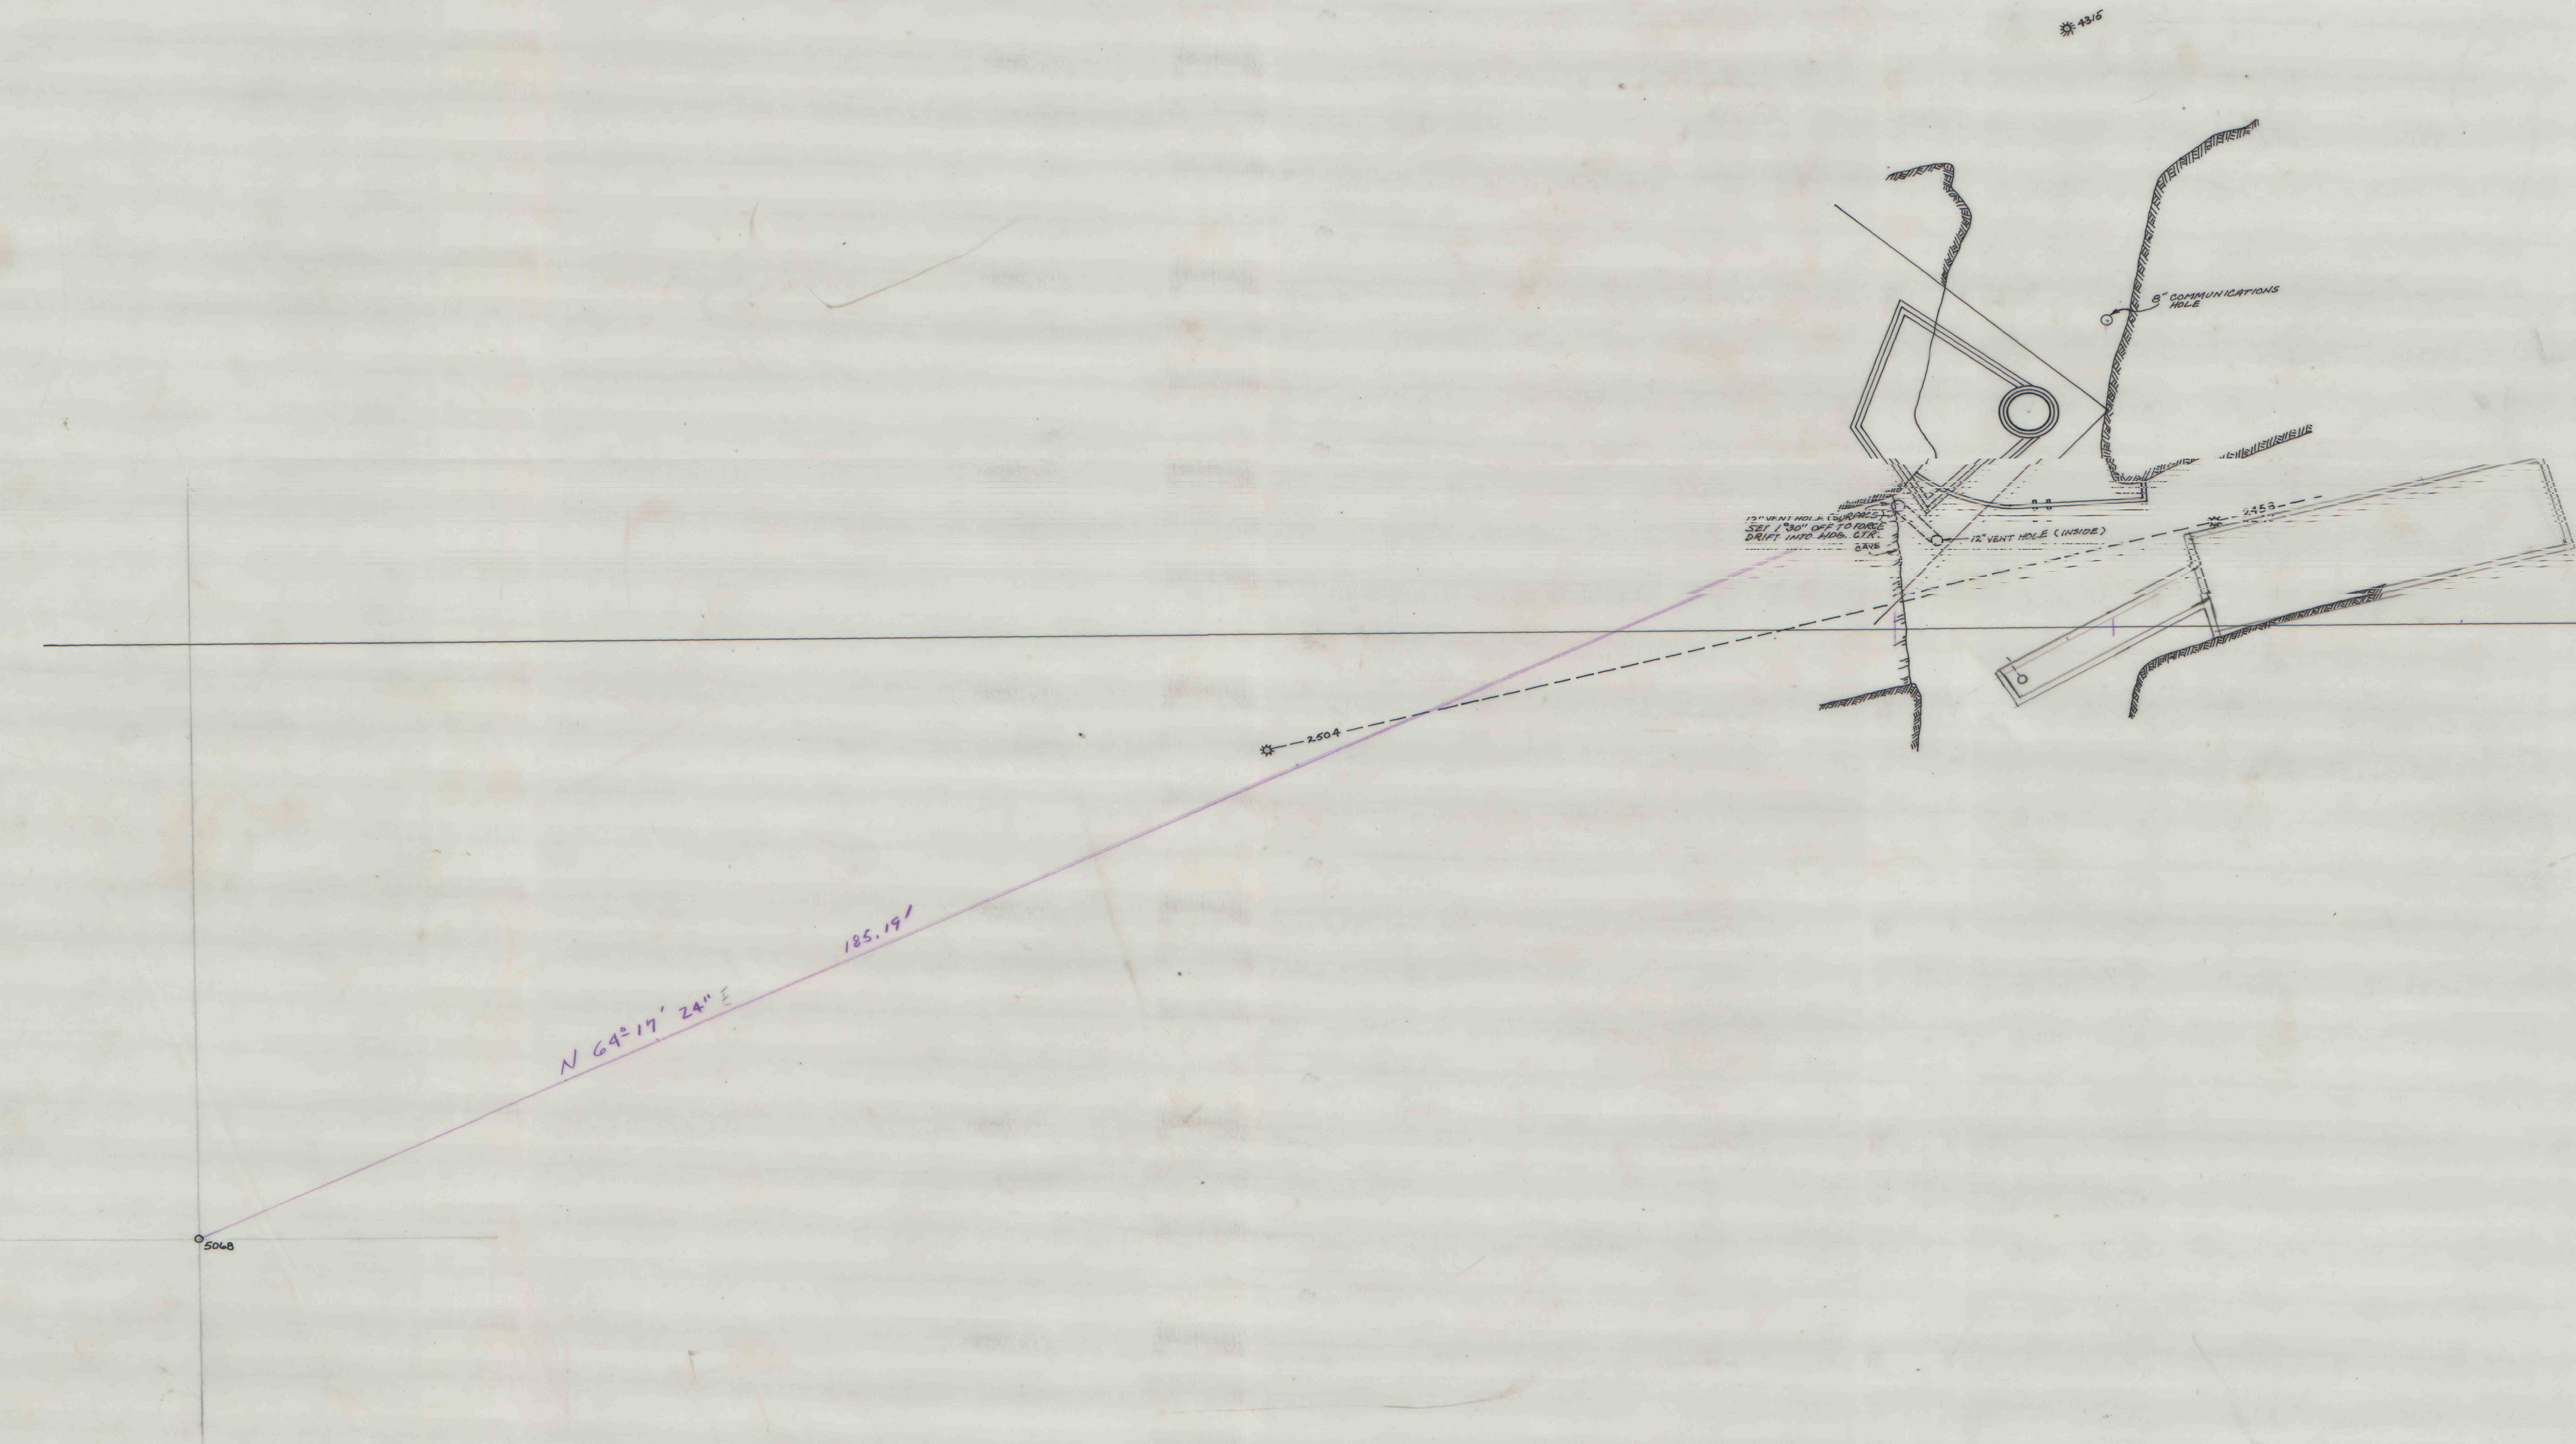

IMAPS # 15122

W 30750

1"=10'