


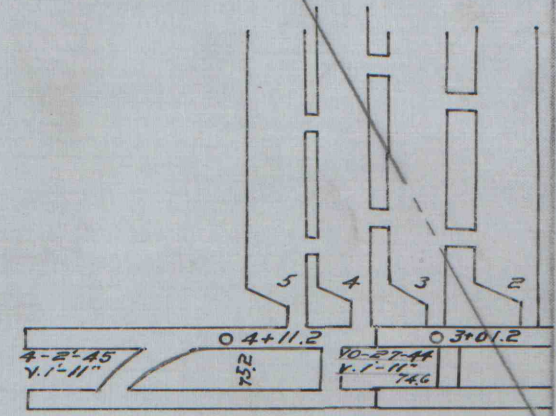

6m 1/2
1/635



0.11/2
0.06/2