



GENERAL NOTES:

CLERK - SUPT - MAIN T

STAY UNDER EXISTING DUCTS
WITH 2" X 4" ZELLING APPROX. 11' 6" HT.
REUSE LIGHTING BEHIND ACRYLIC PANELS
PARTITIONS 8' 0" HIGH - PANEL WALLS

PAINT ALL OVER INSIDE MASONRY WALLS
WITH EPONY PAINT

EXISTING COVERED WALK

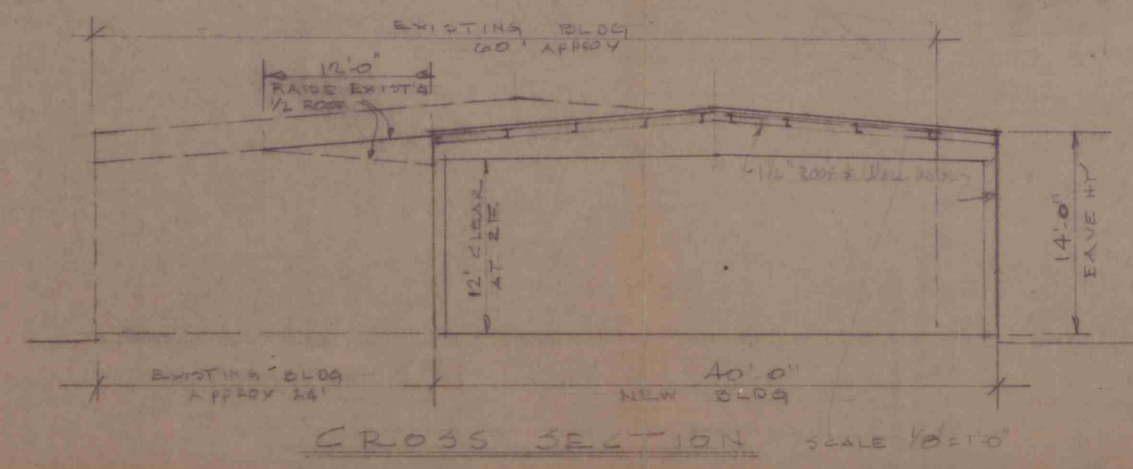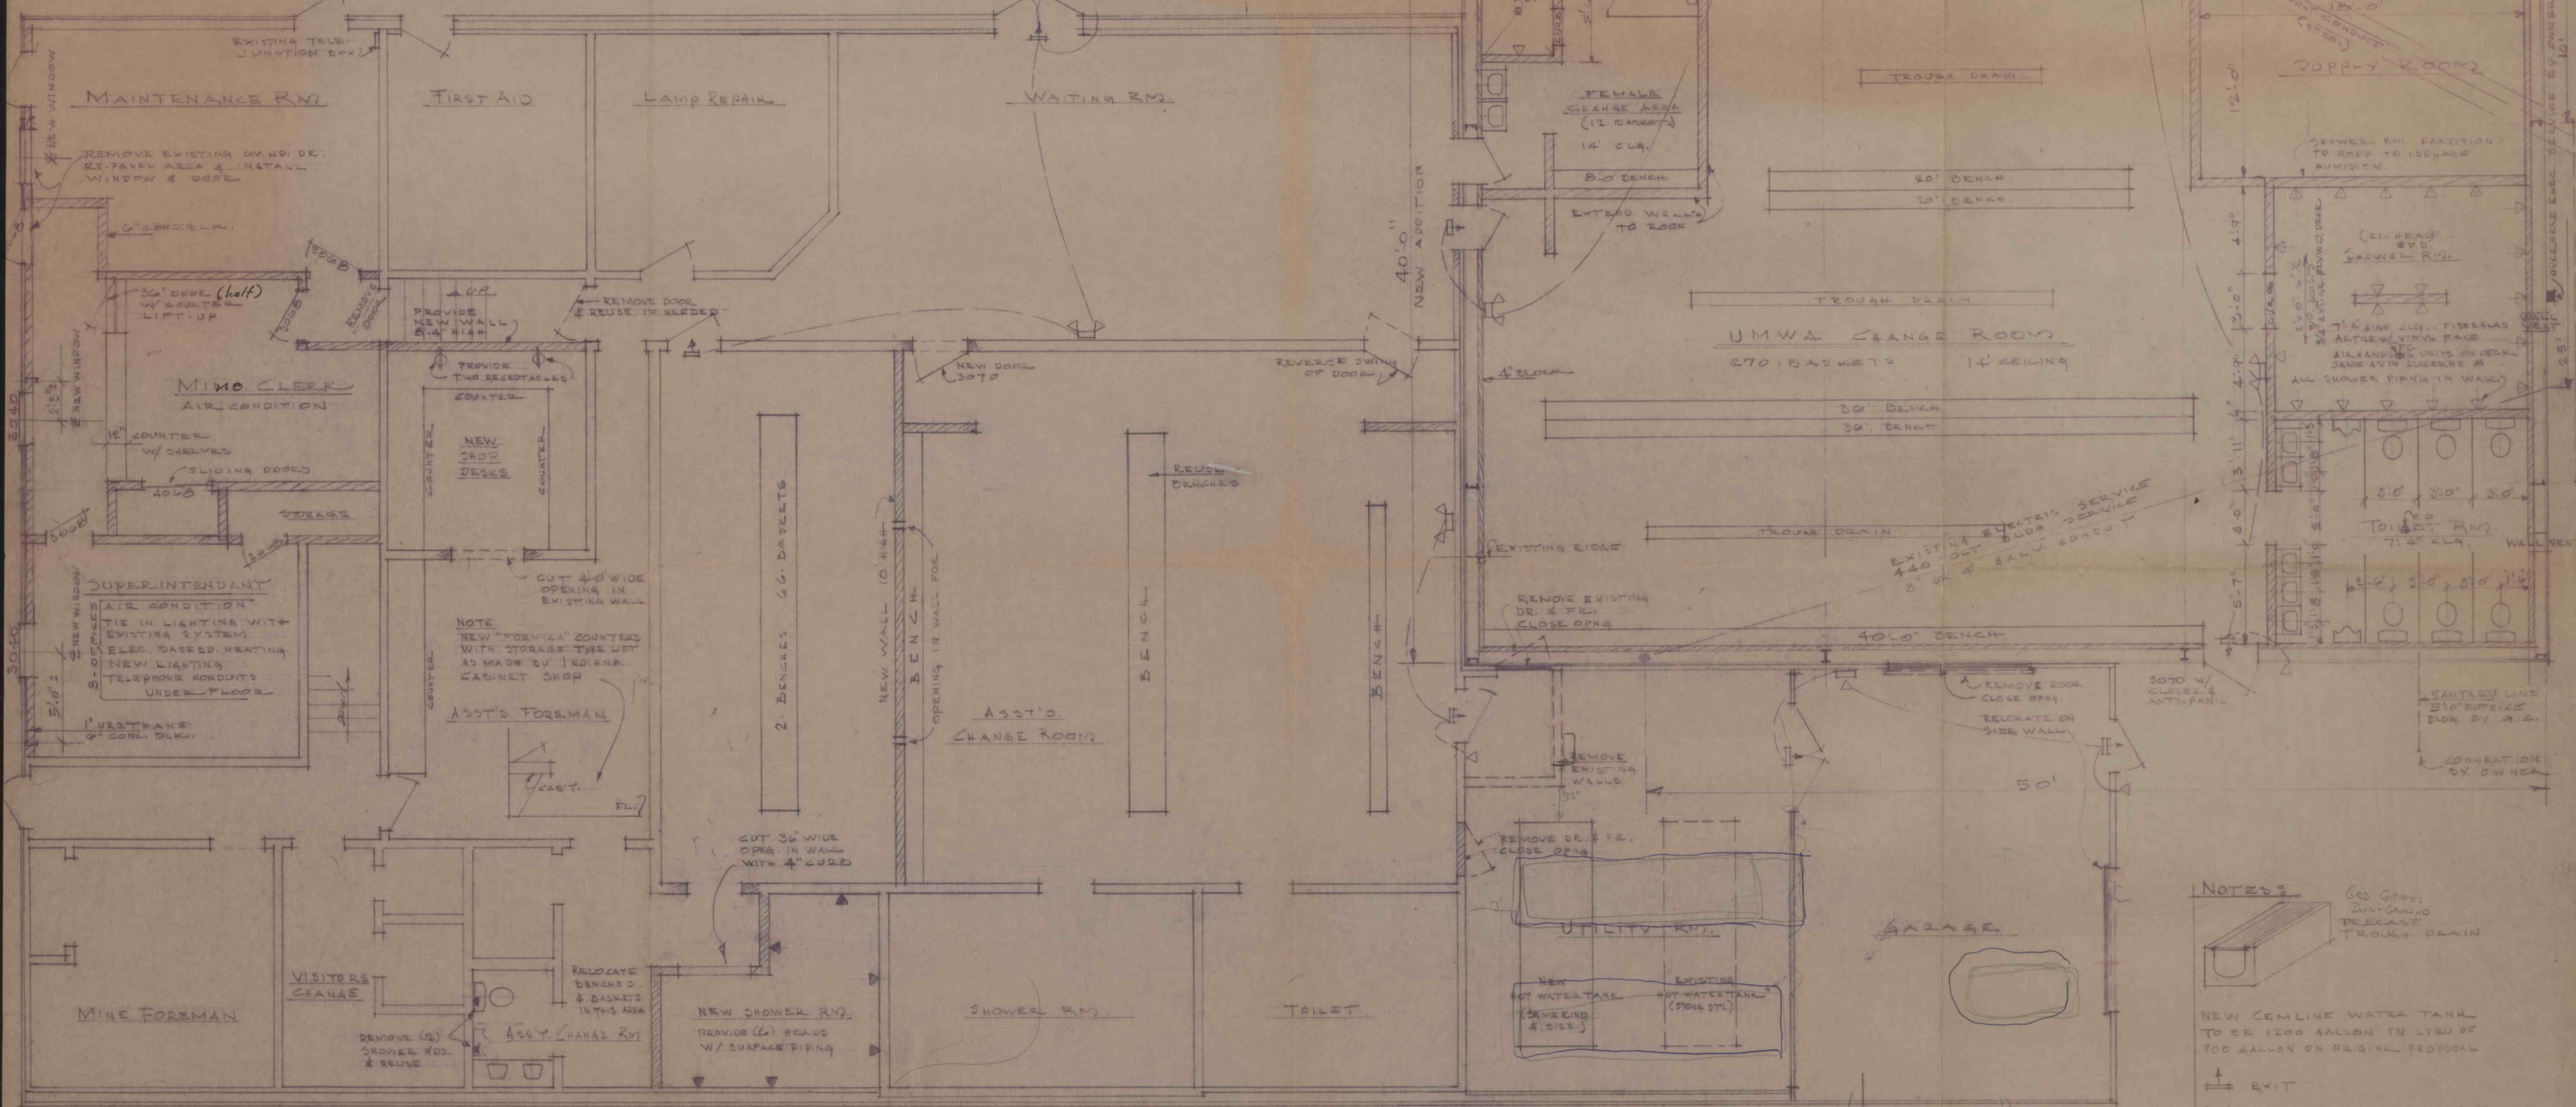

FLOOR PLAN

SCALE 1/4" = 1'-0"

FUTURE PARKING AREA

IMAPS#
15139

NOTES:

- RED GRADE: DIRT GRADE PRECAST TROUGH DRAIN
- NEW CEMLINE WATER TANK TO BE 1200 GALLON IN LIEU OF 700 GALLON ON ORIGINAL PROPOSAL
- EXIT
- EMERGENCY BATTERY UNIT
- EMERGENCY ROAD

RENOVATIONS &
40' x 60' ADDITION
R & P COAL

HELVETIA COAL COMPANY DIVISION

LEBOR COAL CO. JOHNSTOWN, PA.
JUNE 4, 1979

REVISED AUGUST 21, 1979