
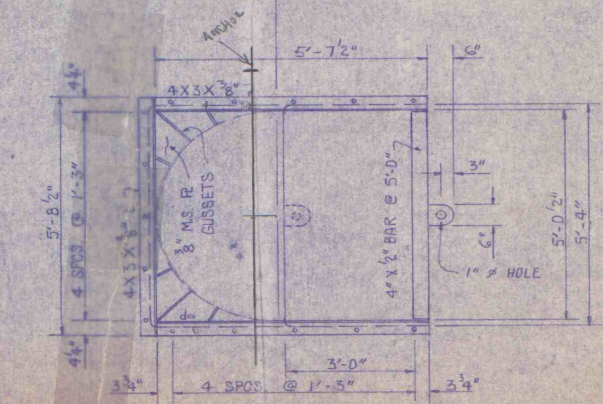


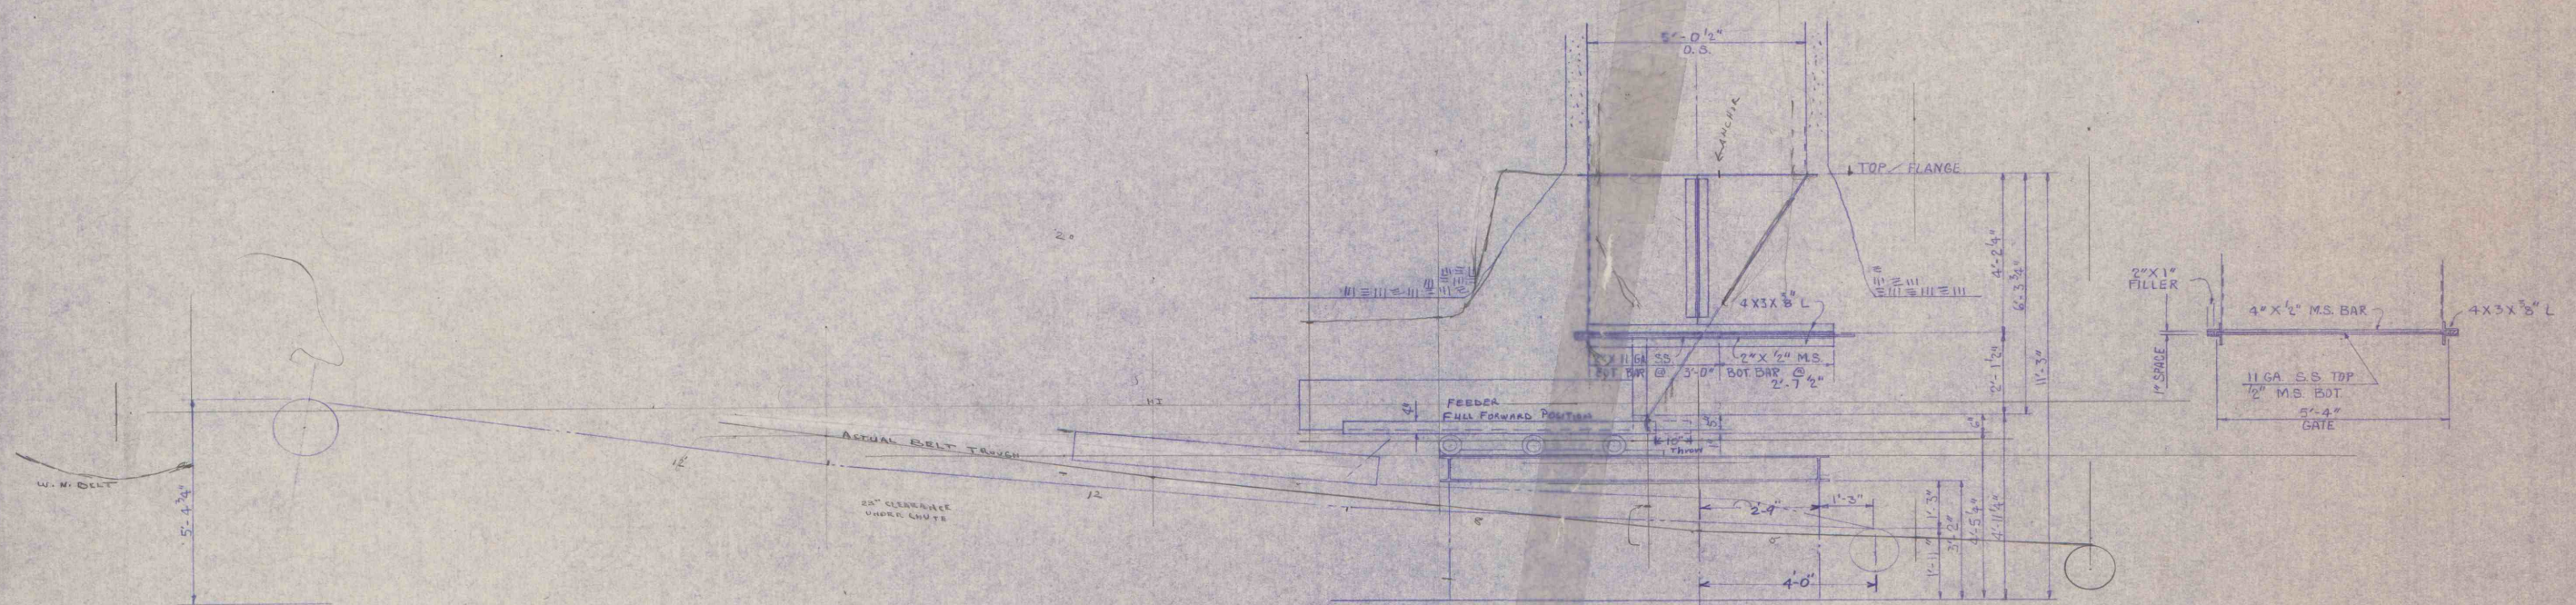

INDIANA STEEL & FABRICATING CO., INC.			
INDIANA		CLEARFIELD	BIGLER, PA.
REVISION OF CHUTE FOR CLEARANCE			
R. & P. COAL CO.			
REVISED	4	DRAWN BY	WTF
1	1	CHECKED BY	
2	2	REF. No.	
3	3	DATE	6-17-77
4	4	SCALE	1/2" = 1'-0"
		DWG. No.	77089-P2

IMAPS# 15145