
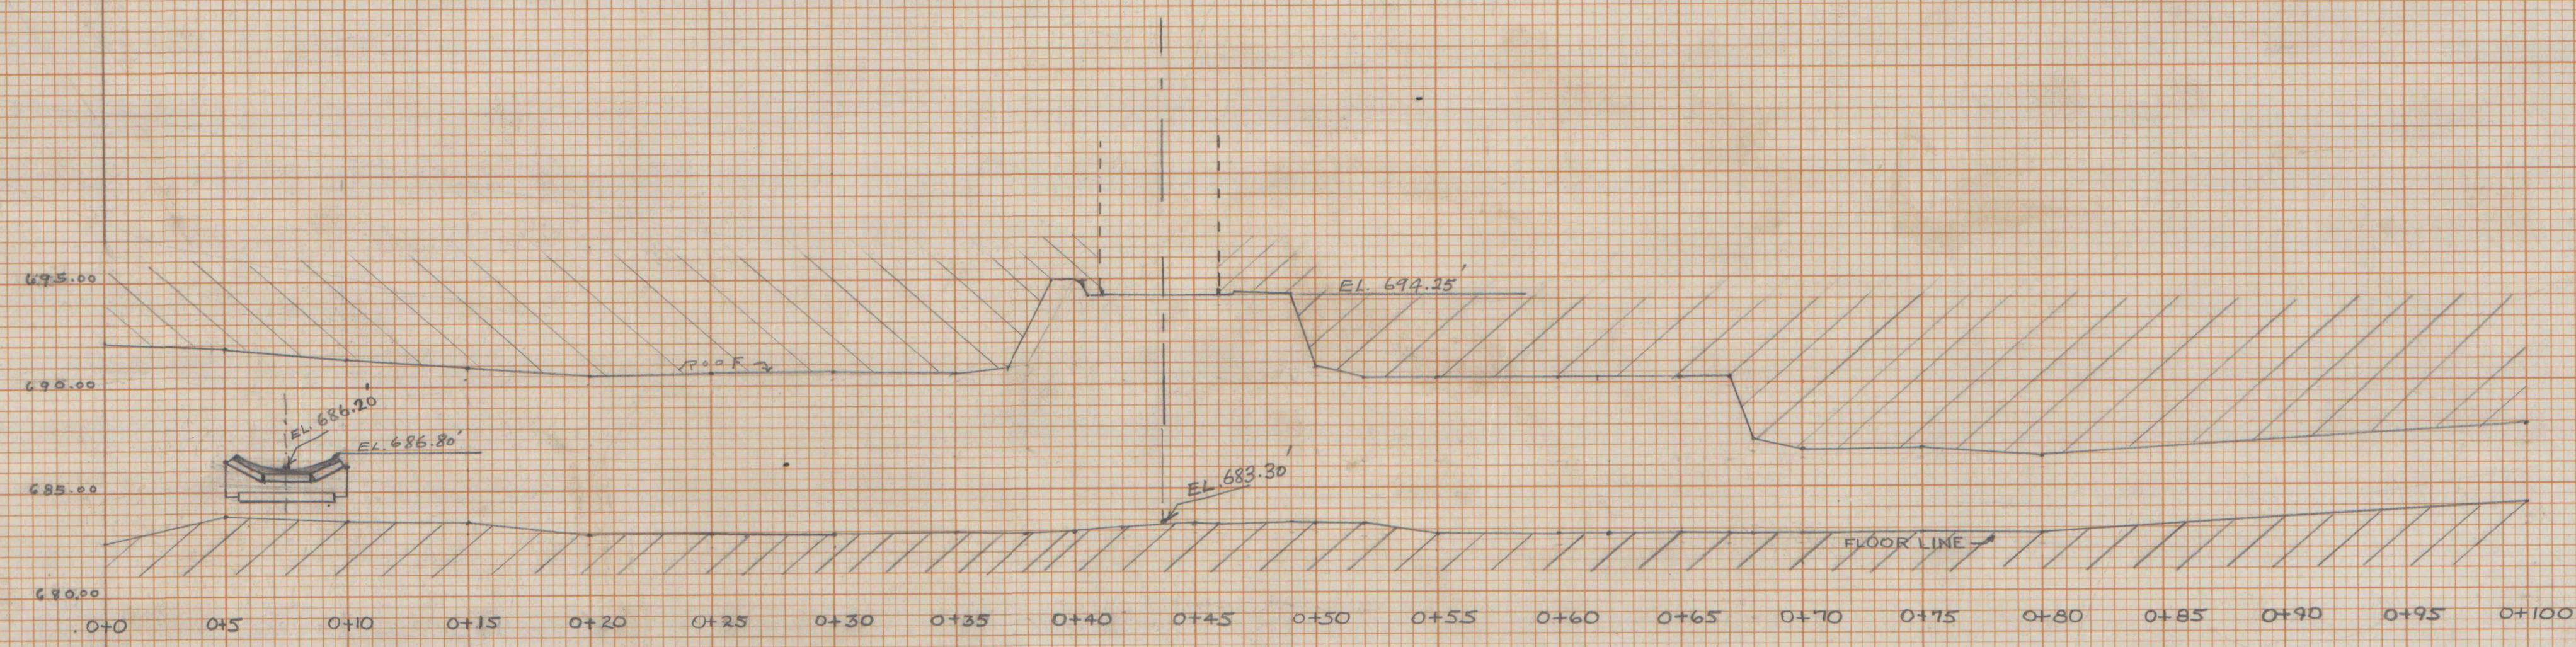


3034
7.17
43.53

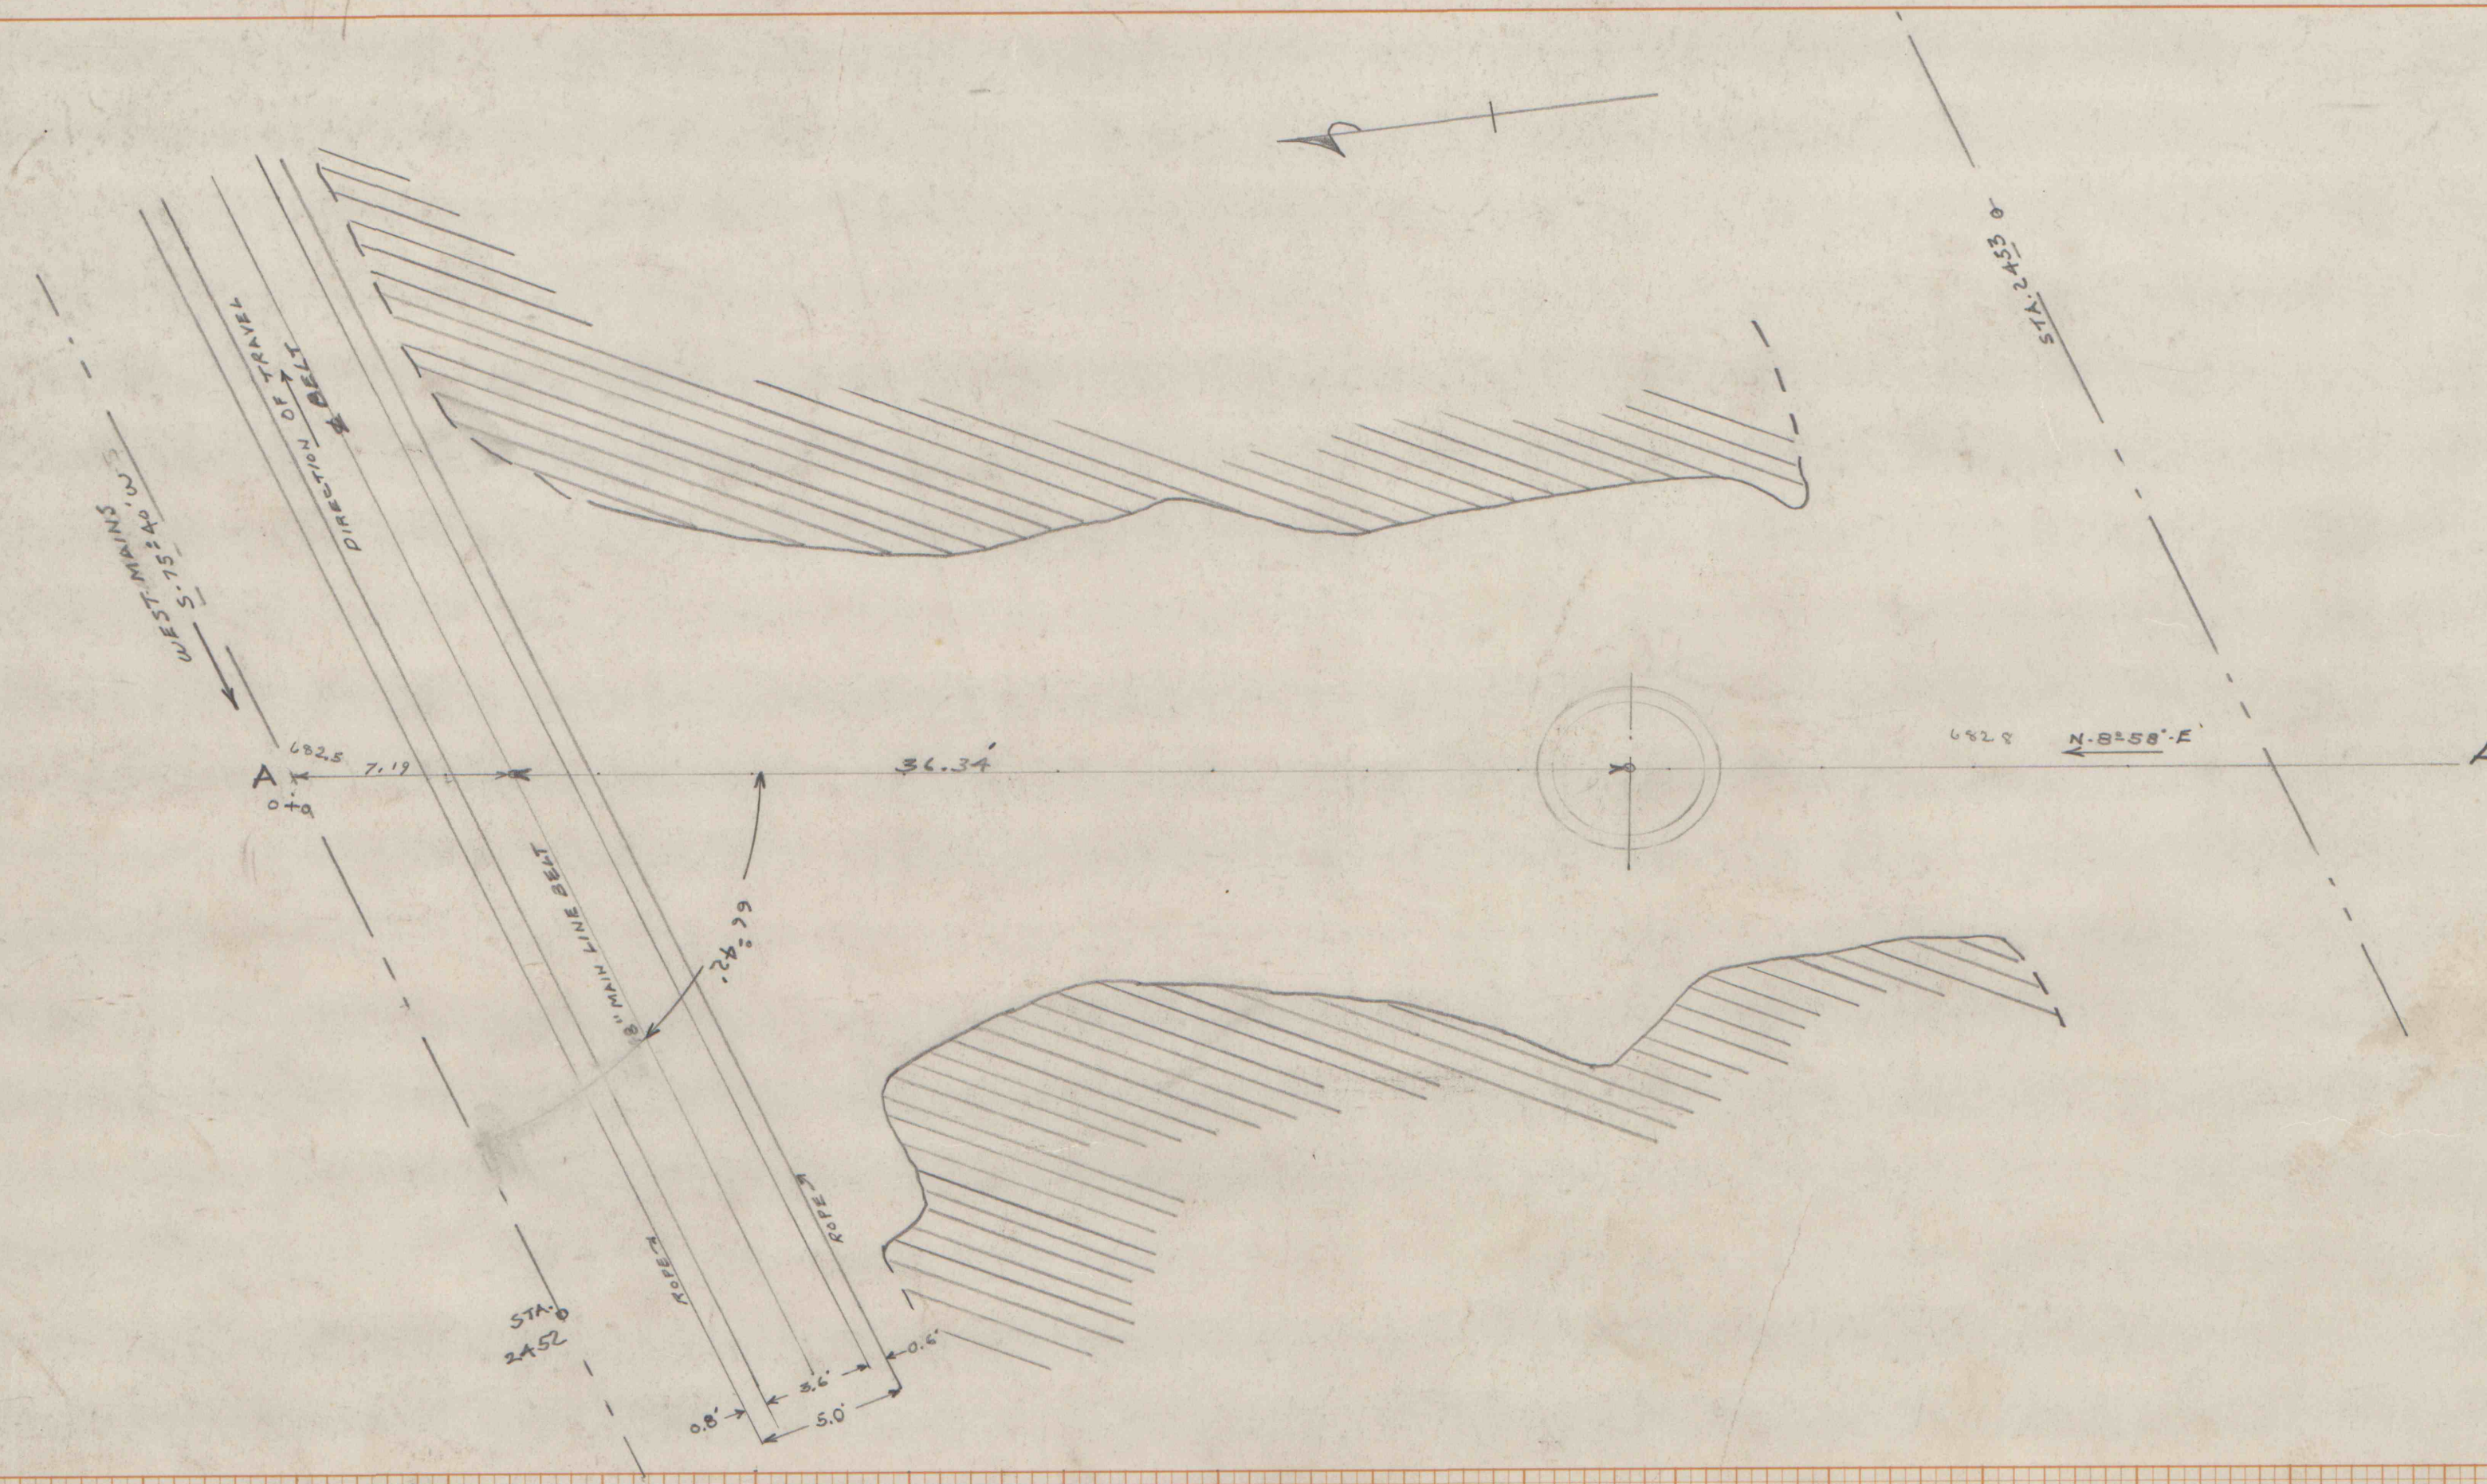

CROSS SECTION A-A

7-15-77
BY LESTER CLARK

NO.	3034	DATE	7-15-77	BY	CLARK
WOLE BOOK	20146A	DATE	7-15-77	BY	CLARK

