




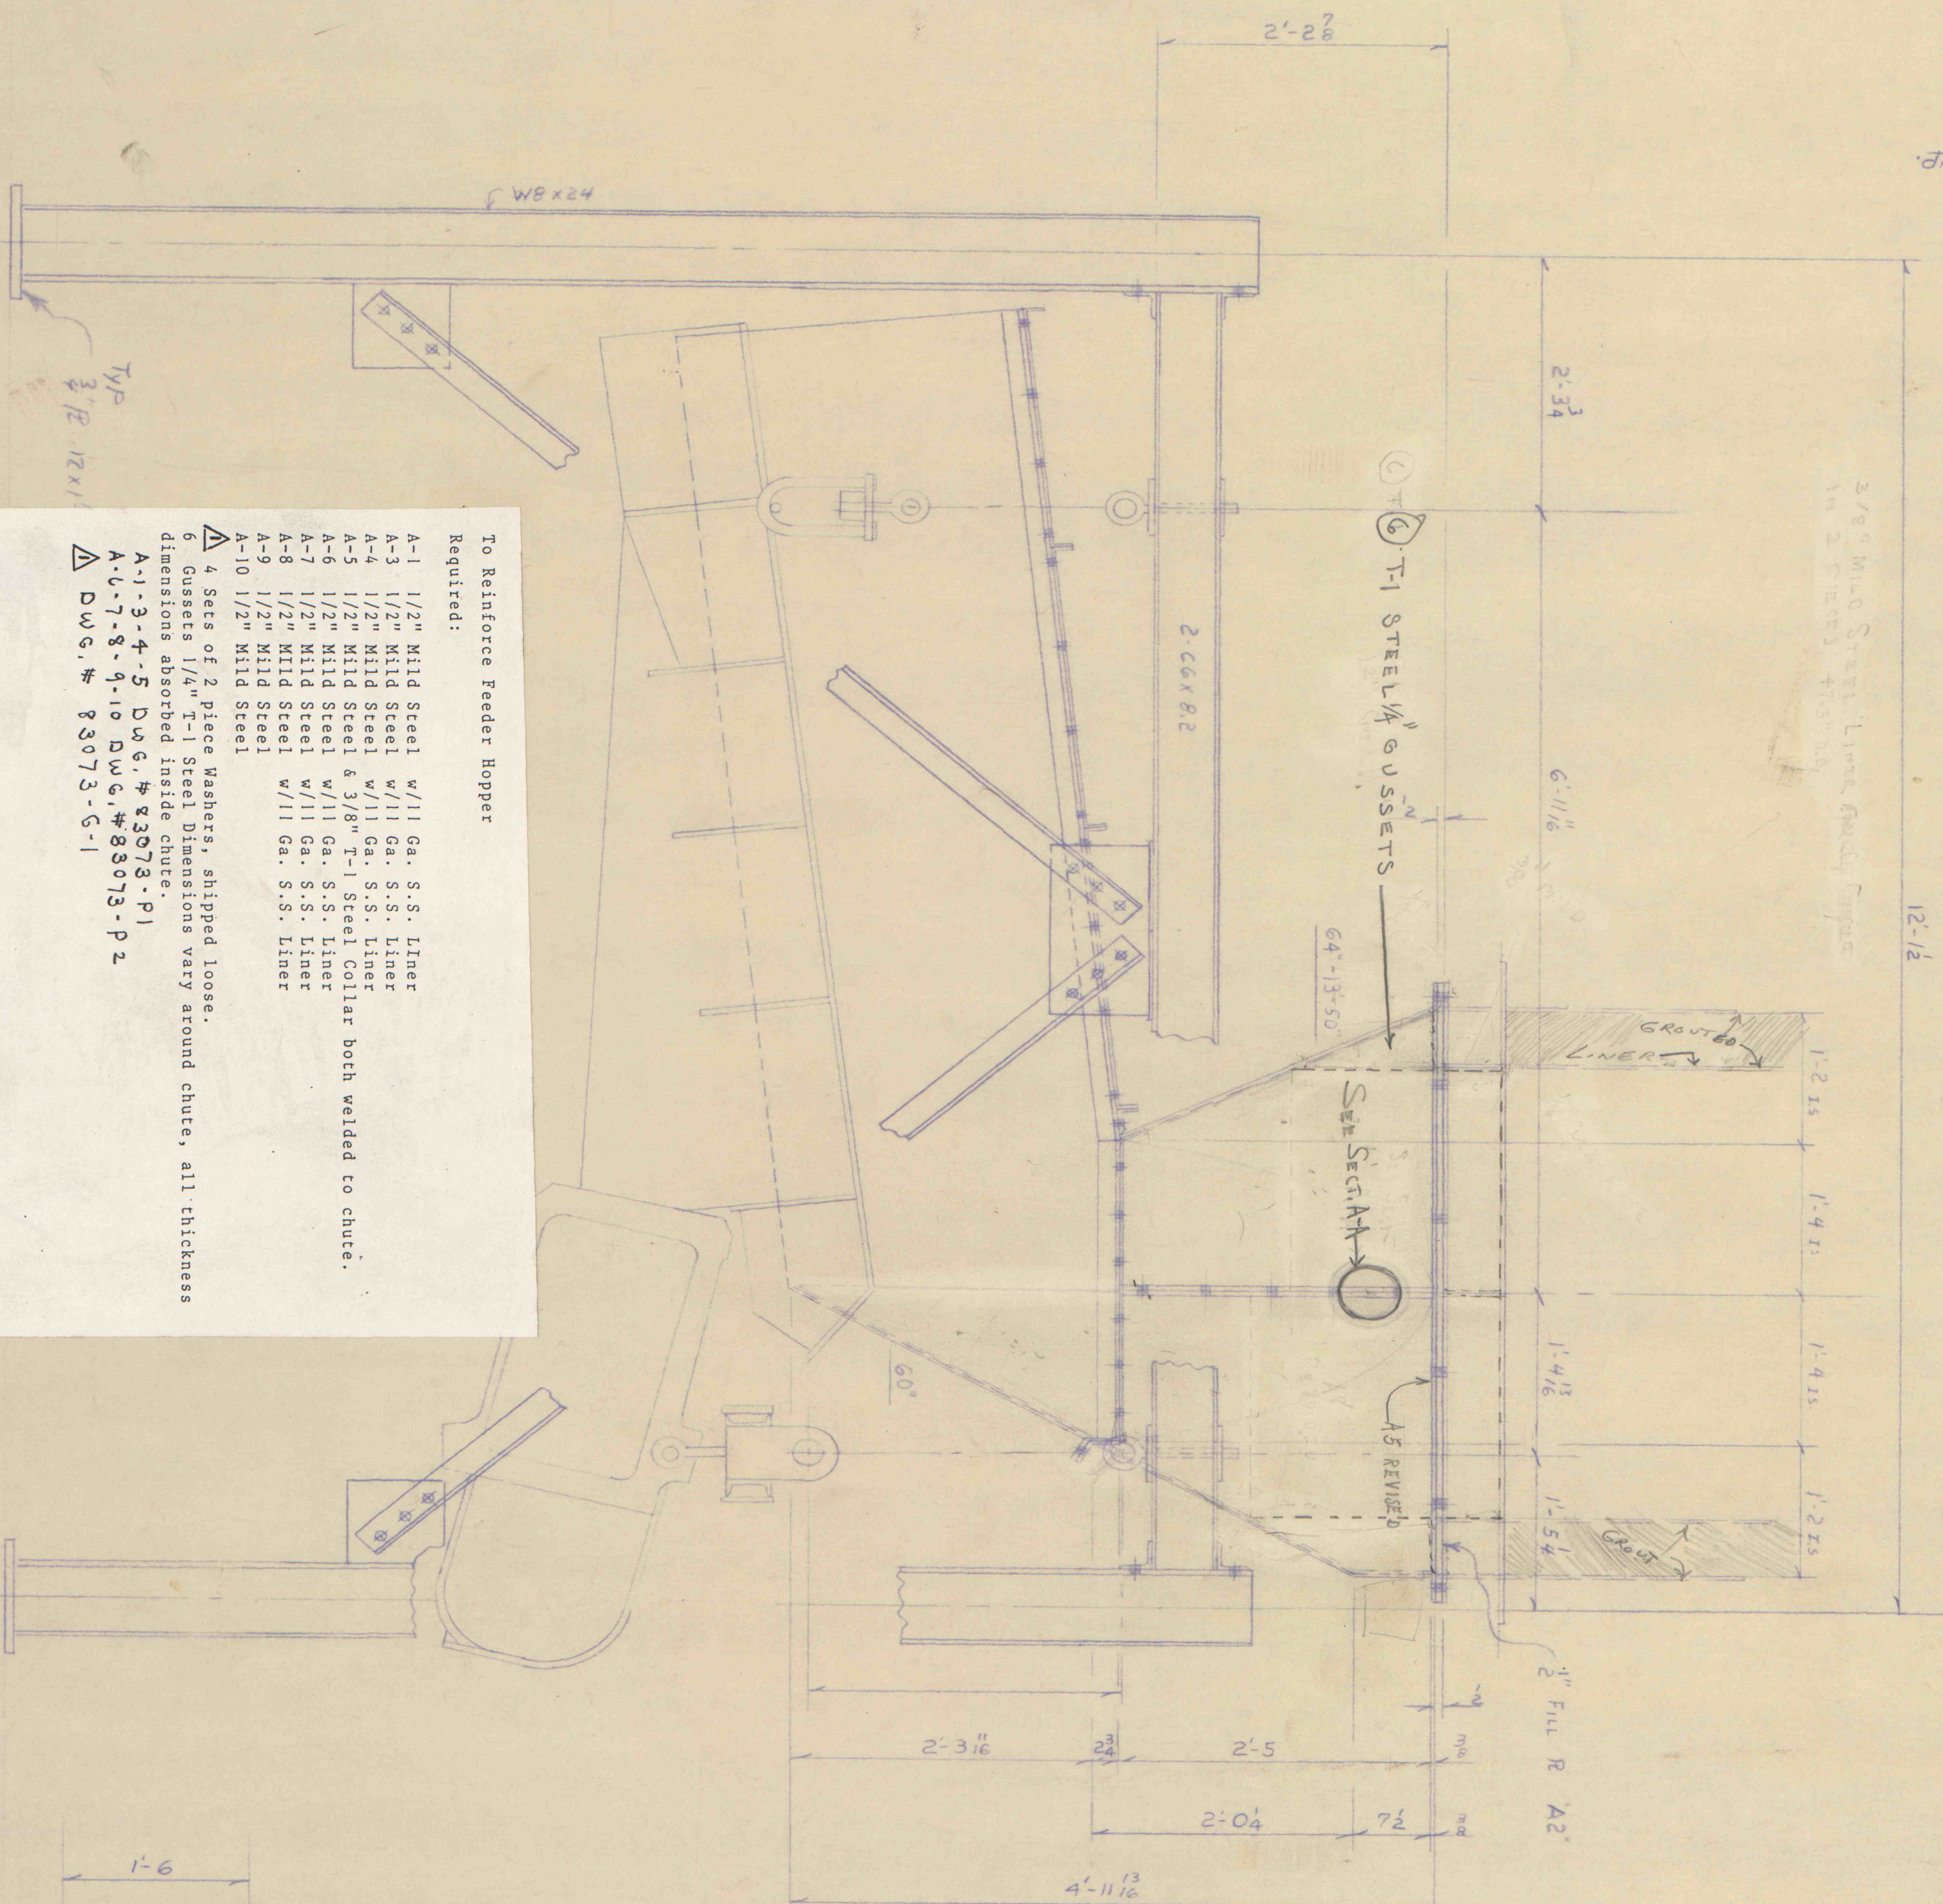


**Required:**

- 4 Sets of 2 piece Washers, shipped loose.  
6 Gussets 1/4" T-1 Steel Dimensions vary around chute, all thickness dimensions absorbed inside chute.



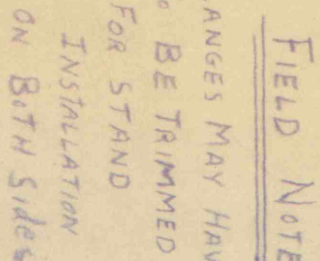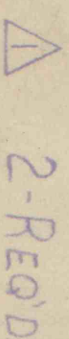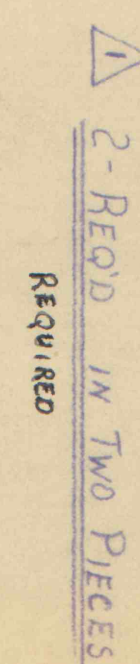

|         |   |  |  |  |  |  |  |
|---------|---|--|--|--|--|--|--|
| REVISED | 4 |  |  |  |  |  |  |
| 3       |   |  |  |  |  |  |  |
| 2       |   |  |  |  |  |  |  |
| 1       |   |  |  |  |  |  |  |

ORDER # 6  
 FEEDER HOPPER, SKIRTS & STAND GA  
 HELVETIA COAL CO.  
 # 2 PORTLAND  
 DRAIN BY 100 M  
 CHECKED BY  
 SET NO.  
 DATE 6-15-53  
 SCALE 1" = 10'  
 DWG NO. 83073-G1

INDIANA STEEL & FABRICATING CO., INC.  
 INDIANA - CLEARFIELD - BIGLER, PA.