


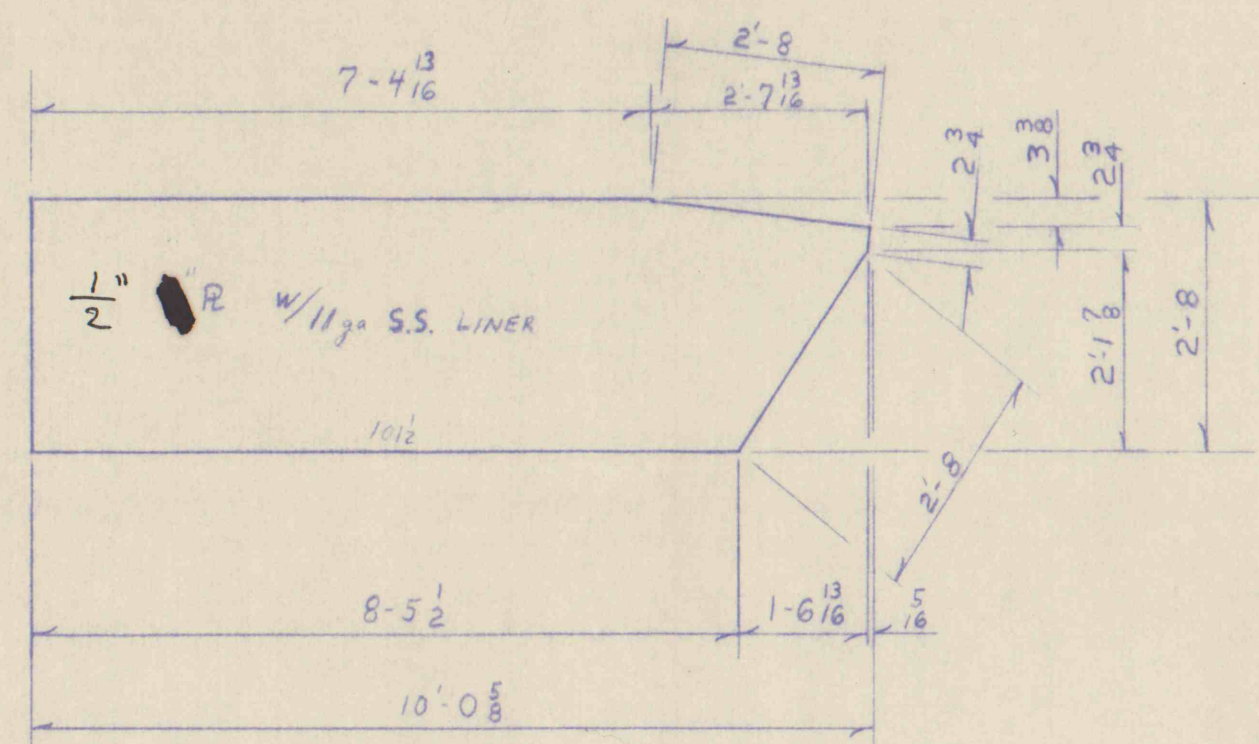


PLATE "A1" REQUIRED
2-REQ'D. EACH W/ 11GA SS. LINER

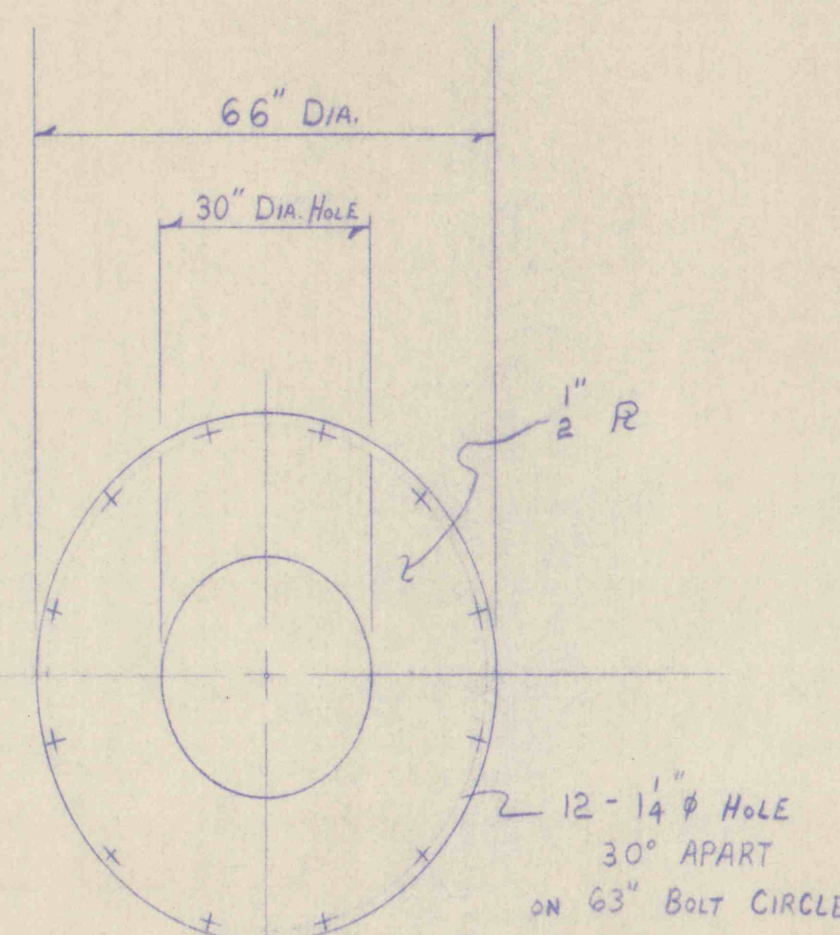

Fill PLATE "A2" NOT REQUIRED
1-REQ'D




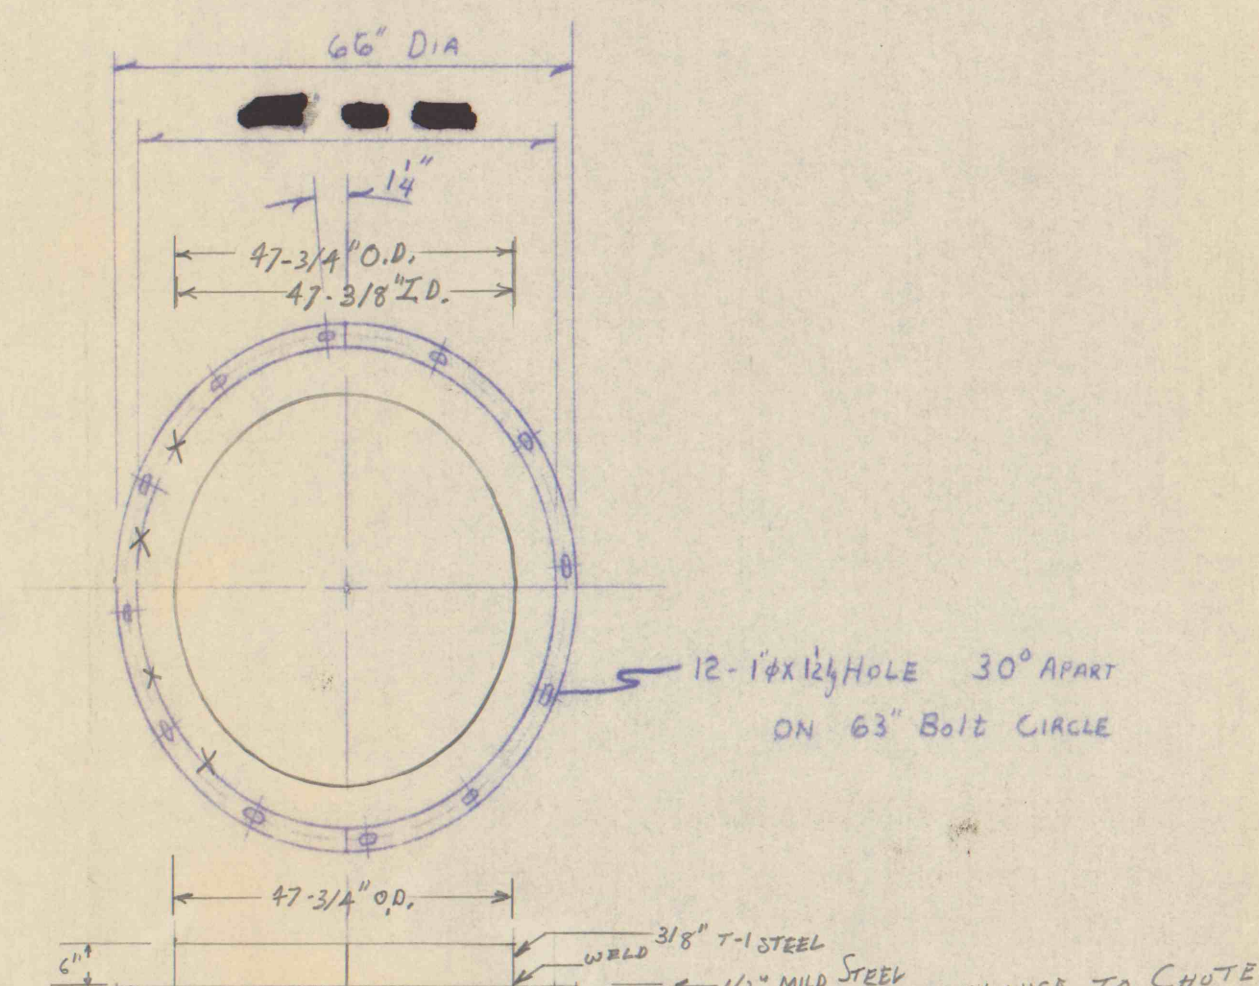



PLATE FLANGE "A5" REVISED
1-REQ'D IN 2 PCS.
SCALE 1/2" = FOOT

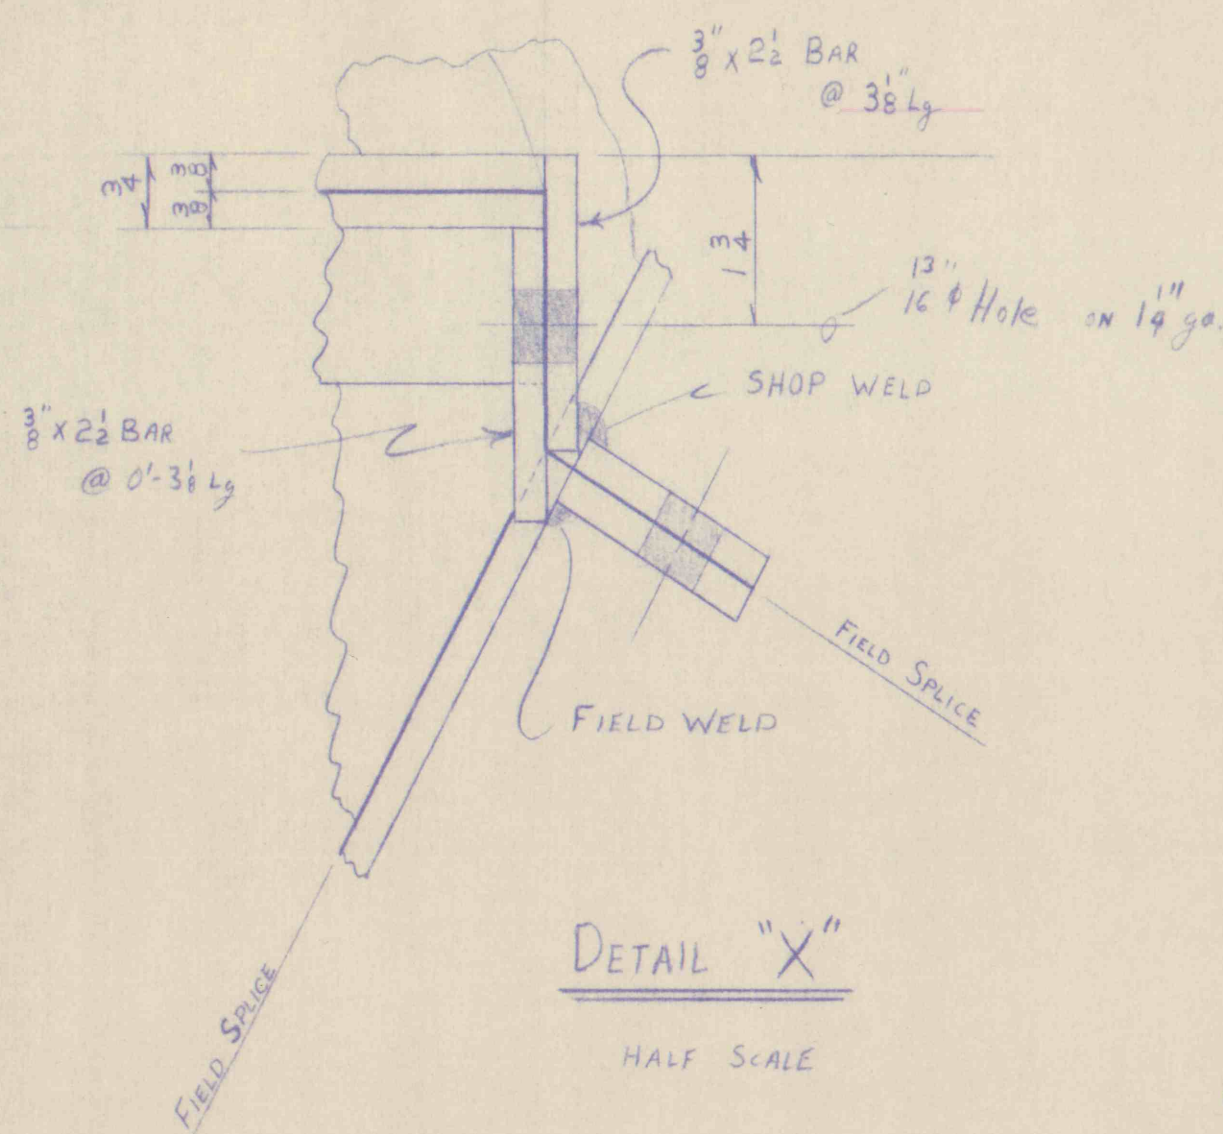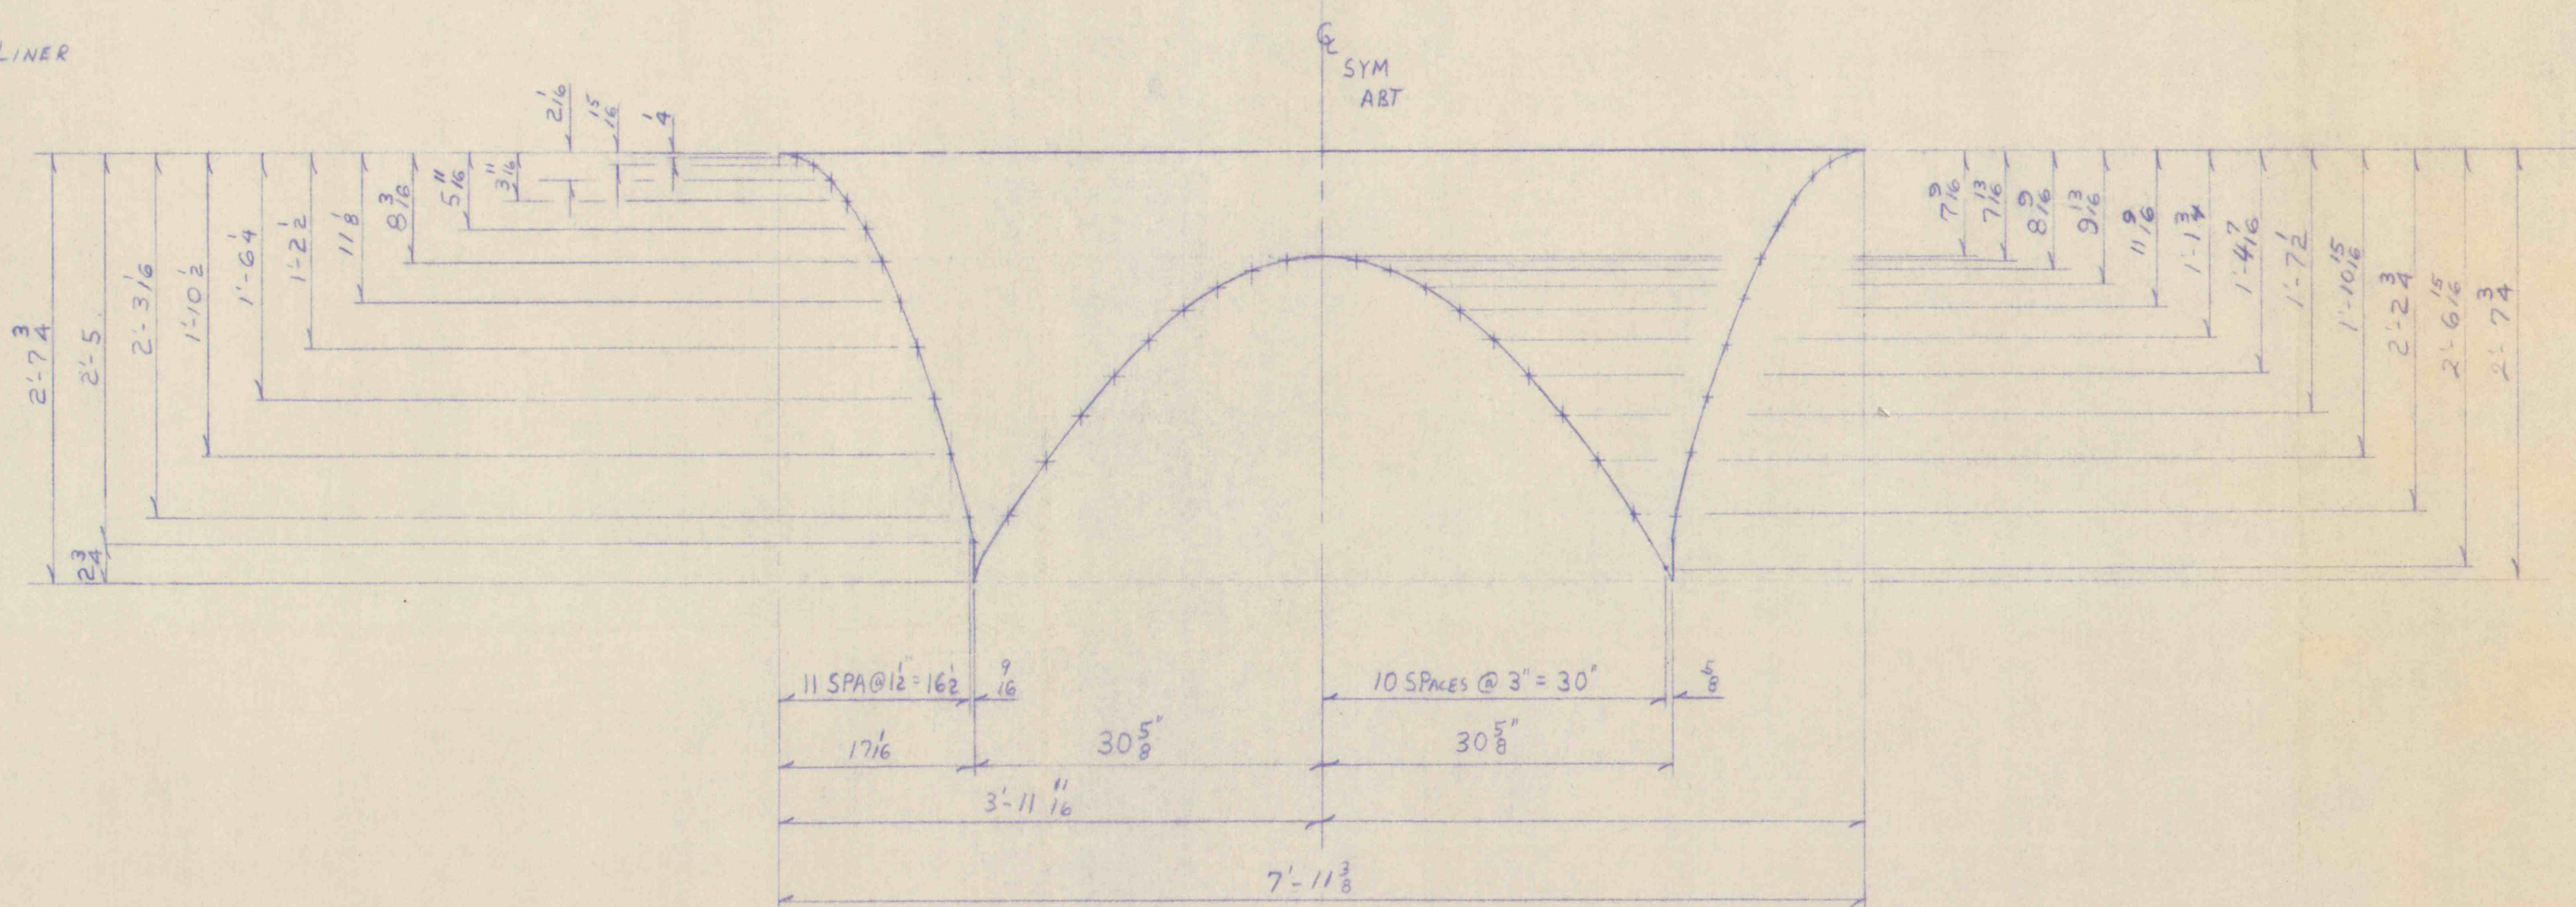

DETAIL "X"
HALF SCALE

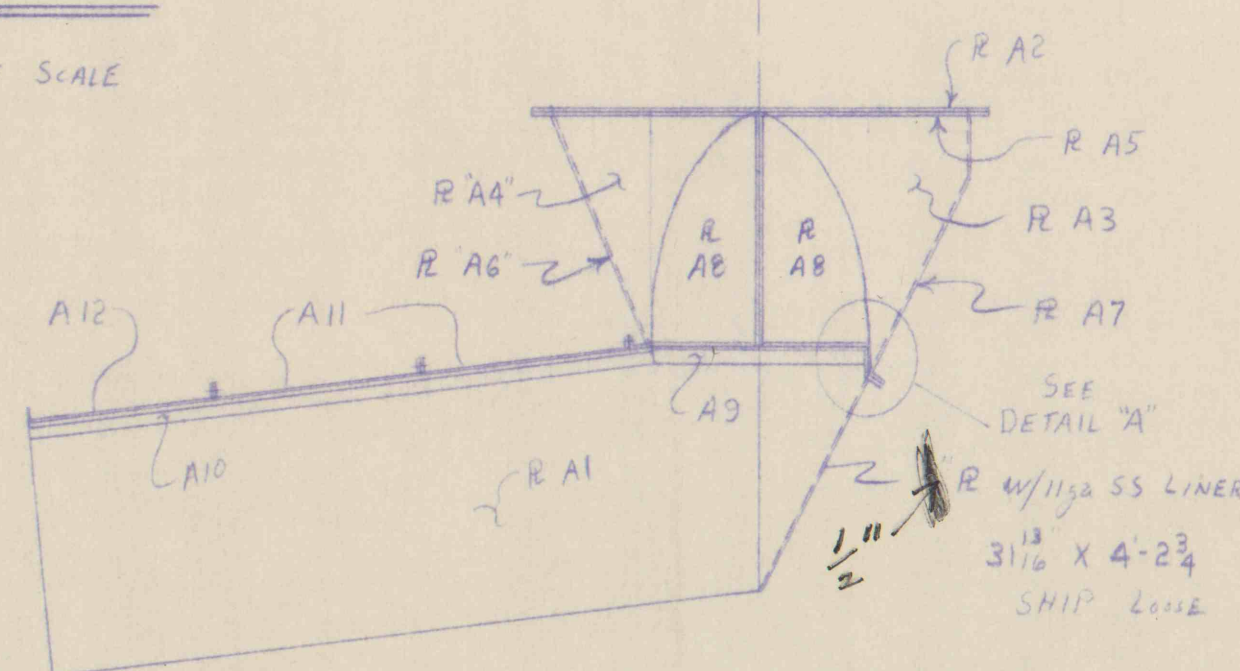

1/2 PL. PLATE "A3" REQUIRED
1-REQ'D W/ 11GA SS LINER
NOTE: DIMENSIONS SHOWN ARE OUTSIDE DIMENSIONS

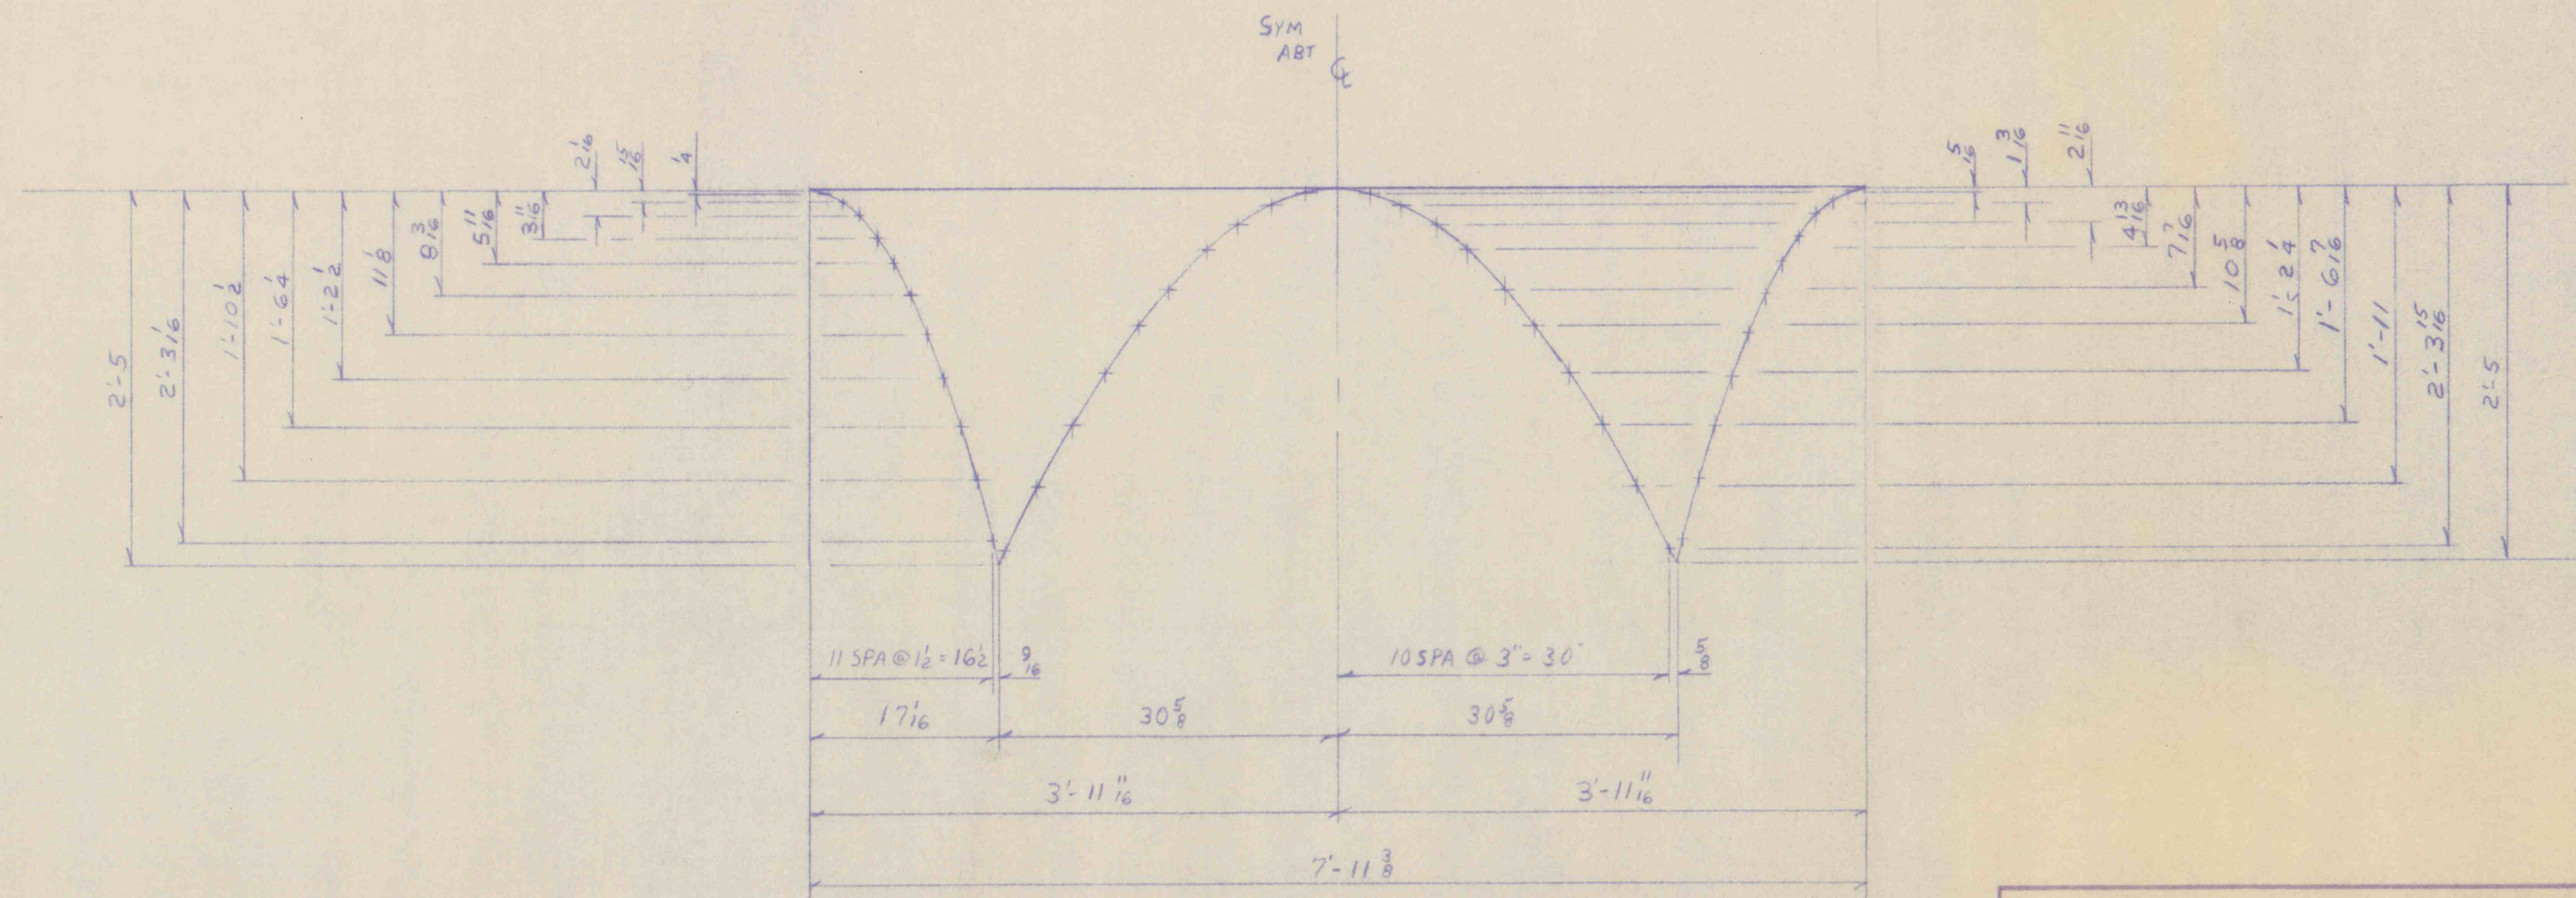

1/2 PL. PLATE "A4" REQUIRED
1-REQ'D W/ 11GA SS LINER
NOTE: DIMENSIONS SHOWN ARE OUTSIDE DIMENSIONS

INDIANA STEEL & FABRICATING CO., INC. INDIANA - CLEARFIELD - BIGLER, PA.	
FEEDER HOPPER & SKIRTS DETAILS HELVETIA COAL CO.	
LUCERNE #6	#2 PORTAL
REVISED	DRAWN BY: <i>DEM</i> DATE: 6-15-83
1	CHECKED BY: SCALE: 1/2" = 1'-0"
	REF. NO. DWG. NO. 83073-P1