


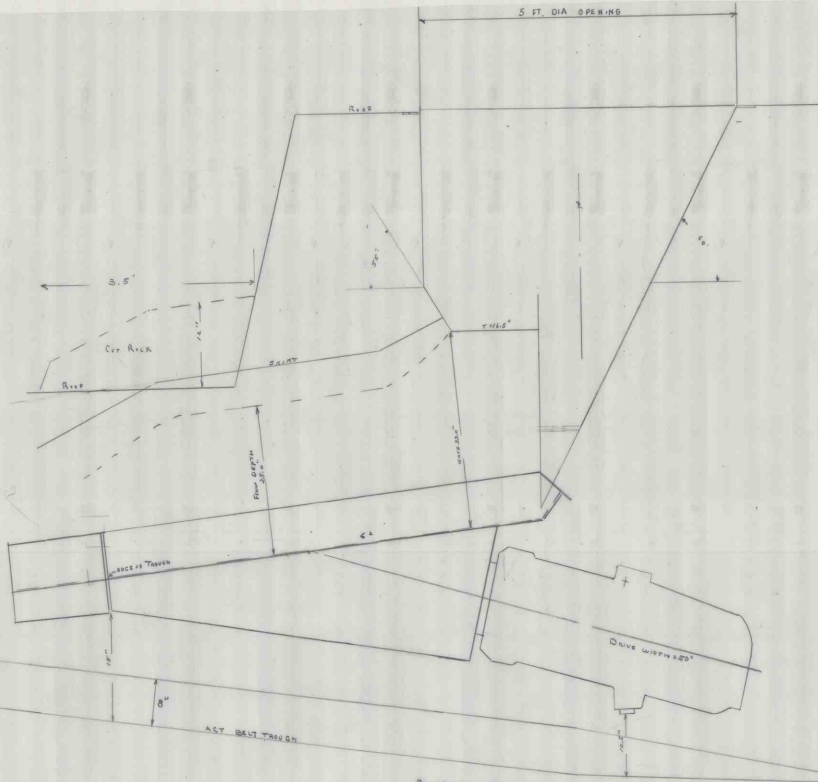

B. ITEM 22. TRANSFER HOLD
CHANGES RE-VAMP (HIVE
CUT RICH

SCALE: 1/8" = 1.0"
F.M.C. ELECTRA MAGNETIC FREEDER
500 T.F.H.
MODEL F660
54" X 84" W/ ADDITIONAL 18" BELT CENTERING
G: DOWN SLIP
WT 8400lb

4-14-53
DRAWN BY L.W.C.

INARS 15160