
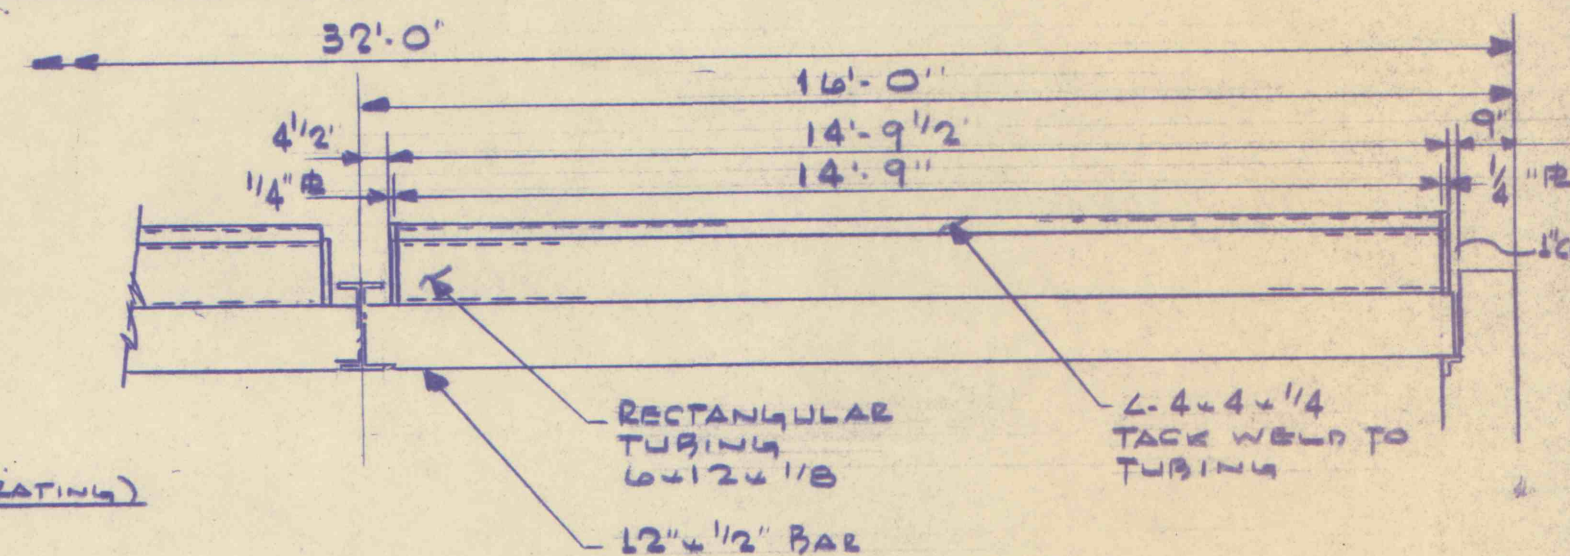
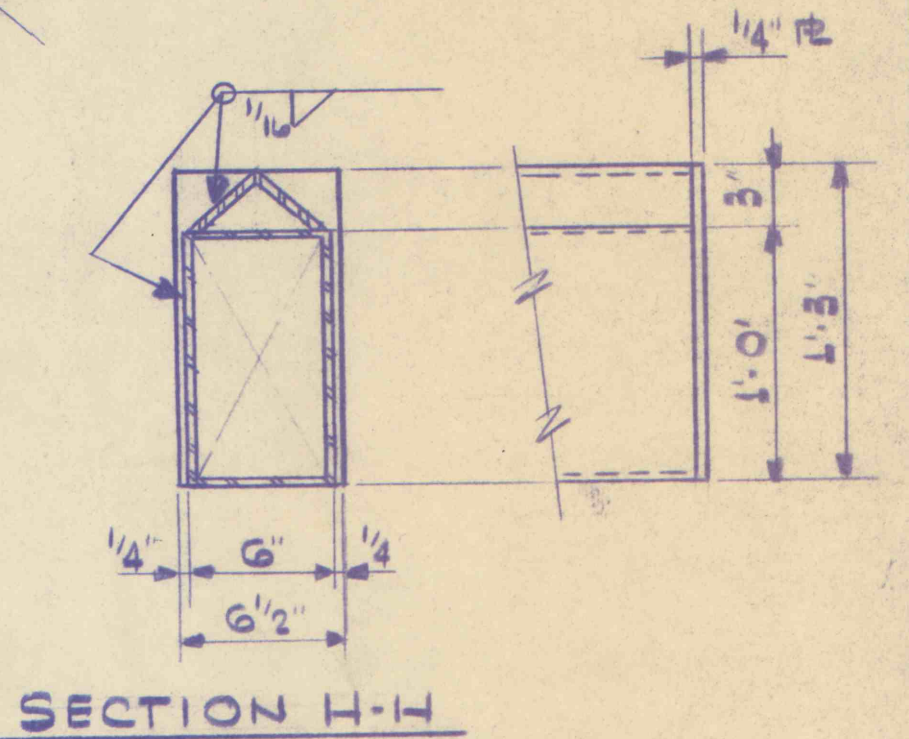
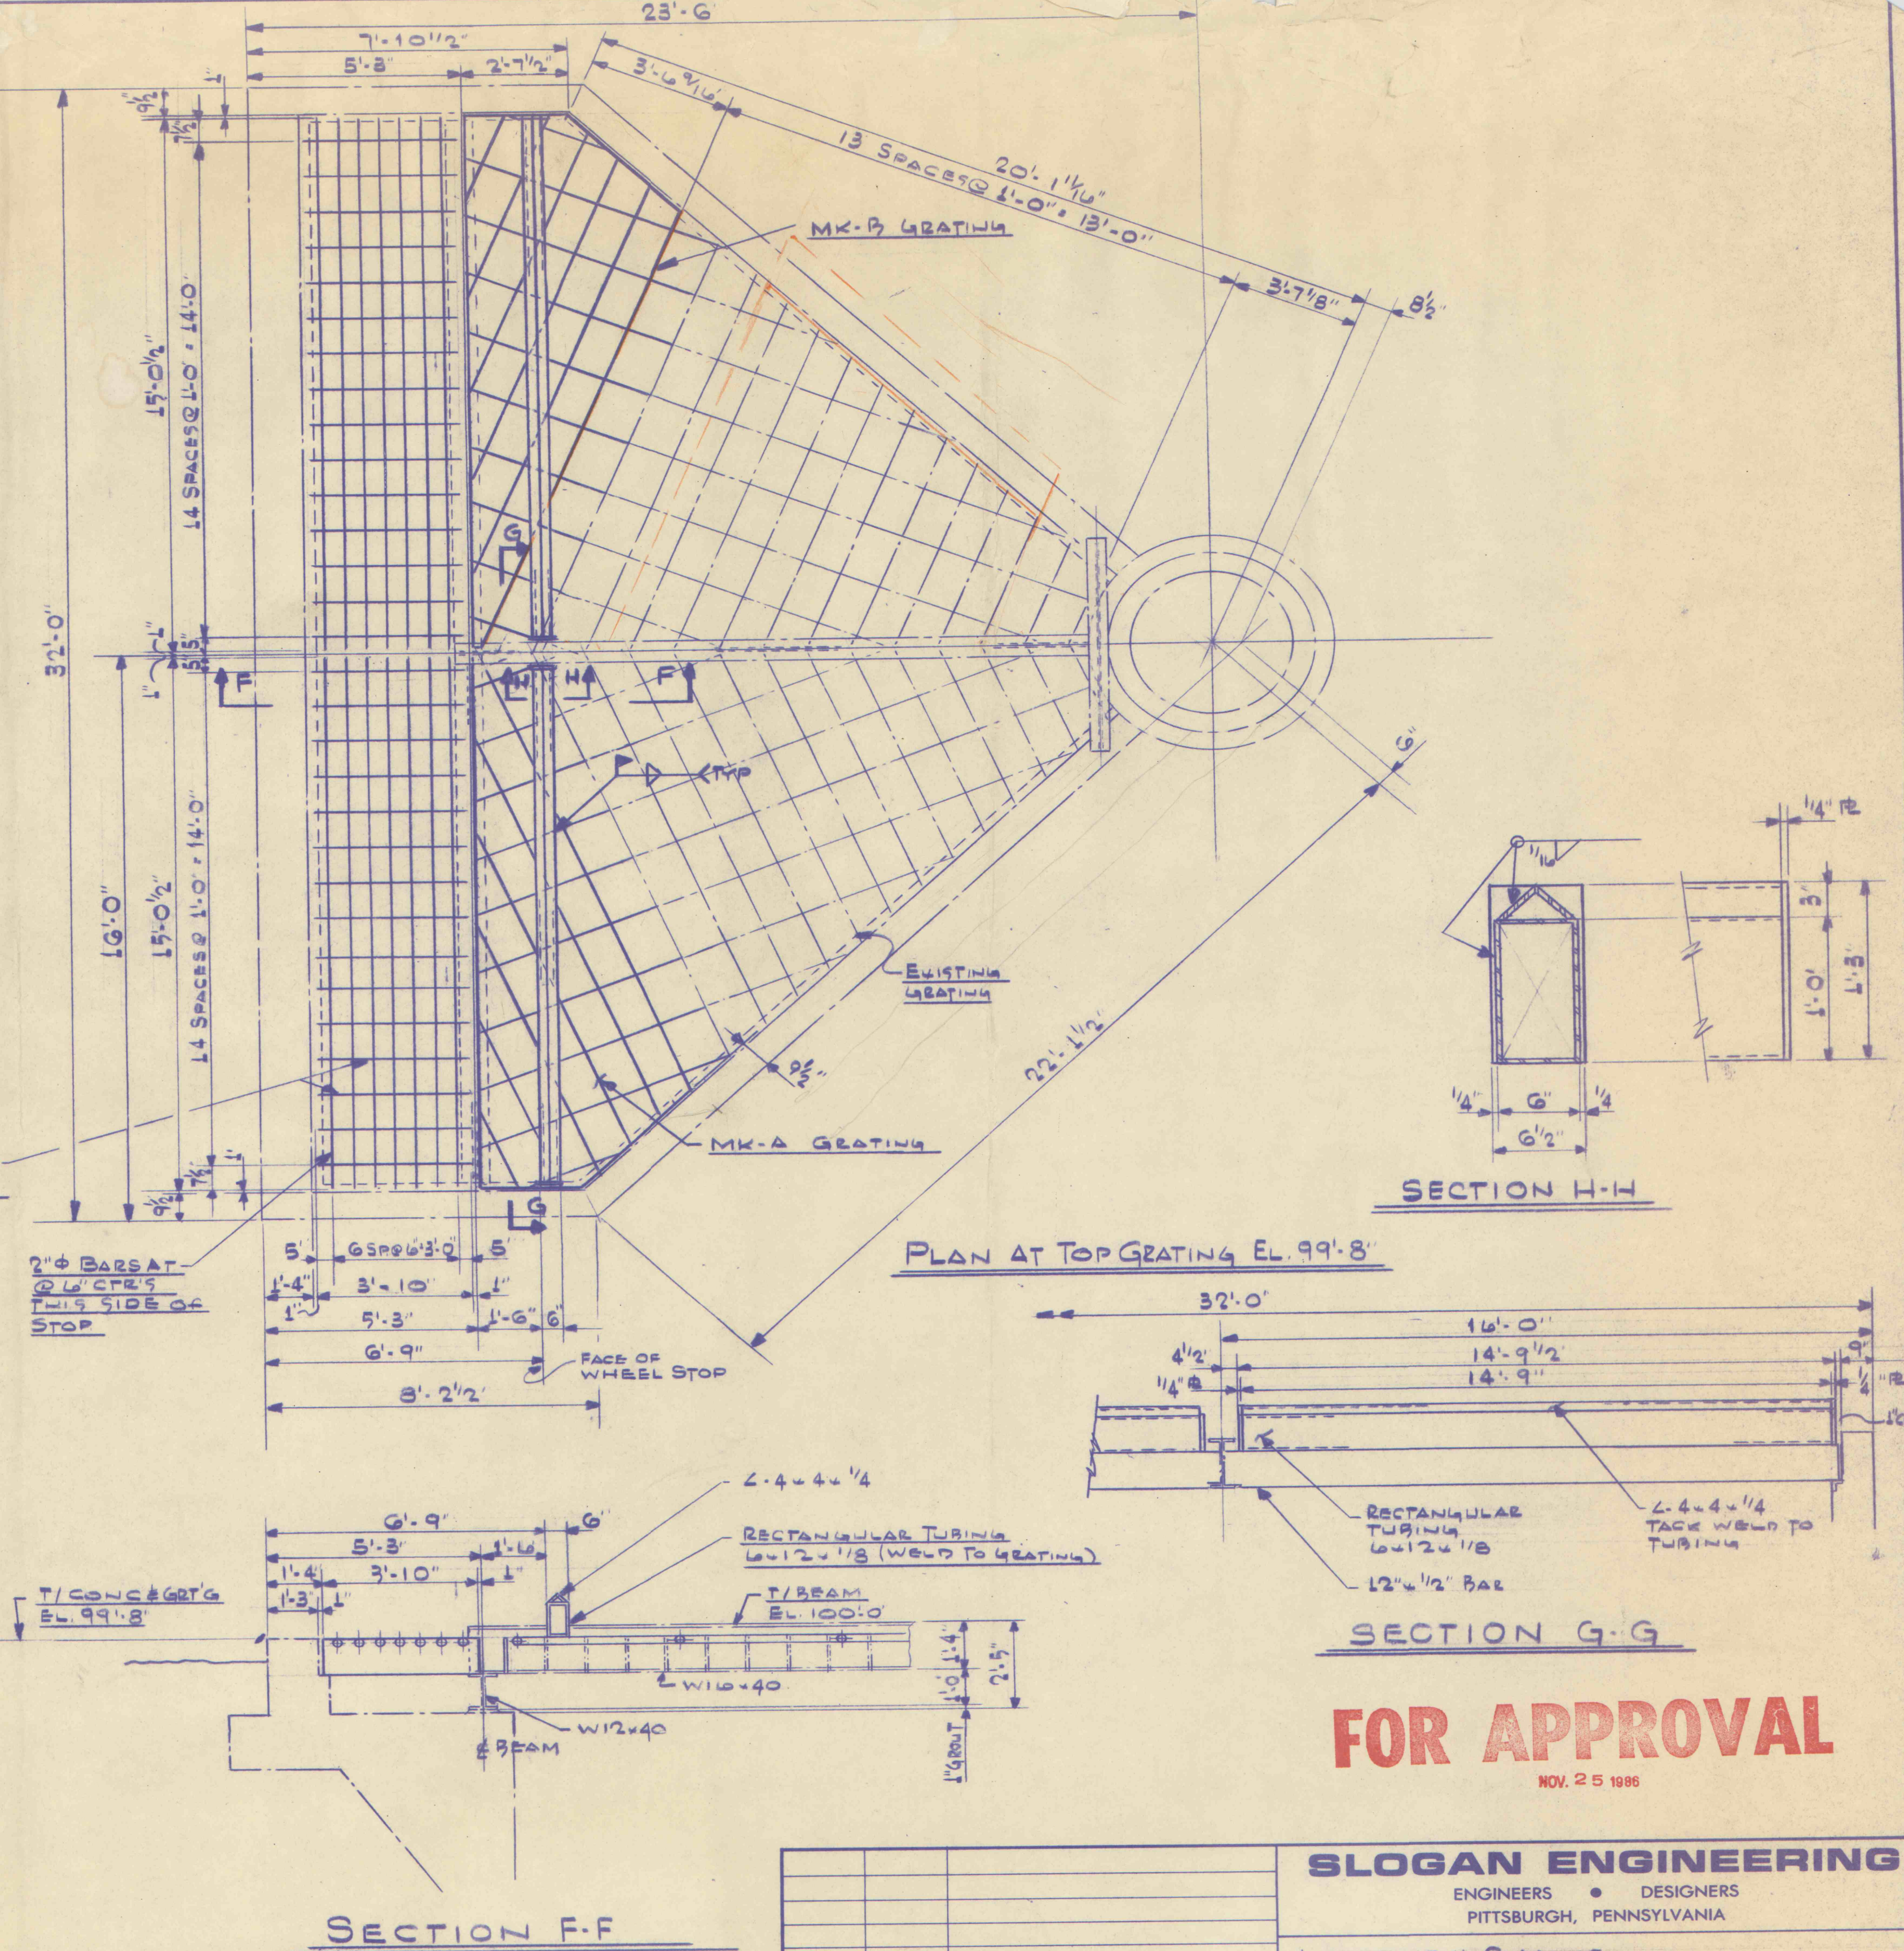
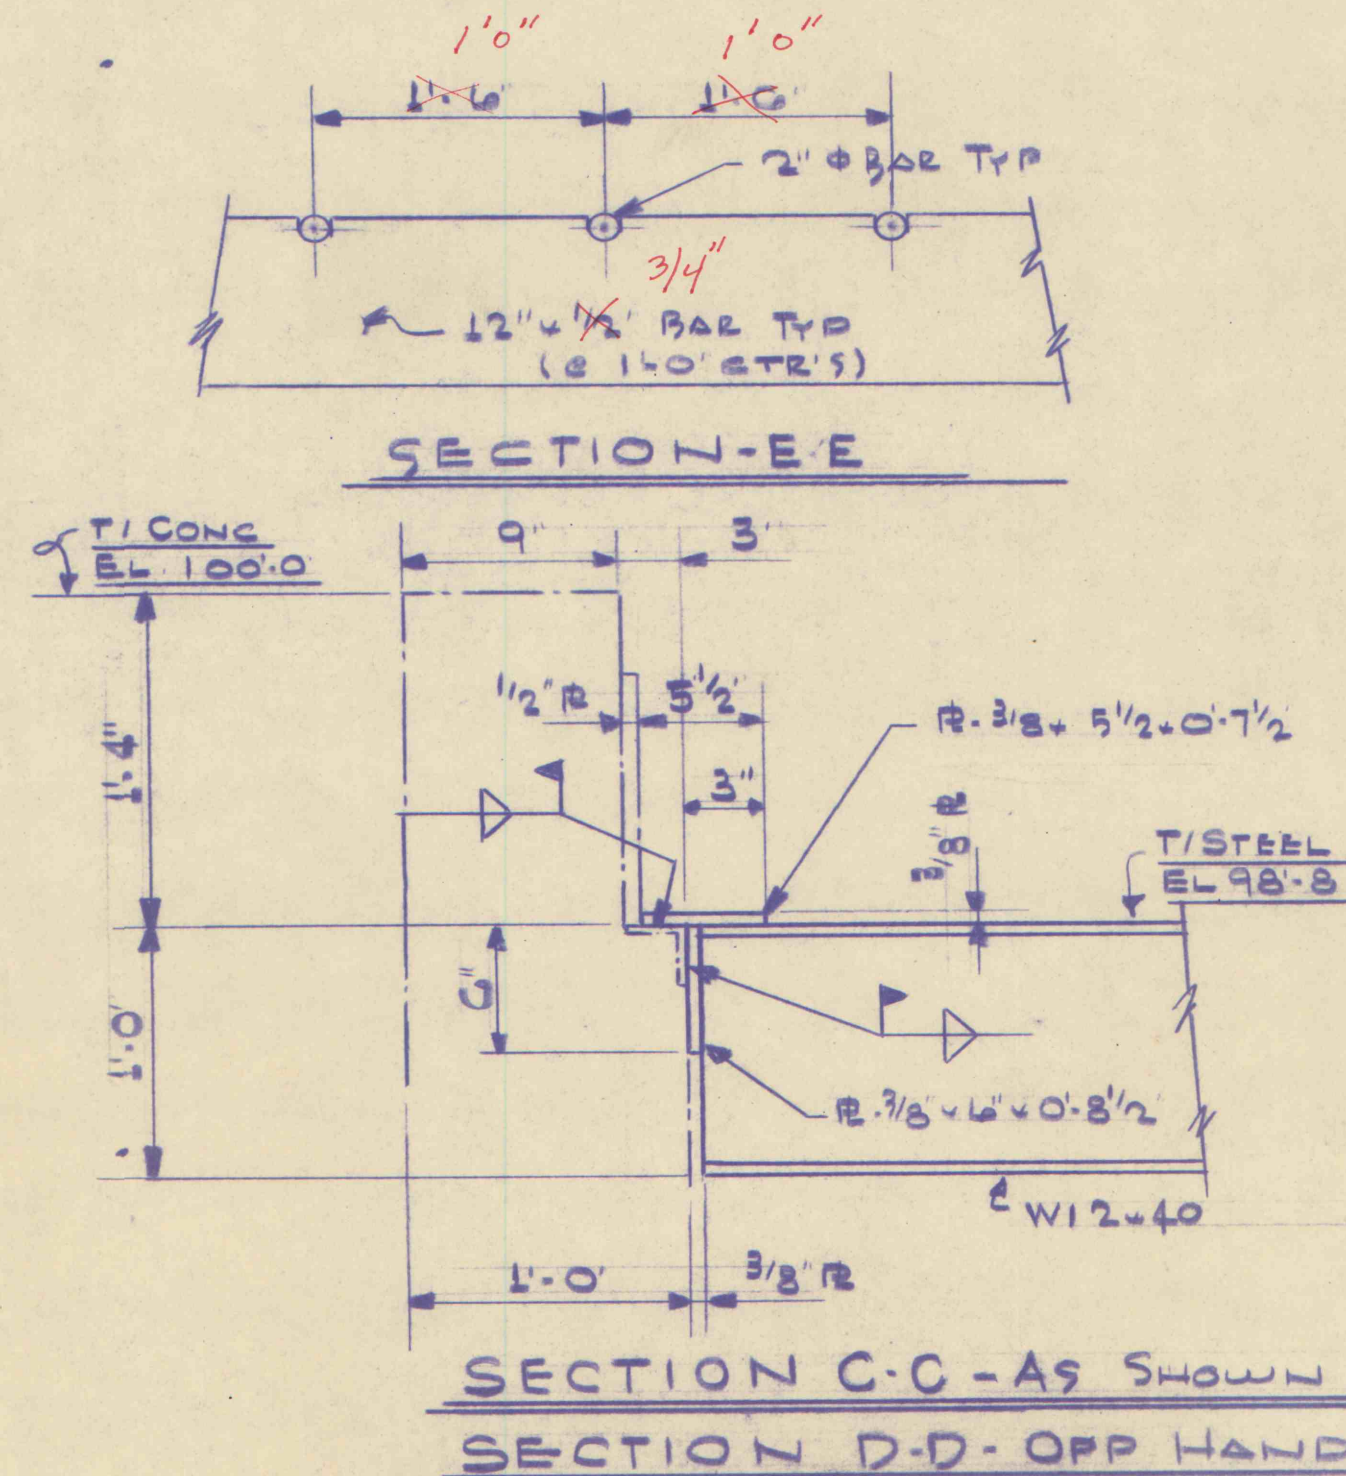
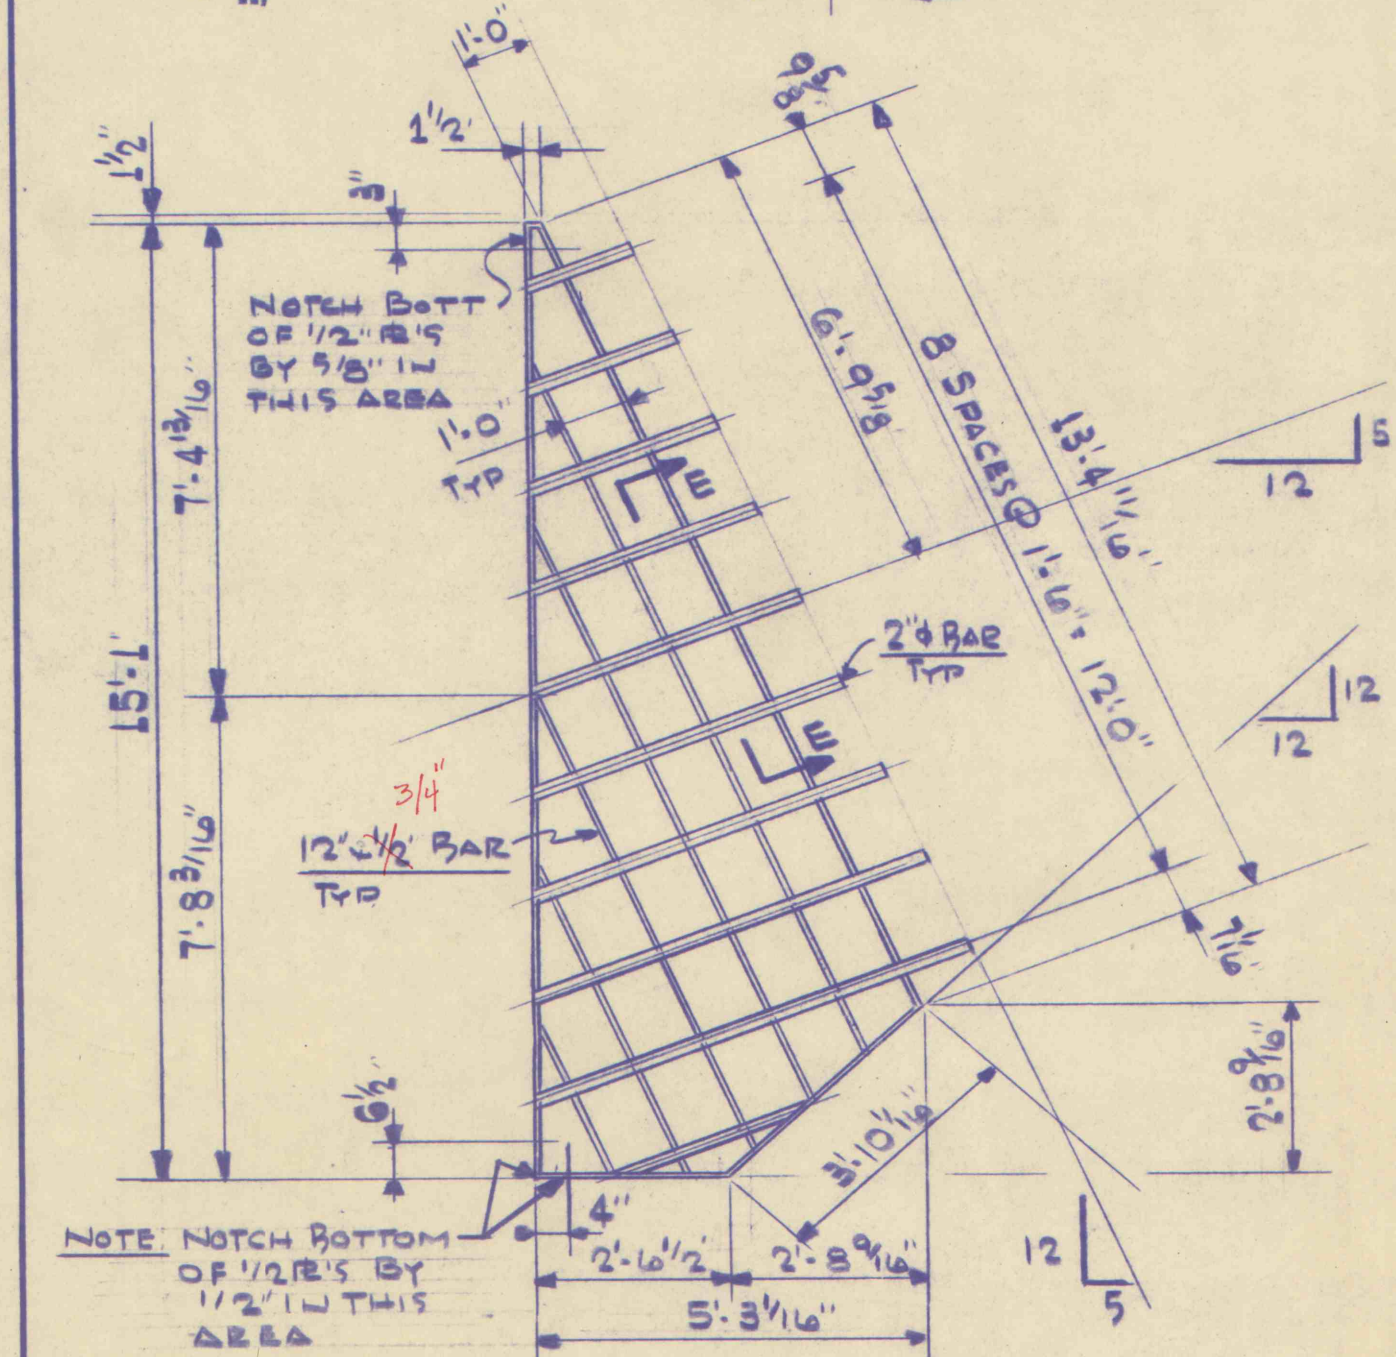
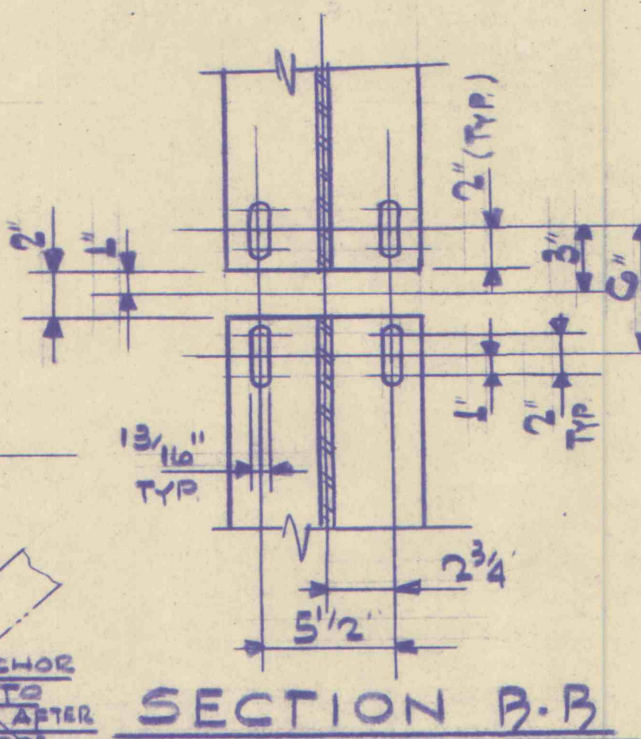
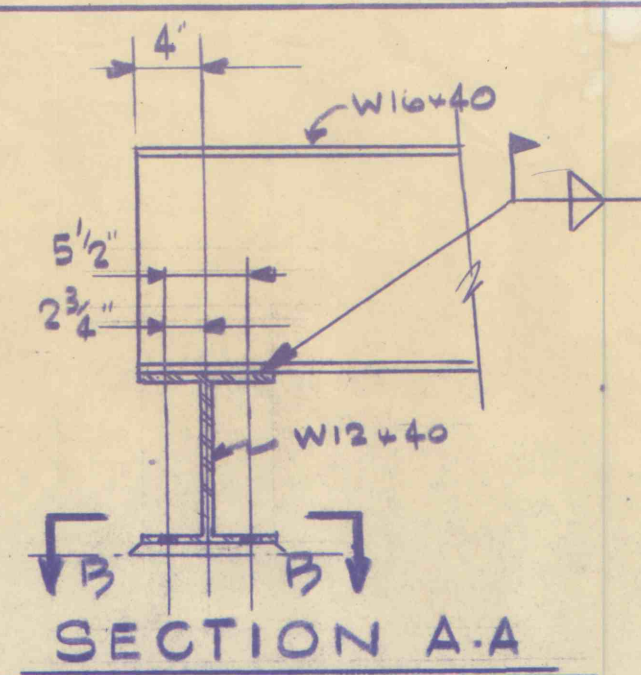


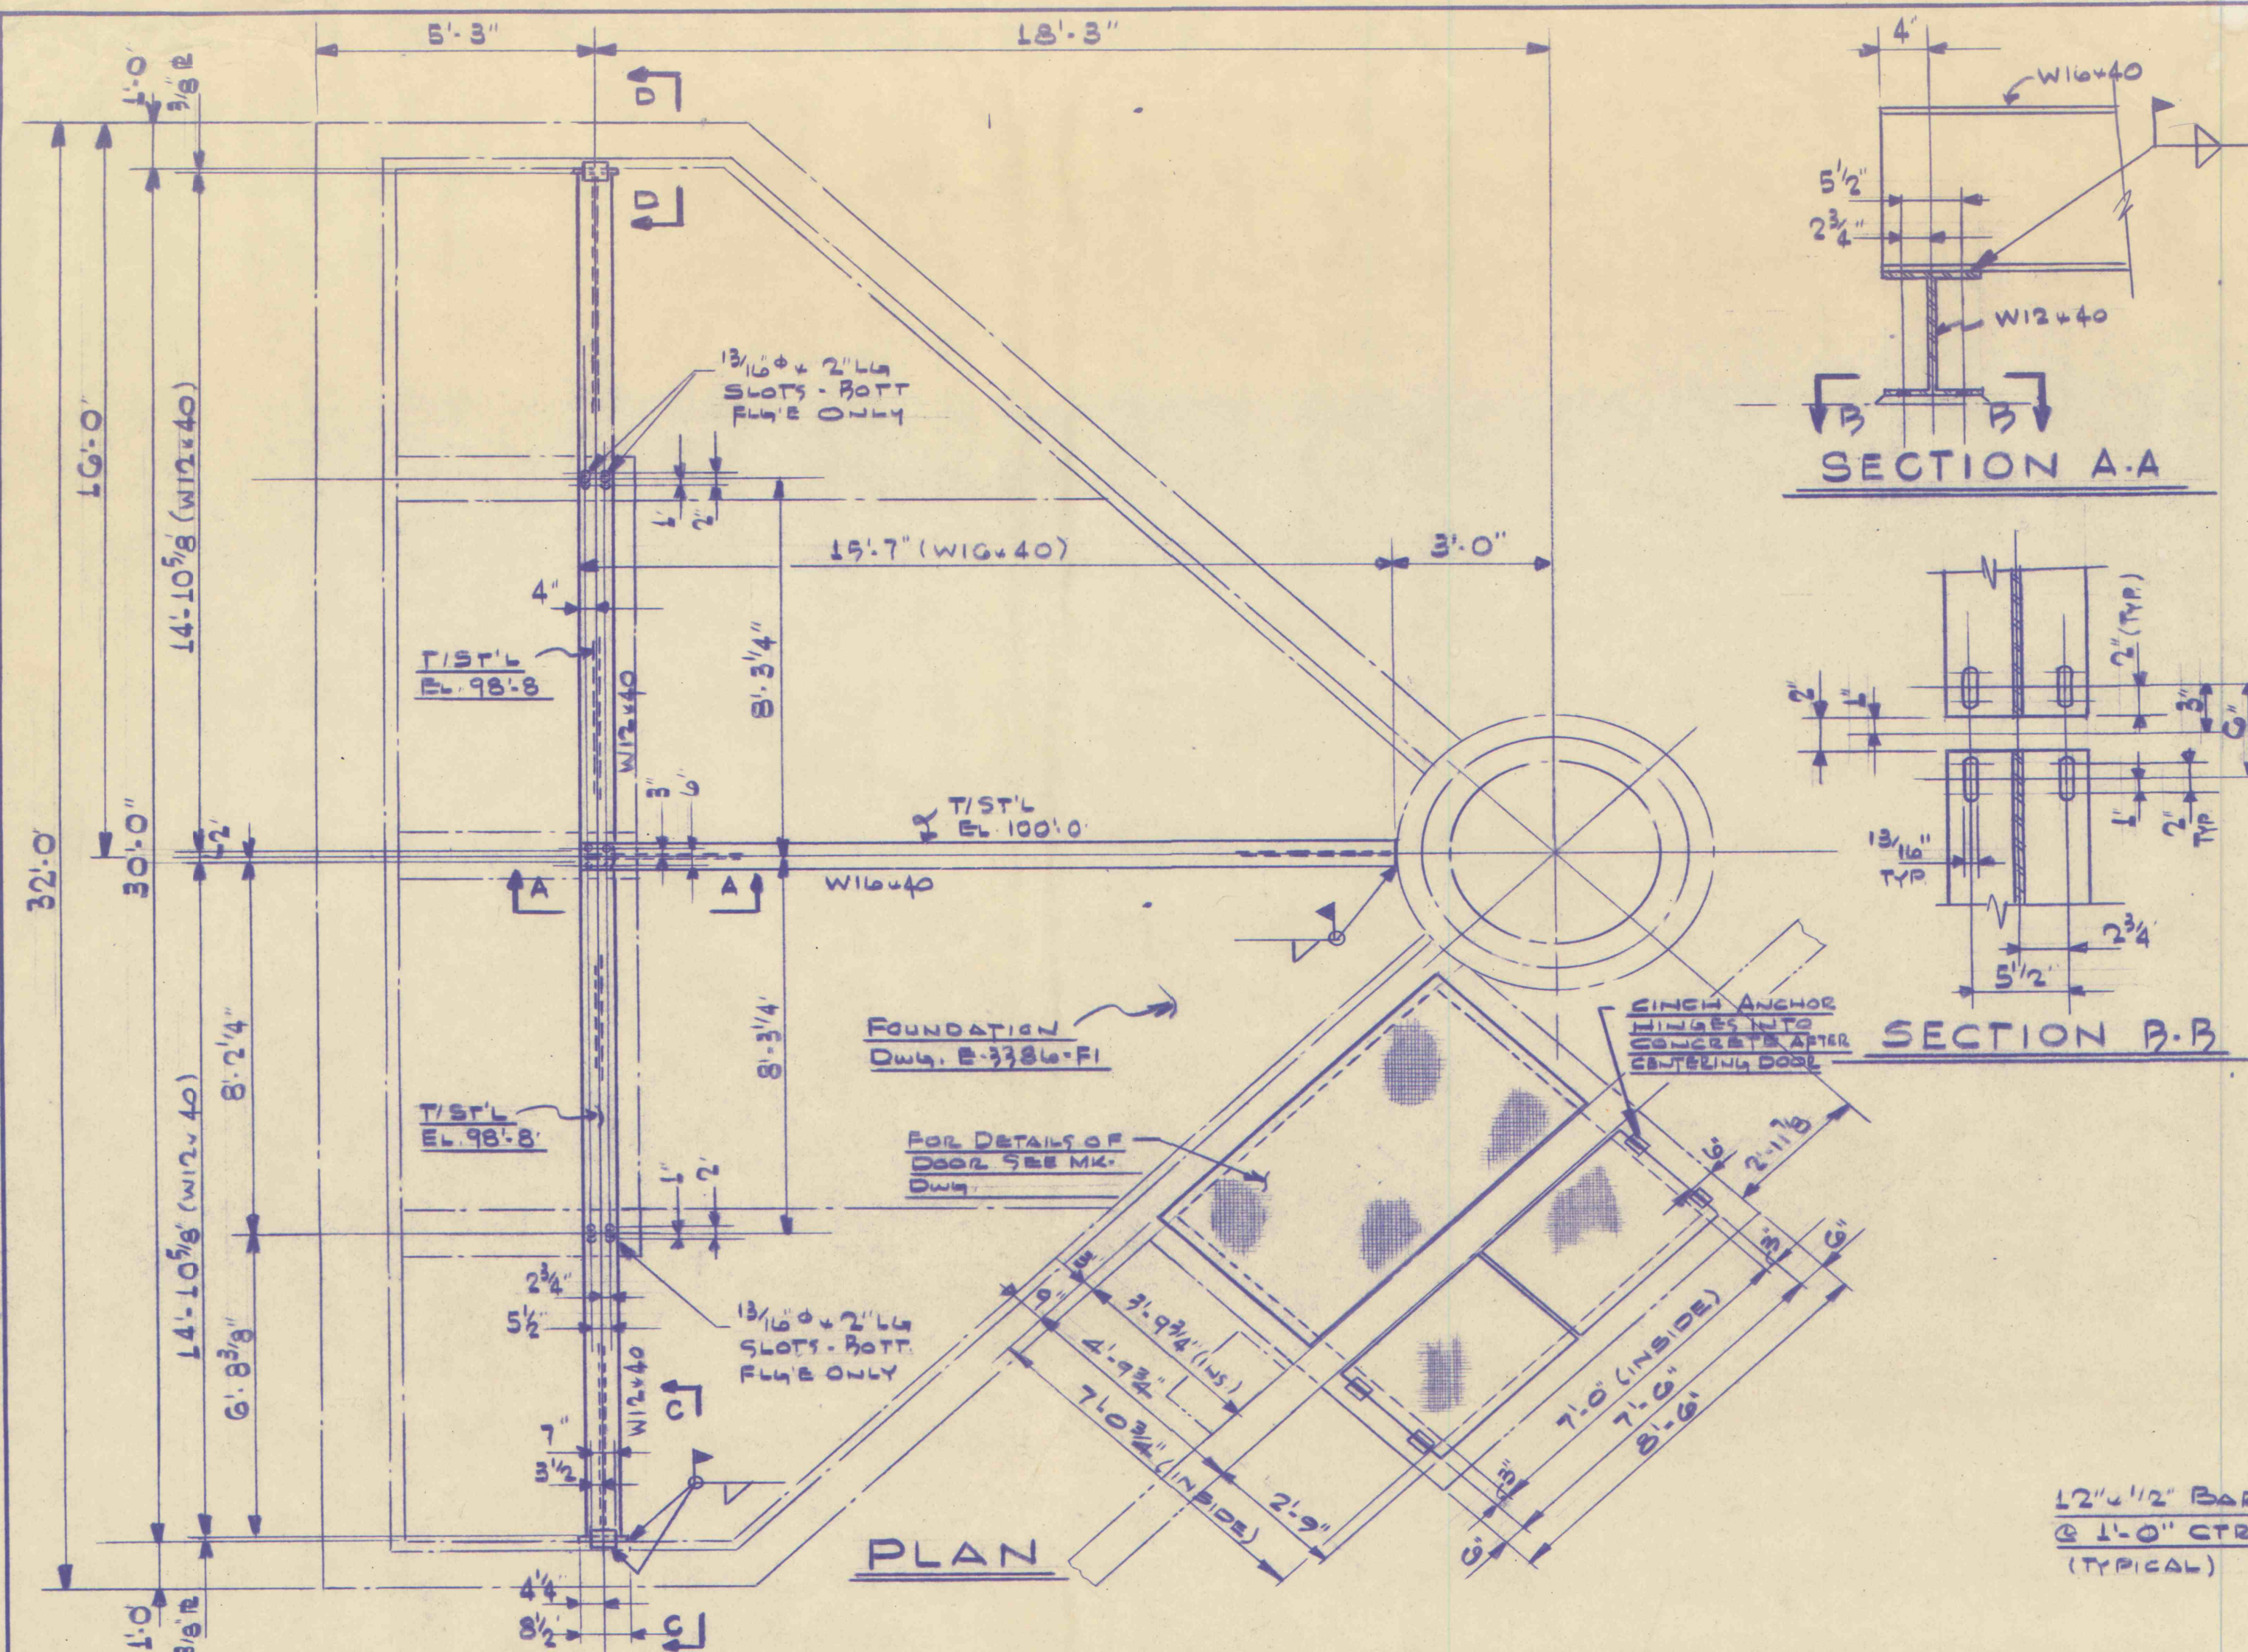

FOR APPROVAL
NOV. 25 1986

SLOGAN ENGINEERING
ENGINEERS • DESIGNERS
PITTSBURGH, PENNSYLVANIA

LUGERNE # 6 MINE
HOMER CITY, PENNSYLVANIA.
COAL TRANSFER STATION MODIFICATIONS
FOUNDATION ST'LS & GRATING

NO.	DATE	REVISION
THIS DRAWING AND ALL INFORMATION THEREON IS THE PROPERTY OF SLOGAN ENGINEERING CO. AND IS CONFIDENTIAL AND MUST NOT BE MADE PUBLIC OR COPIED UNLESS AUTHORIZED BY THE OWNER OR ON DEMAND.		

SCALE: 3/8" = 1'-0"	DRAWN BY: W.C.S	DRAWING NO. E-3386-S2
DATE: 11-21-84	CHECKED BY:	

IMAPS # 15171