


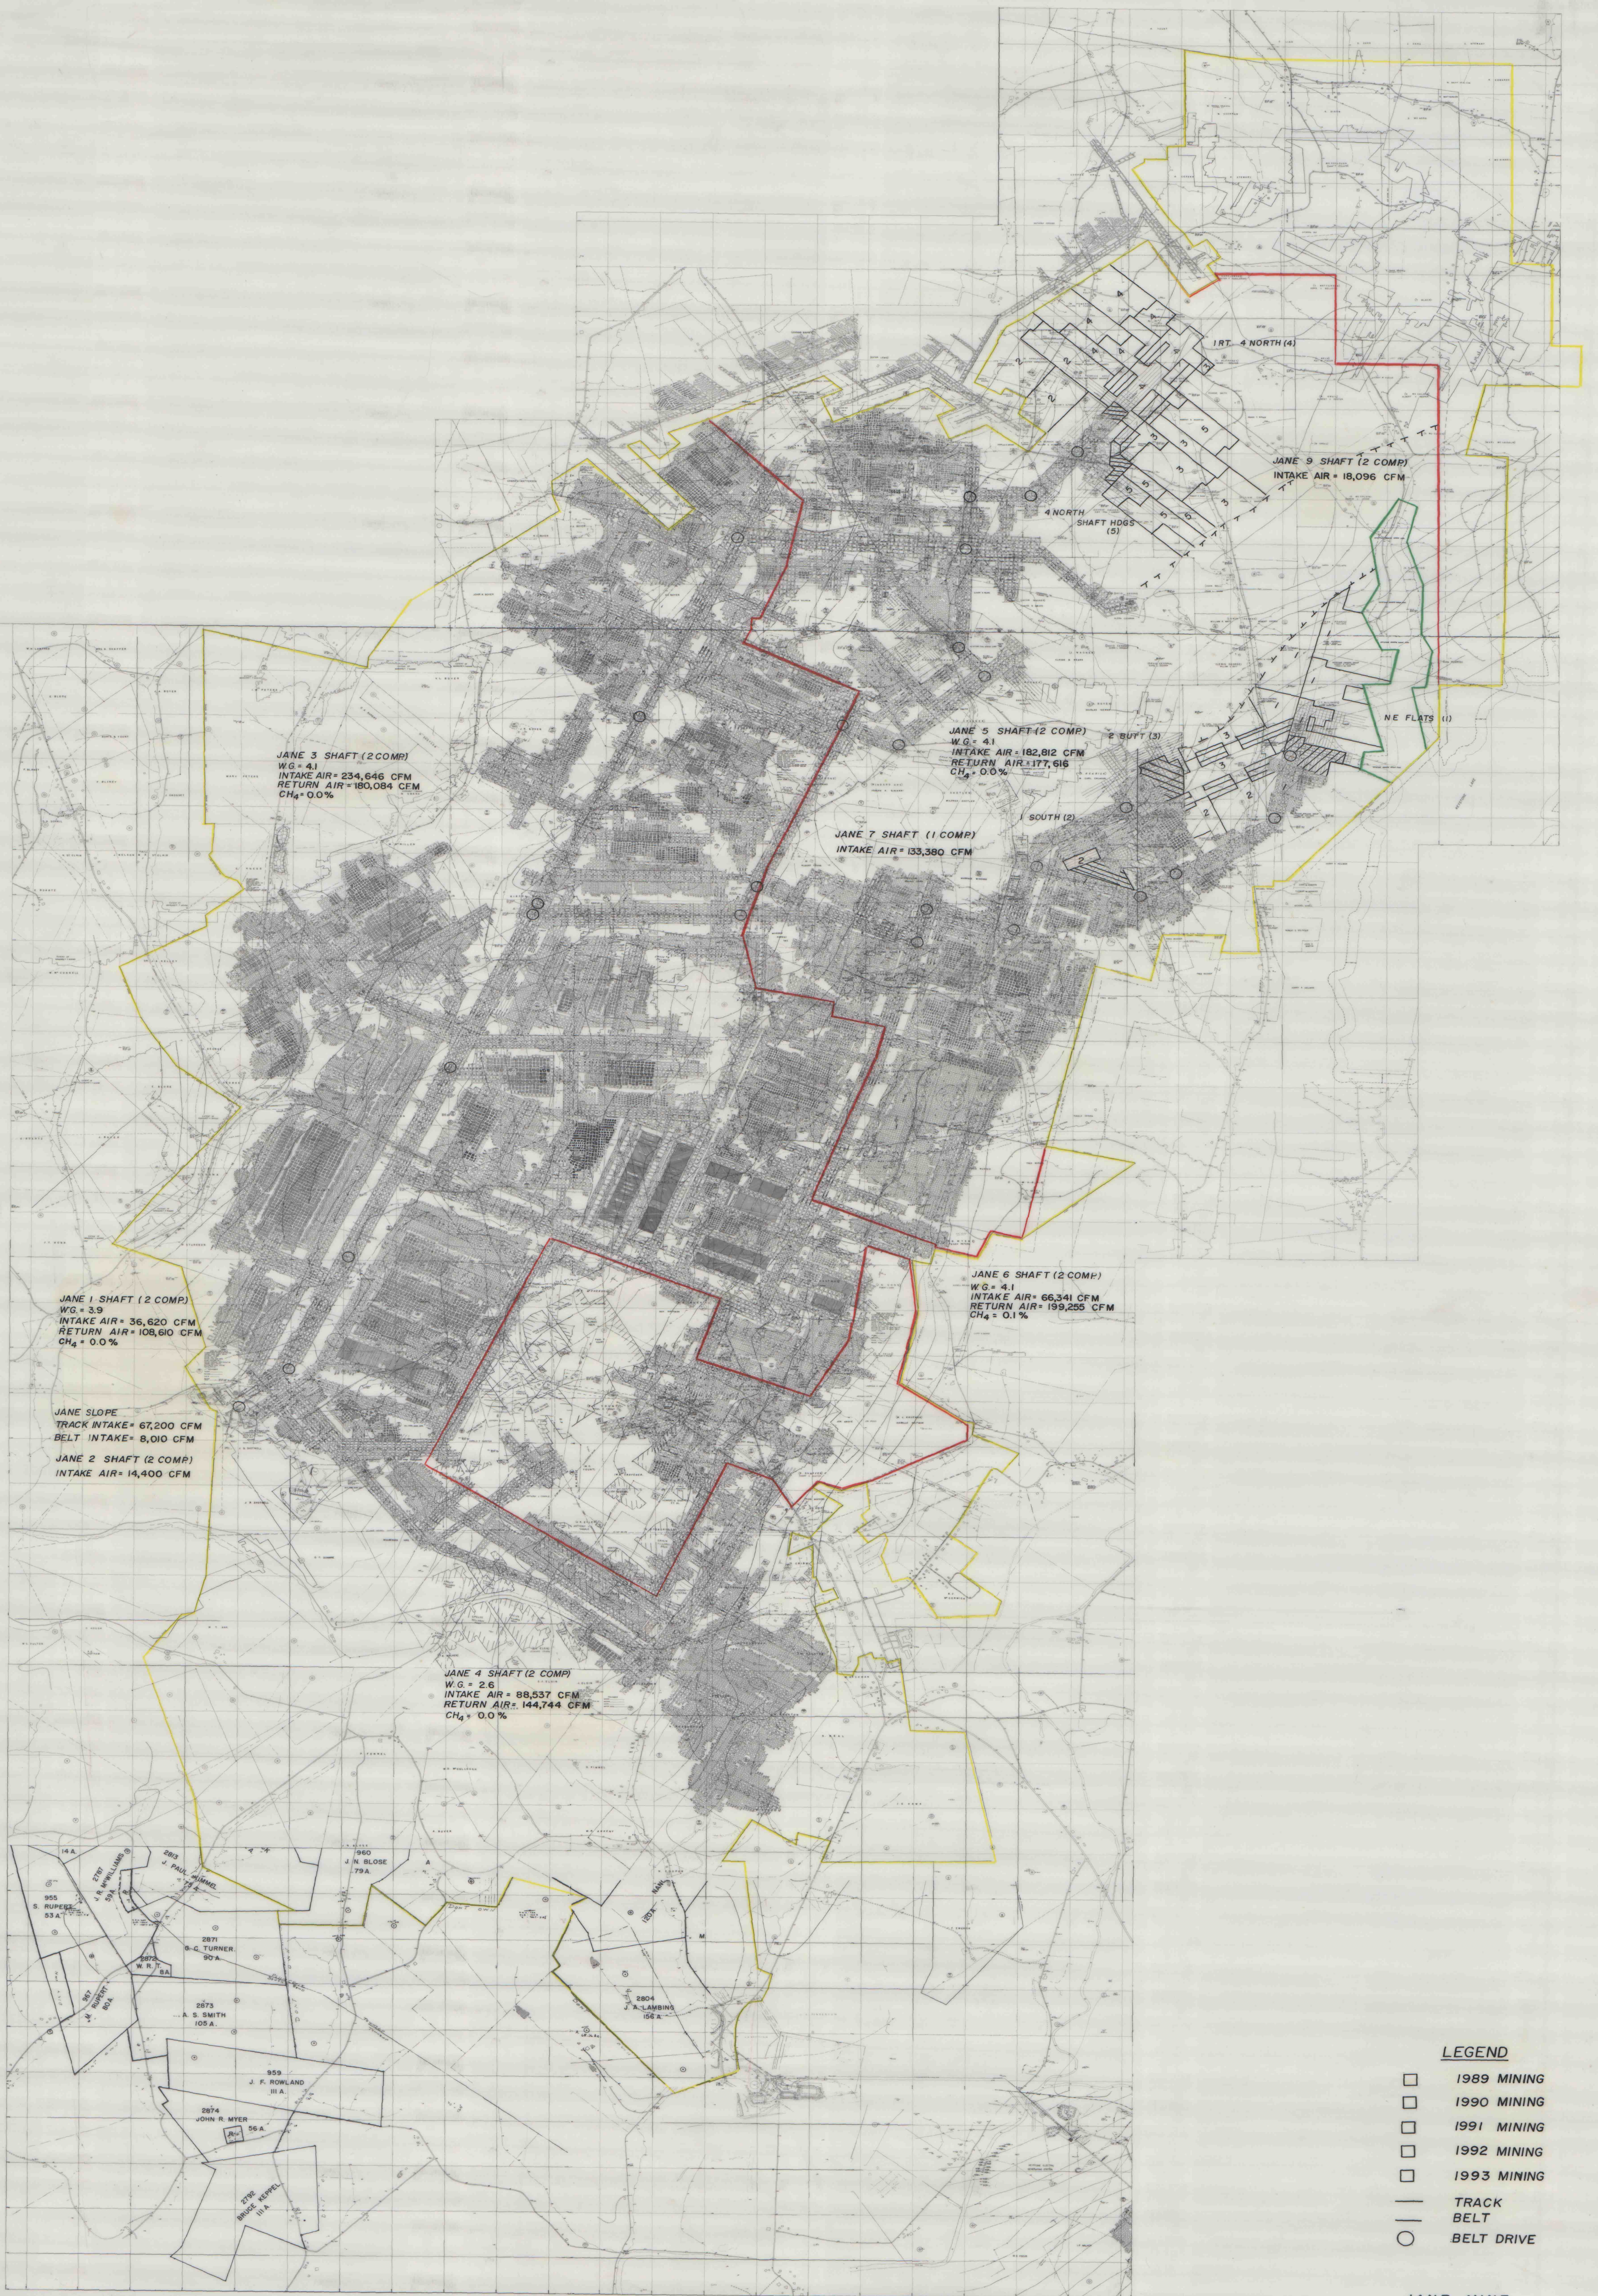

LEGEND

- 1989 MINING
- 1990 MINING
- 1991 MINING
- 1992 MINING
- 1993 MINING
- TRACK
- BELT
- BELT DRIVE

