


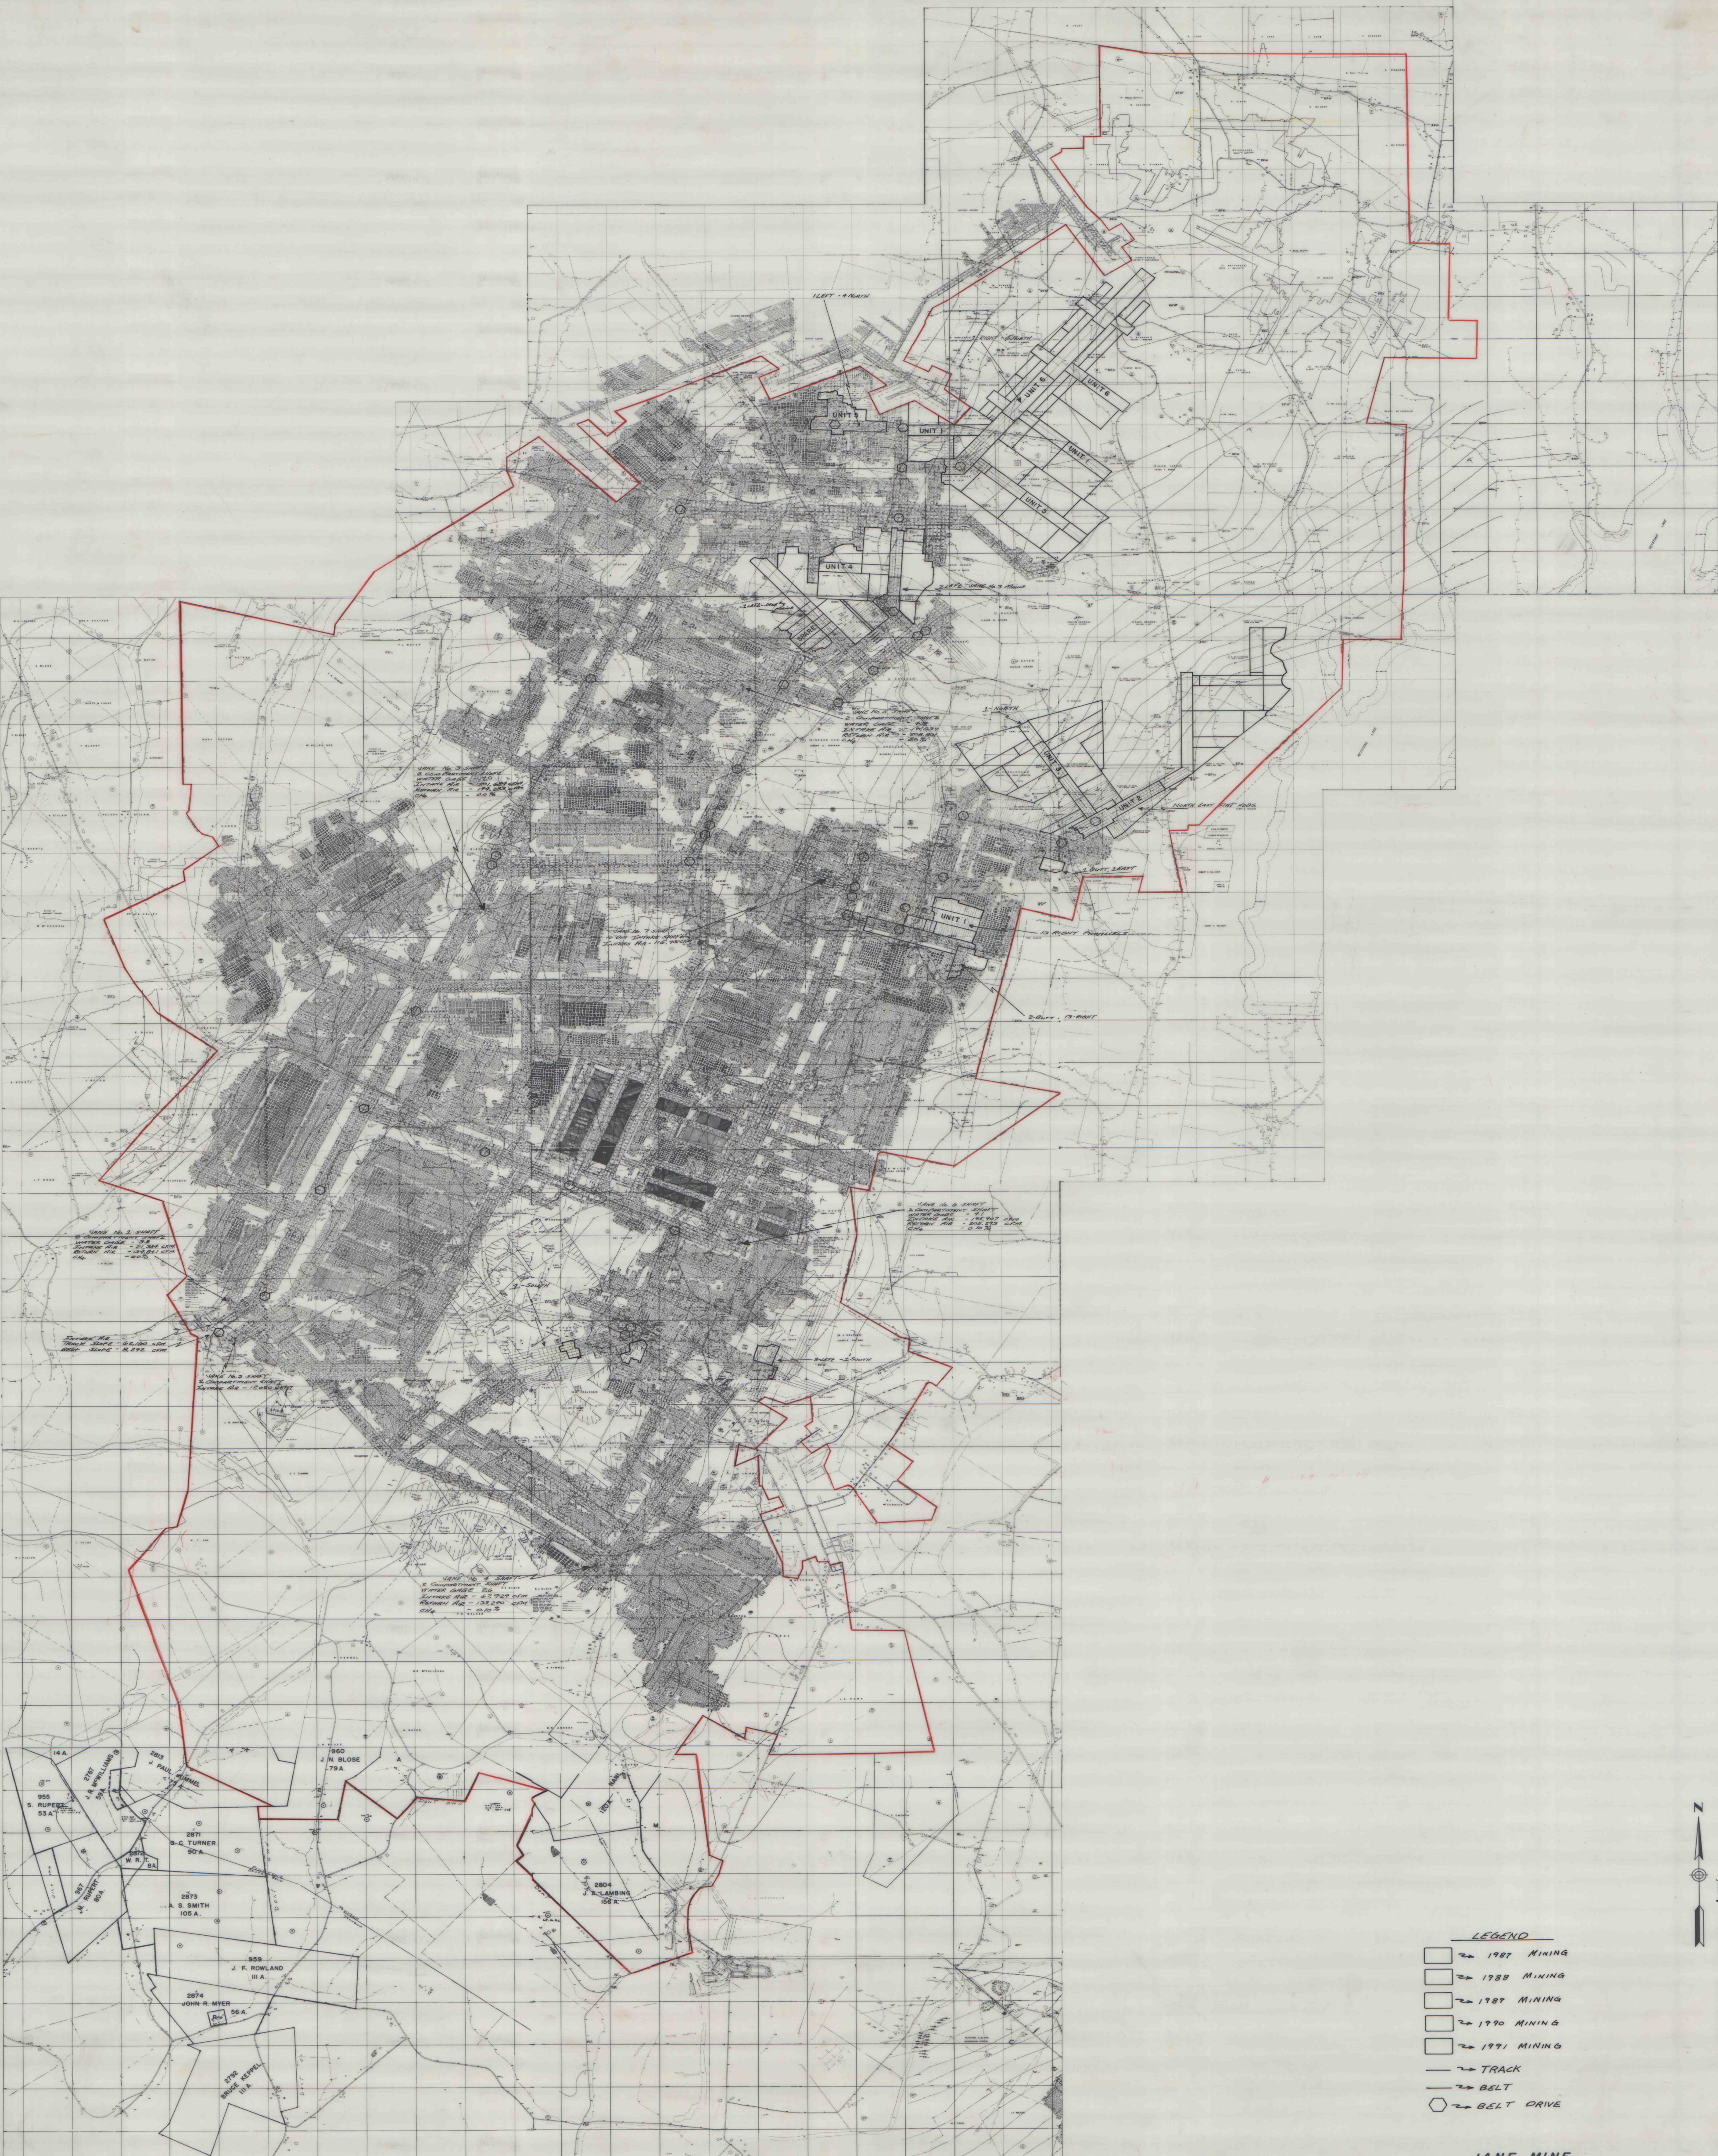

- LEGEND**
- 1981 MINING
 - 1988 MINING
 - 1989 MINING
 - 1990 MINING
 - 1991 MINING
 - TRACK
 - BELT
 - BELT DRIVE