
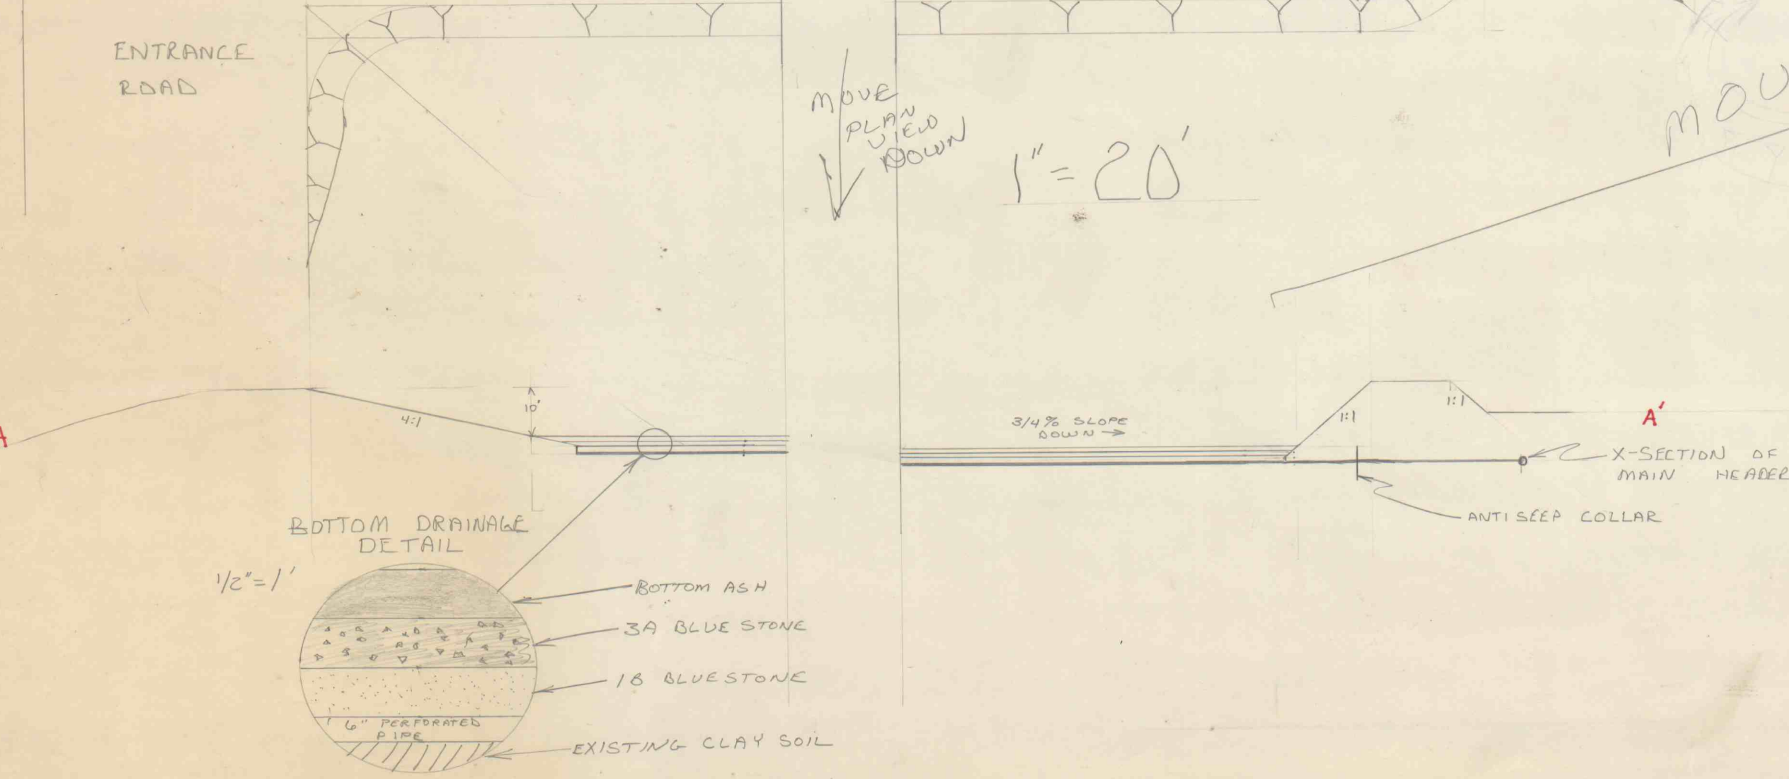
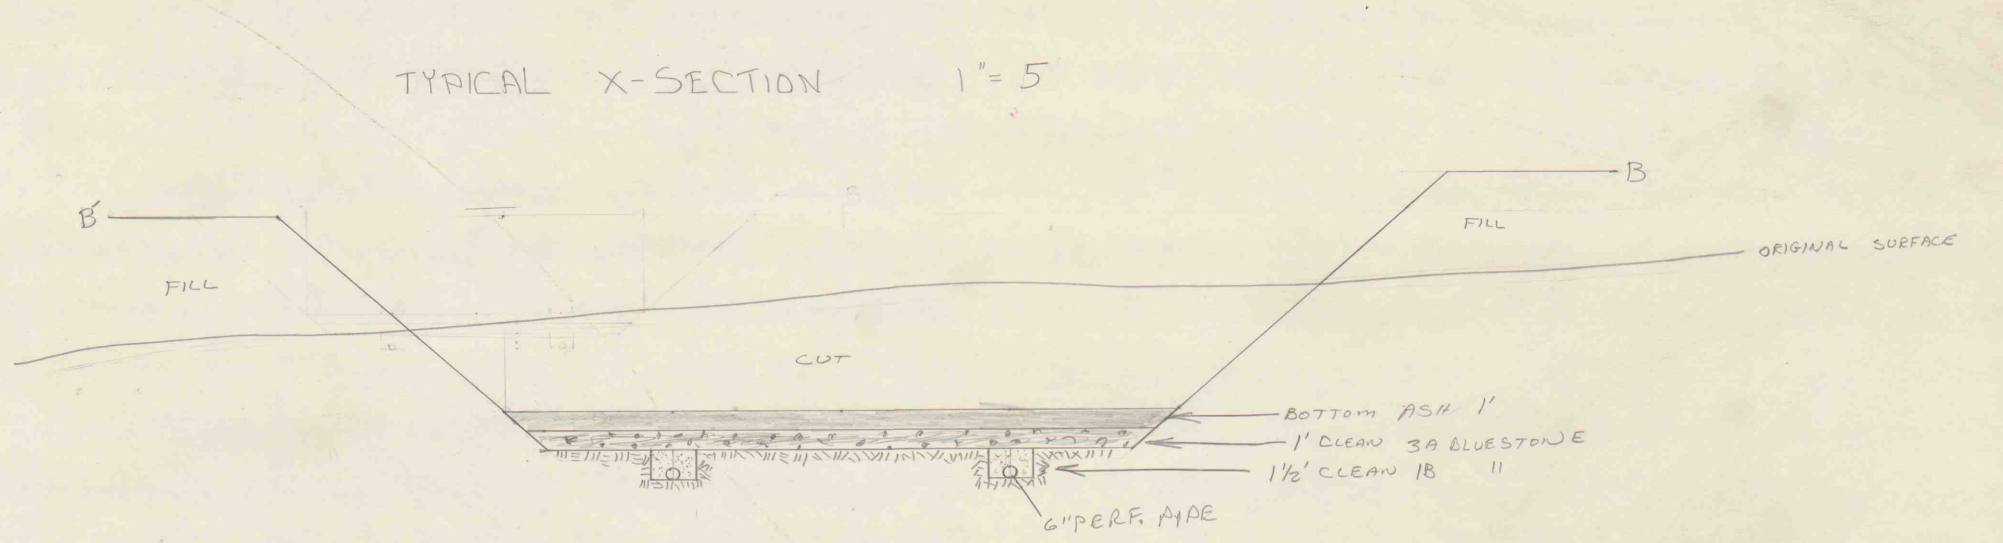


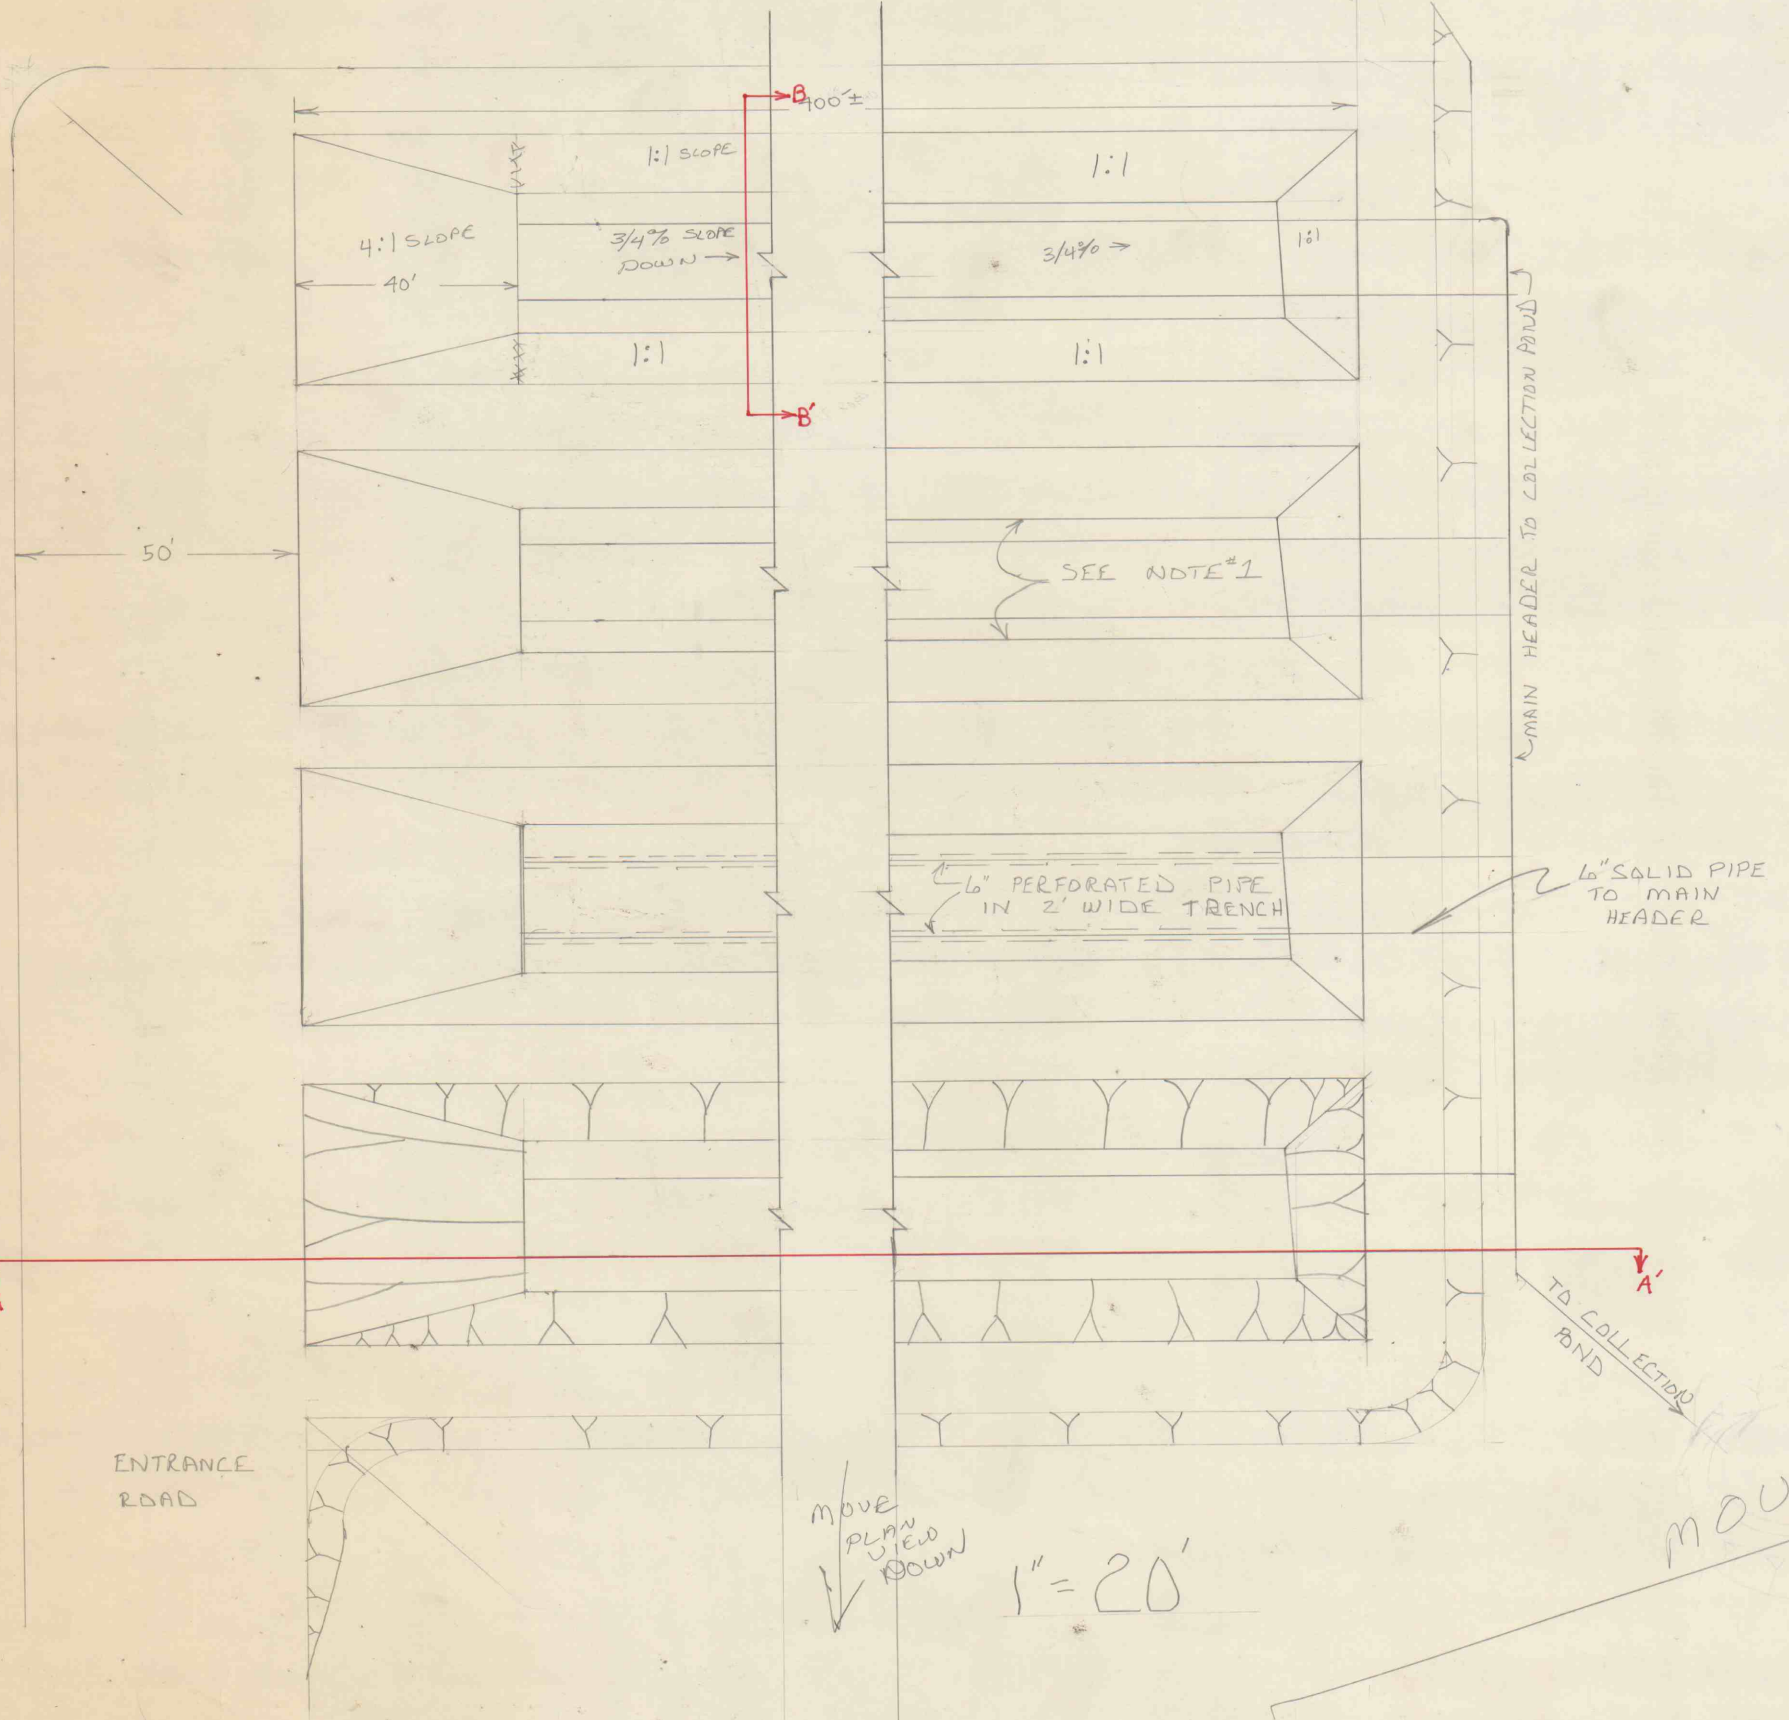

MOVE HERE

NOTES
#1- BOTTOMS OF PONDS NARROW
DUE TO CONVERGING SLOPES

PREPARED BY: A. R. ROBERTS
DE: L. G. CONNELL

HELVETIA COAL CO.
ENGINEERING DEPT., INDIANA, PA.

MADE BY	SCALE
TRACED BY	DATE
CHECKED BY	NO.