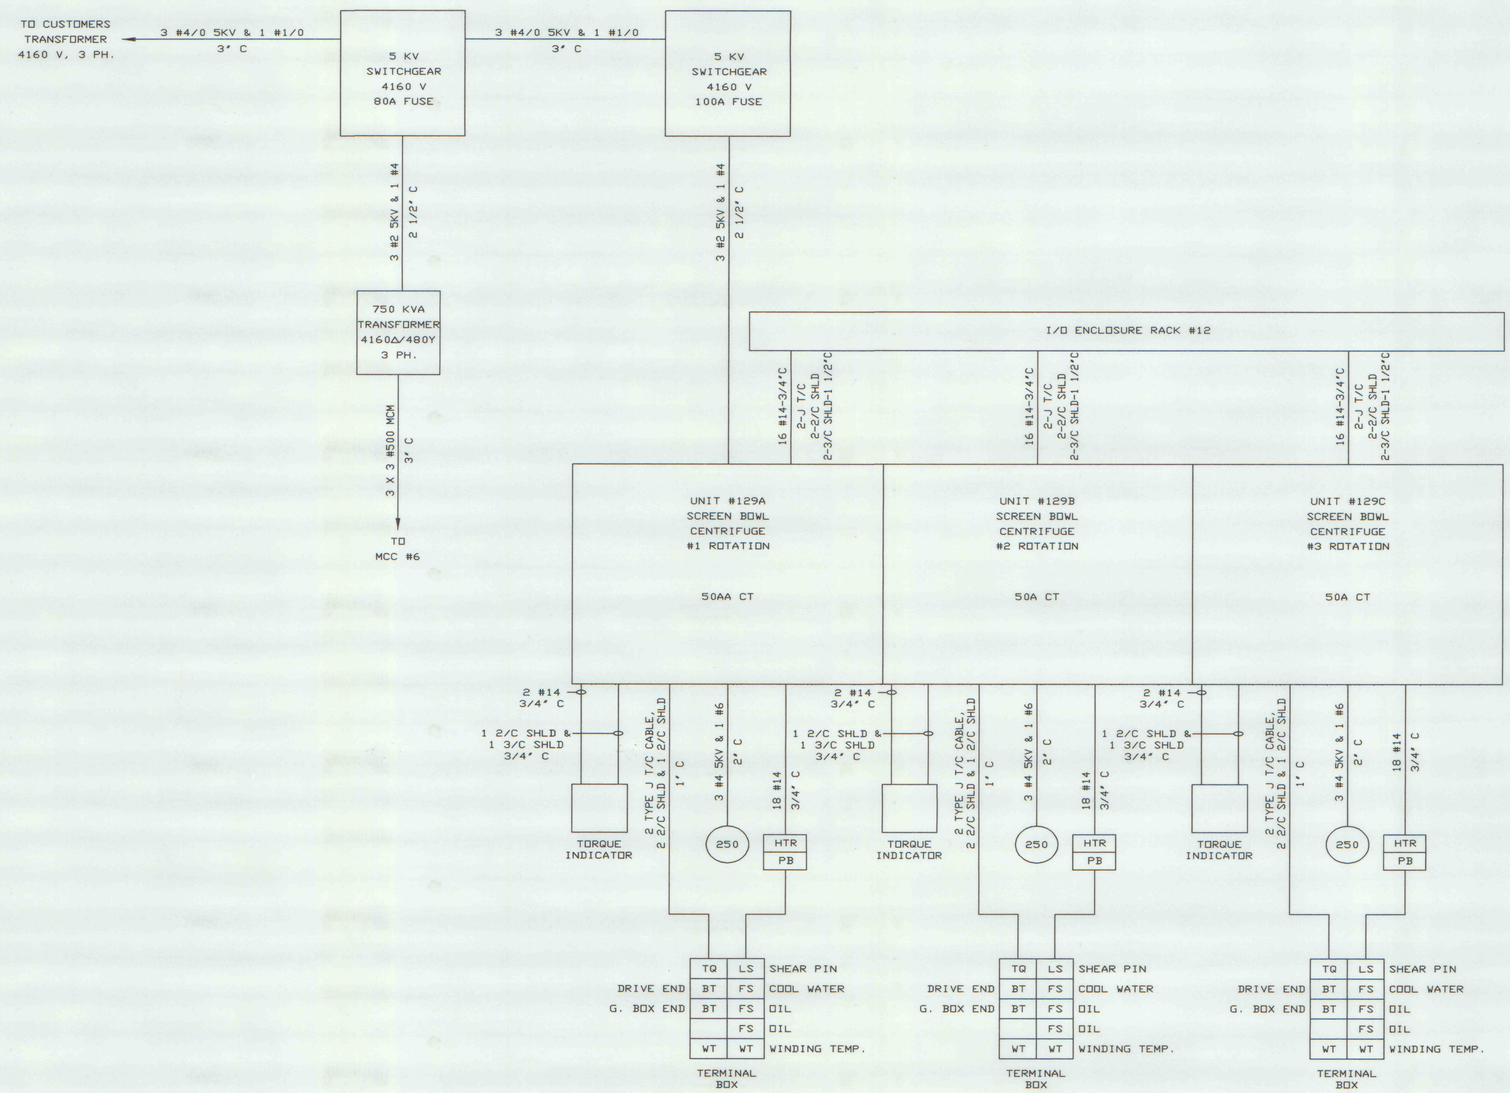

THIS DRAWING IS SUPPORTED BY AUTOCAD ELECTRONIC CAD SOFTWARE DO NOT REVISE MANUALLY

IMAPS # 15232

W.G. Electric

REVISIONS No.	DESCRIPTION	DATE	BY	CHK'D.	DATE
1	REVISED PER AS BUILT	10/26/95	COKE		

DRAWN BY: COKE	DATE 6/2/95	ROCHESTER & PITTSBURGH COAL CO.	NUMBER OF DRAWINGS THIS PROJECT
DESIGNED BY: R.F.	DATE 5/13/95	KEYSTONE COAL MINING ORP.	
CHECKED BY:	DATE	PREPARATION PLANT MODIFICATIONS	
APPROVED BY:	DATE	ELECTRICAL ONE LINE	

SCALE	PROJECT NUMBER
NTS	94-164
DRAWING NUMBER	FILE NUMBER
EL-05	94-164-05

31480 A