


12504 - B-39

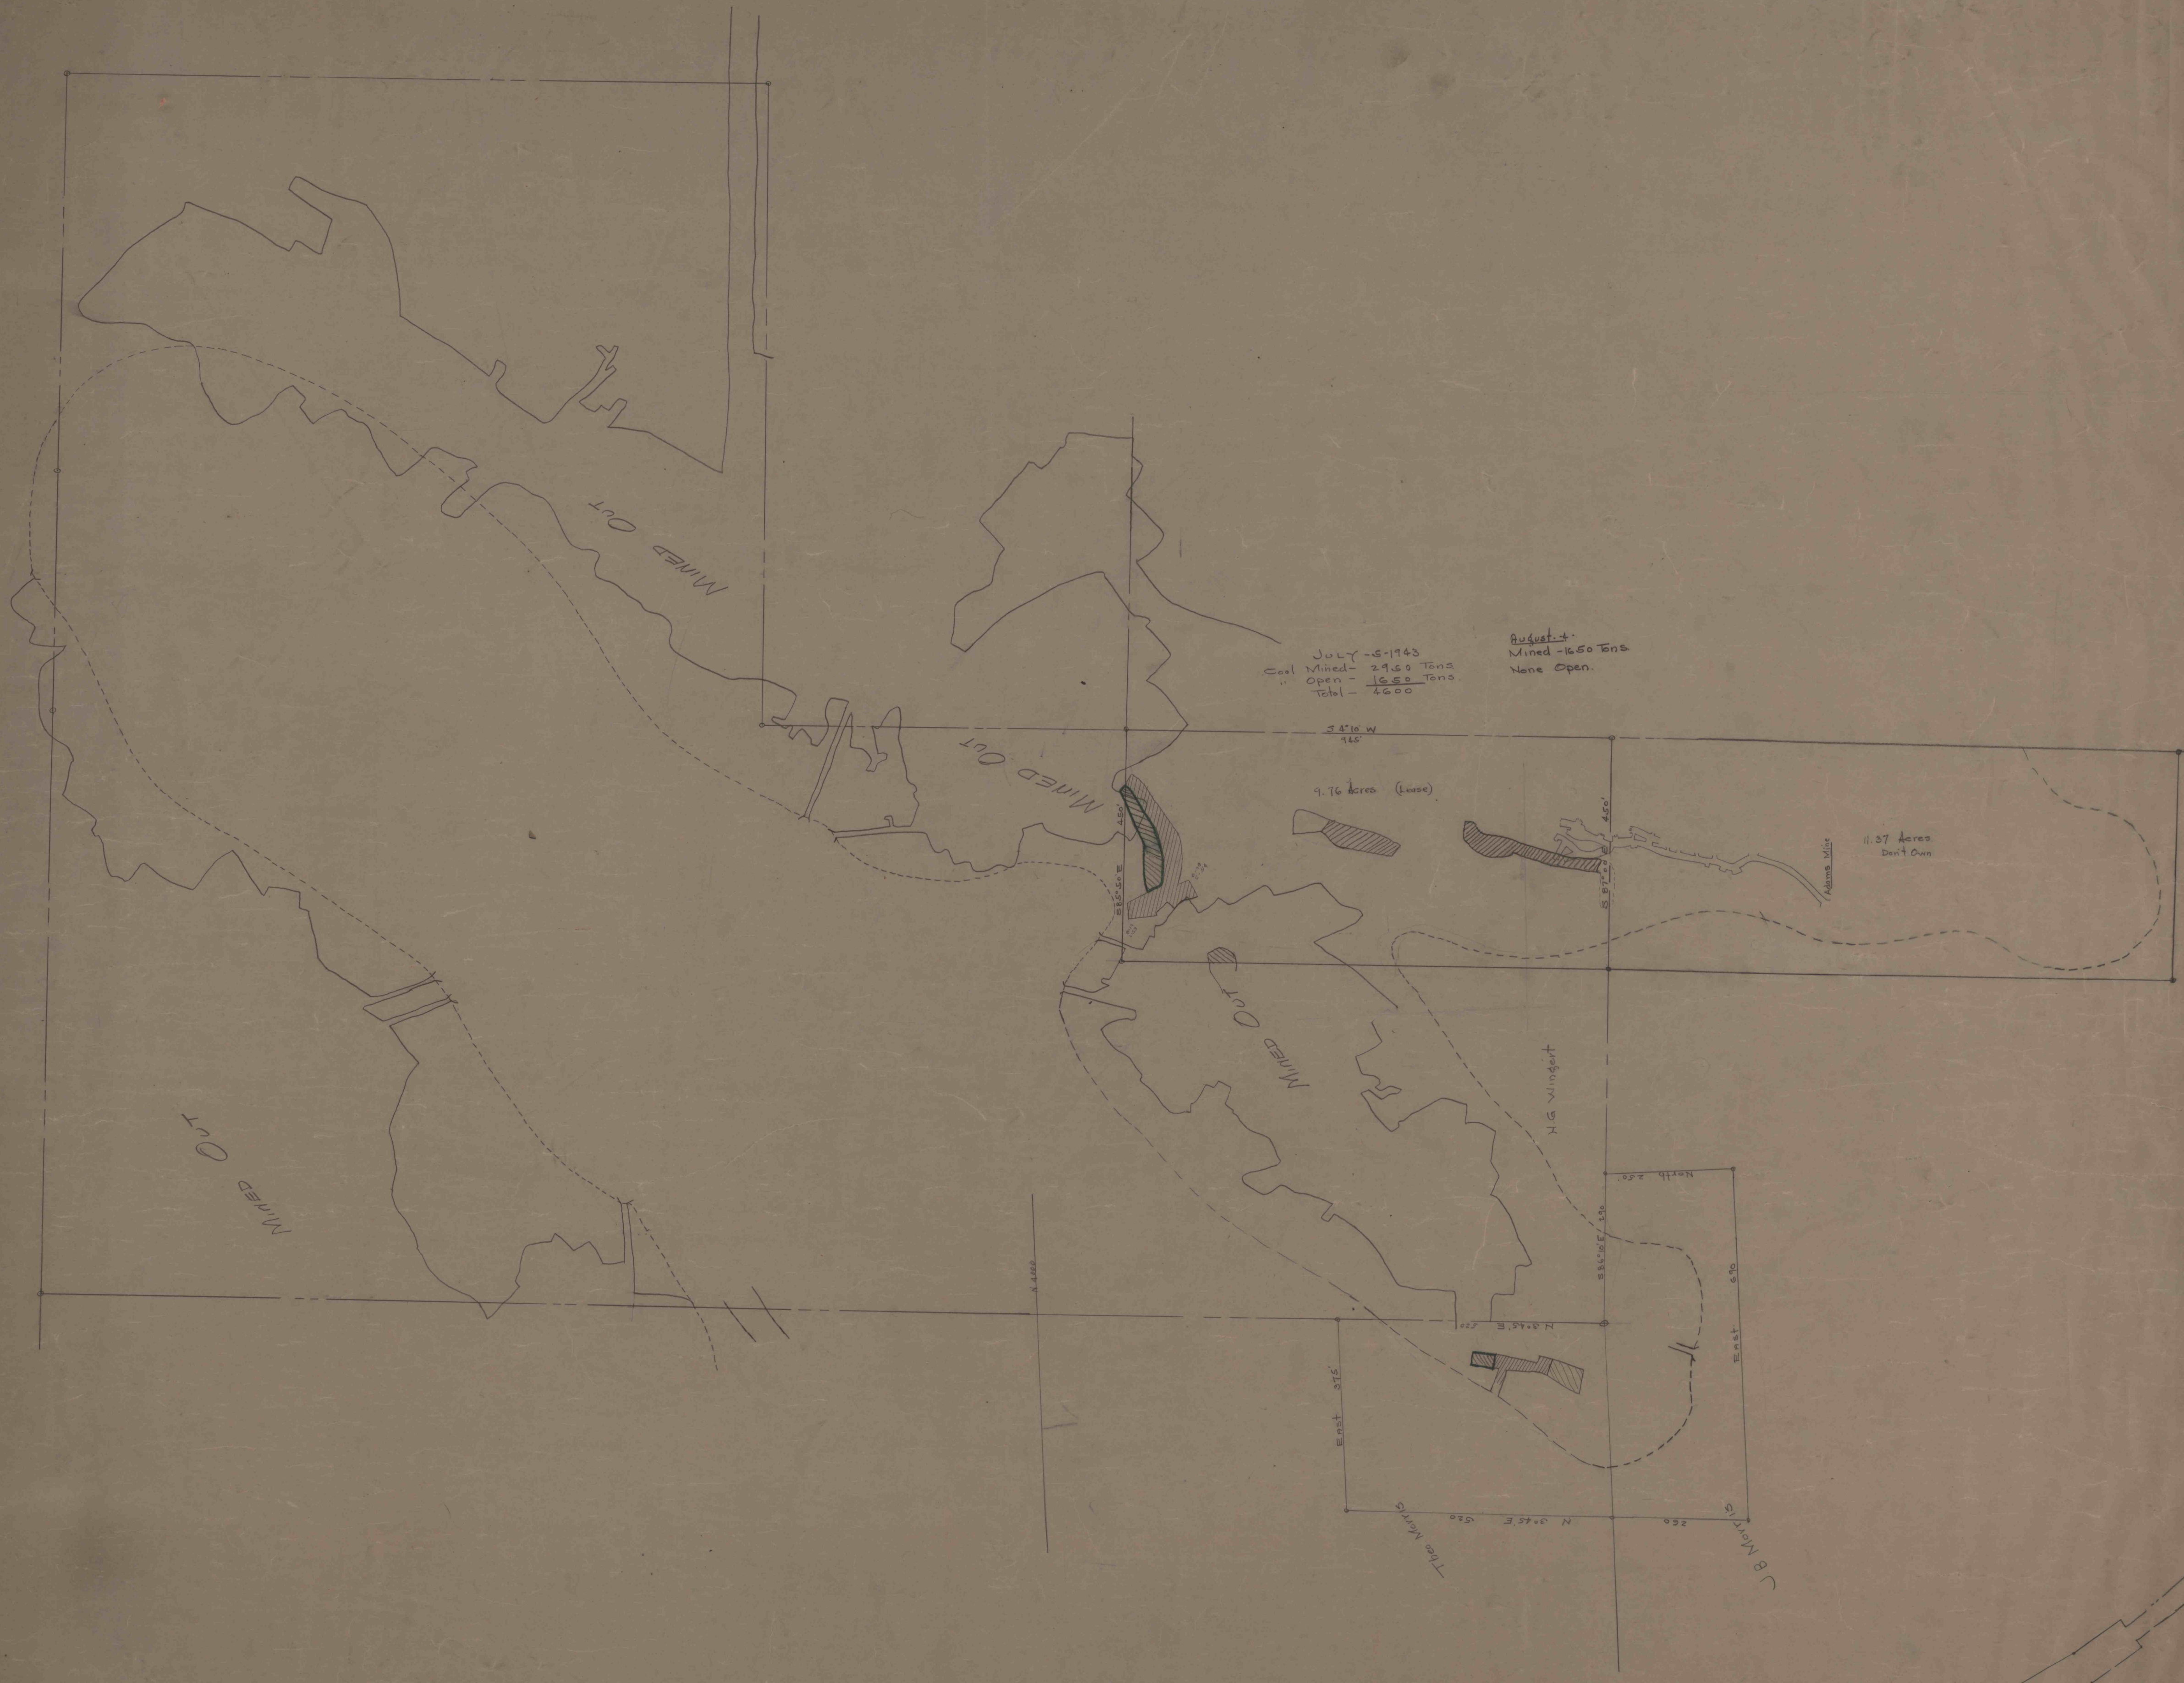

July - 5-1943
Coal Mined - 29.60 Tons
Open - 16.50 Tons
Total - 46.00

August - 4
Mined - 16.50 Tons
None Open.

IMAPS # 15204