

# Plan of Eureka Mines.


Owned and Operated by

Fox, Kifer and Co.

Jacobs Creek Pa.

W.G. Mose M.E.

Wm. Newberry

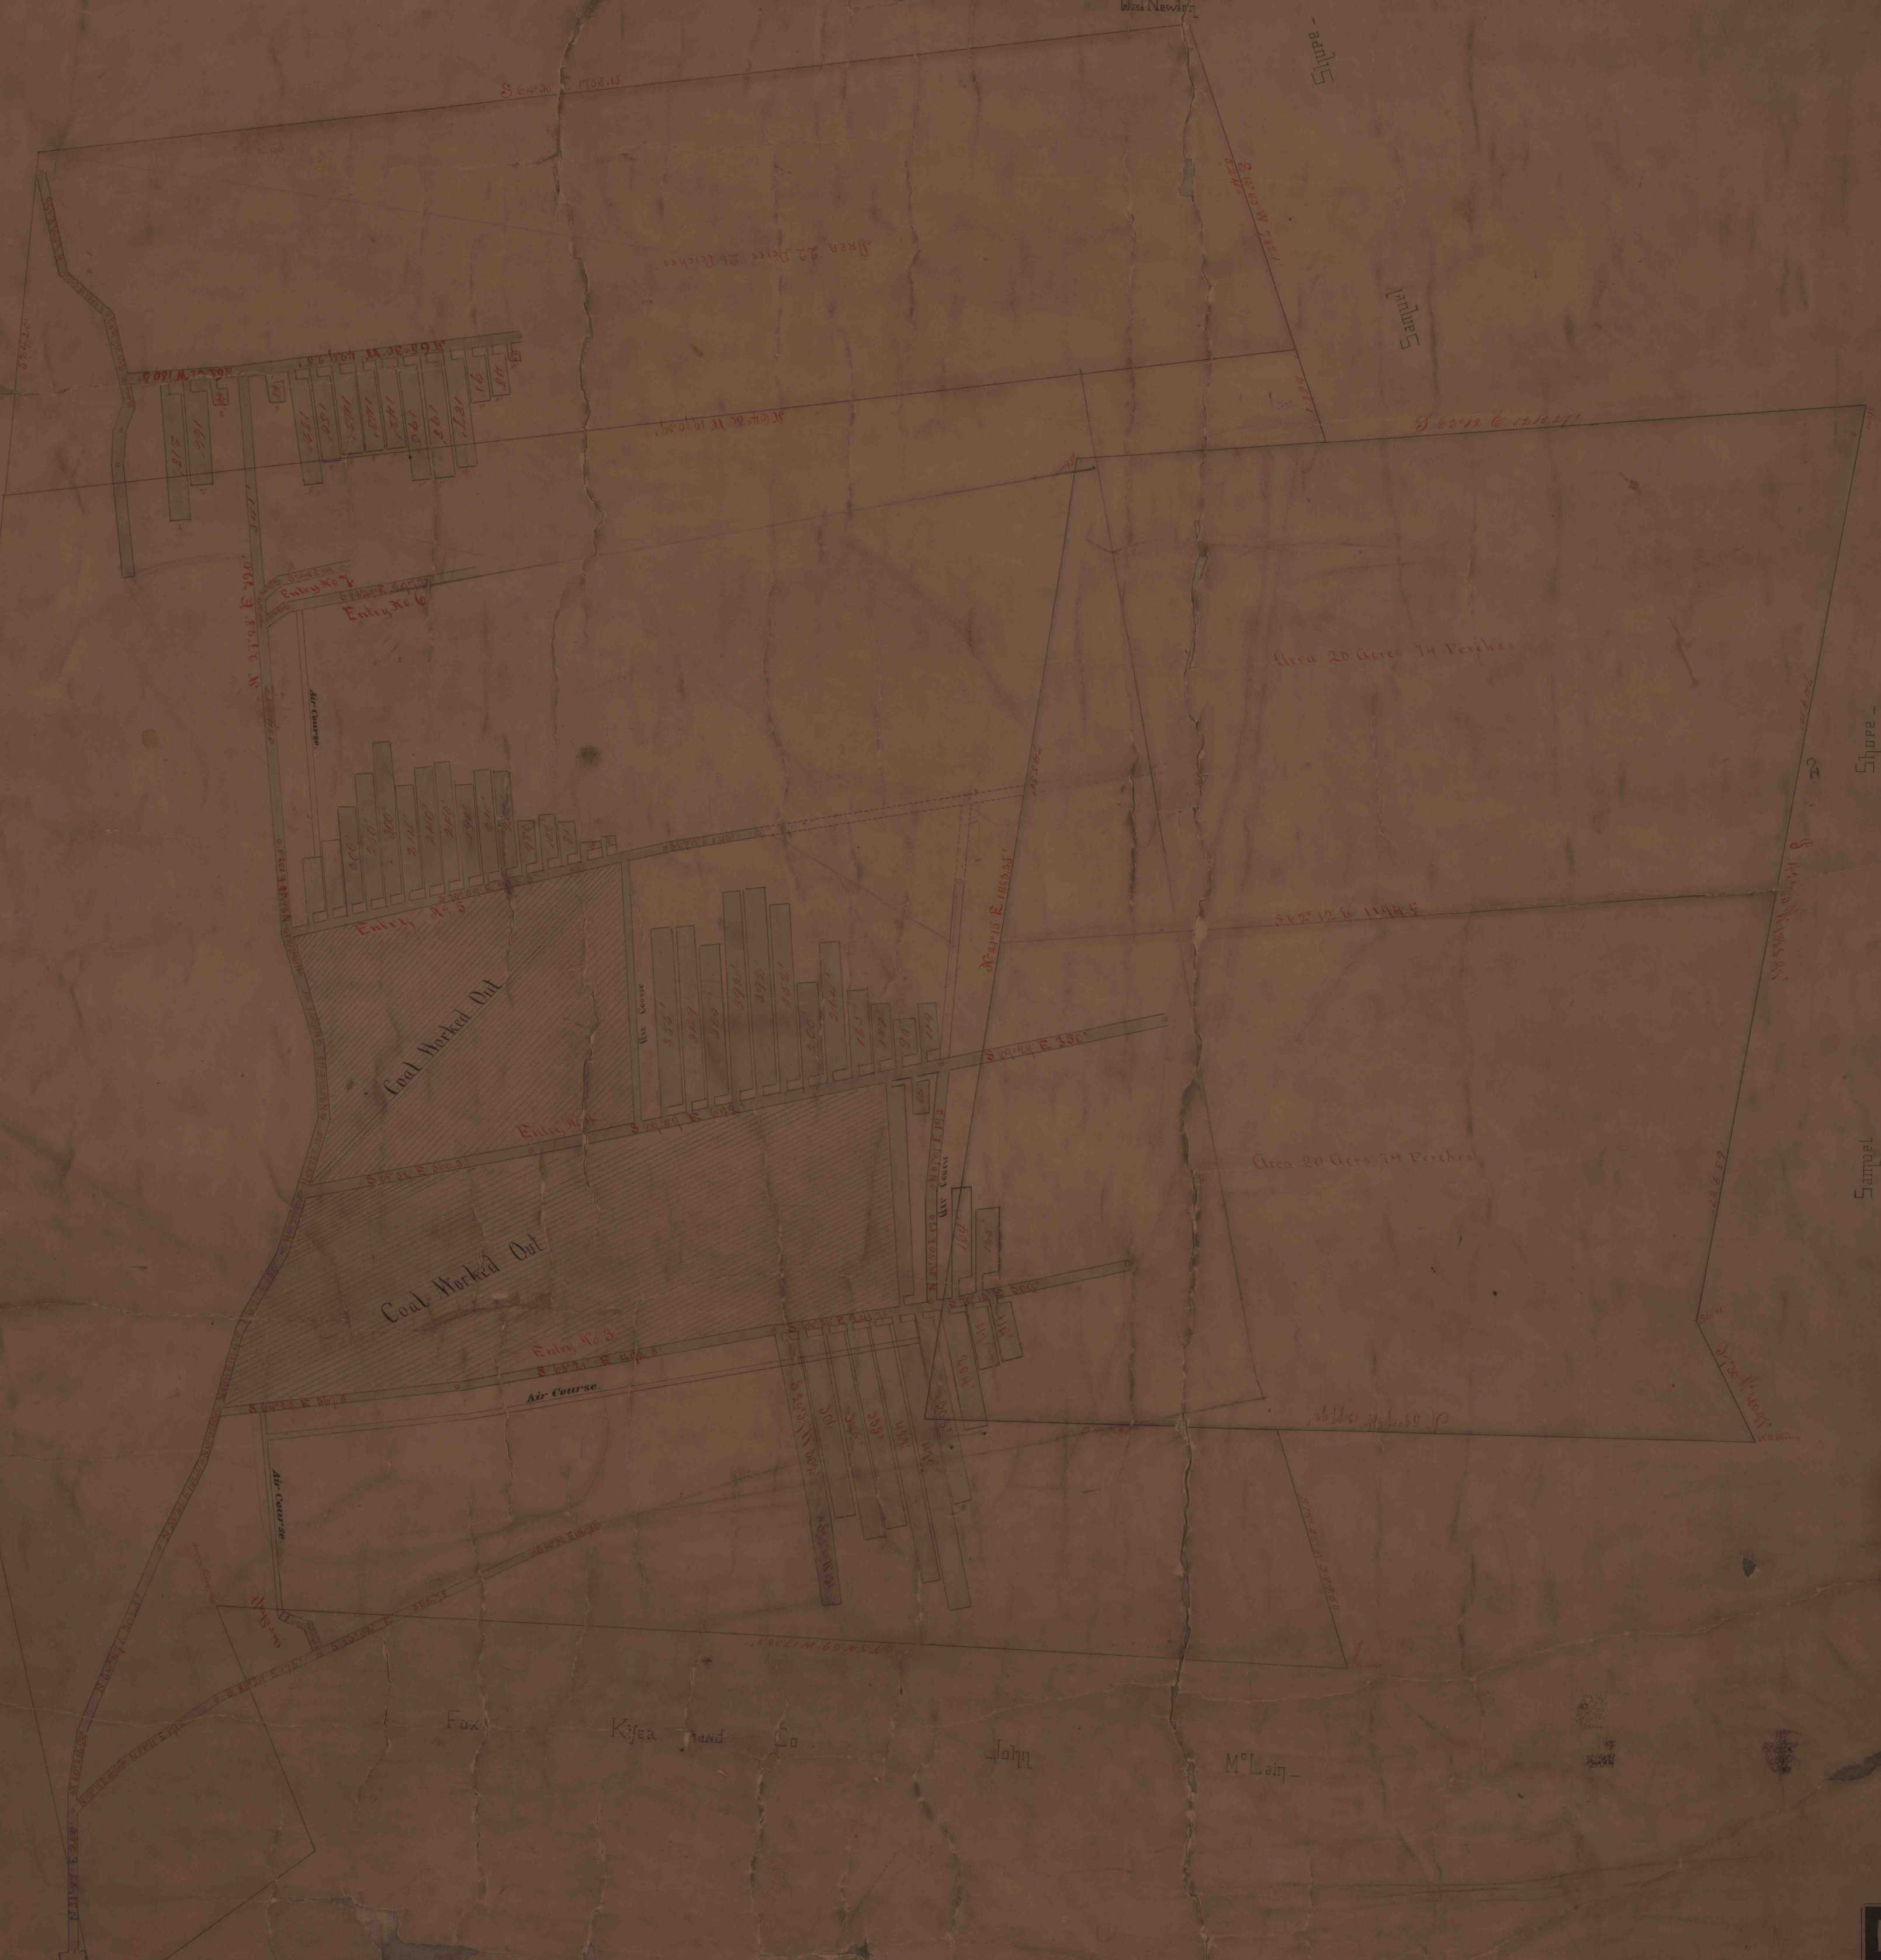

Fox Kifer and Co.

John

M<sup>c</sup>Lein