


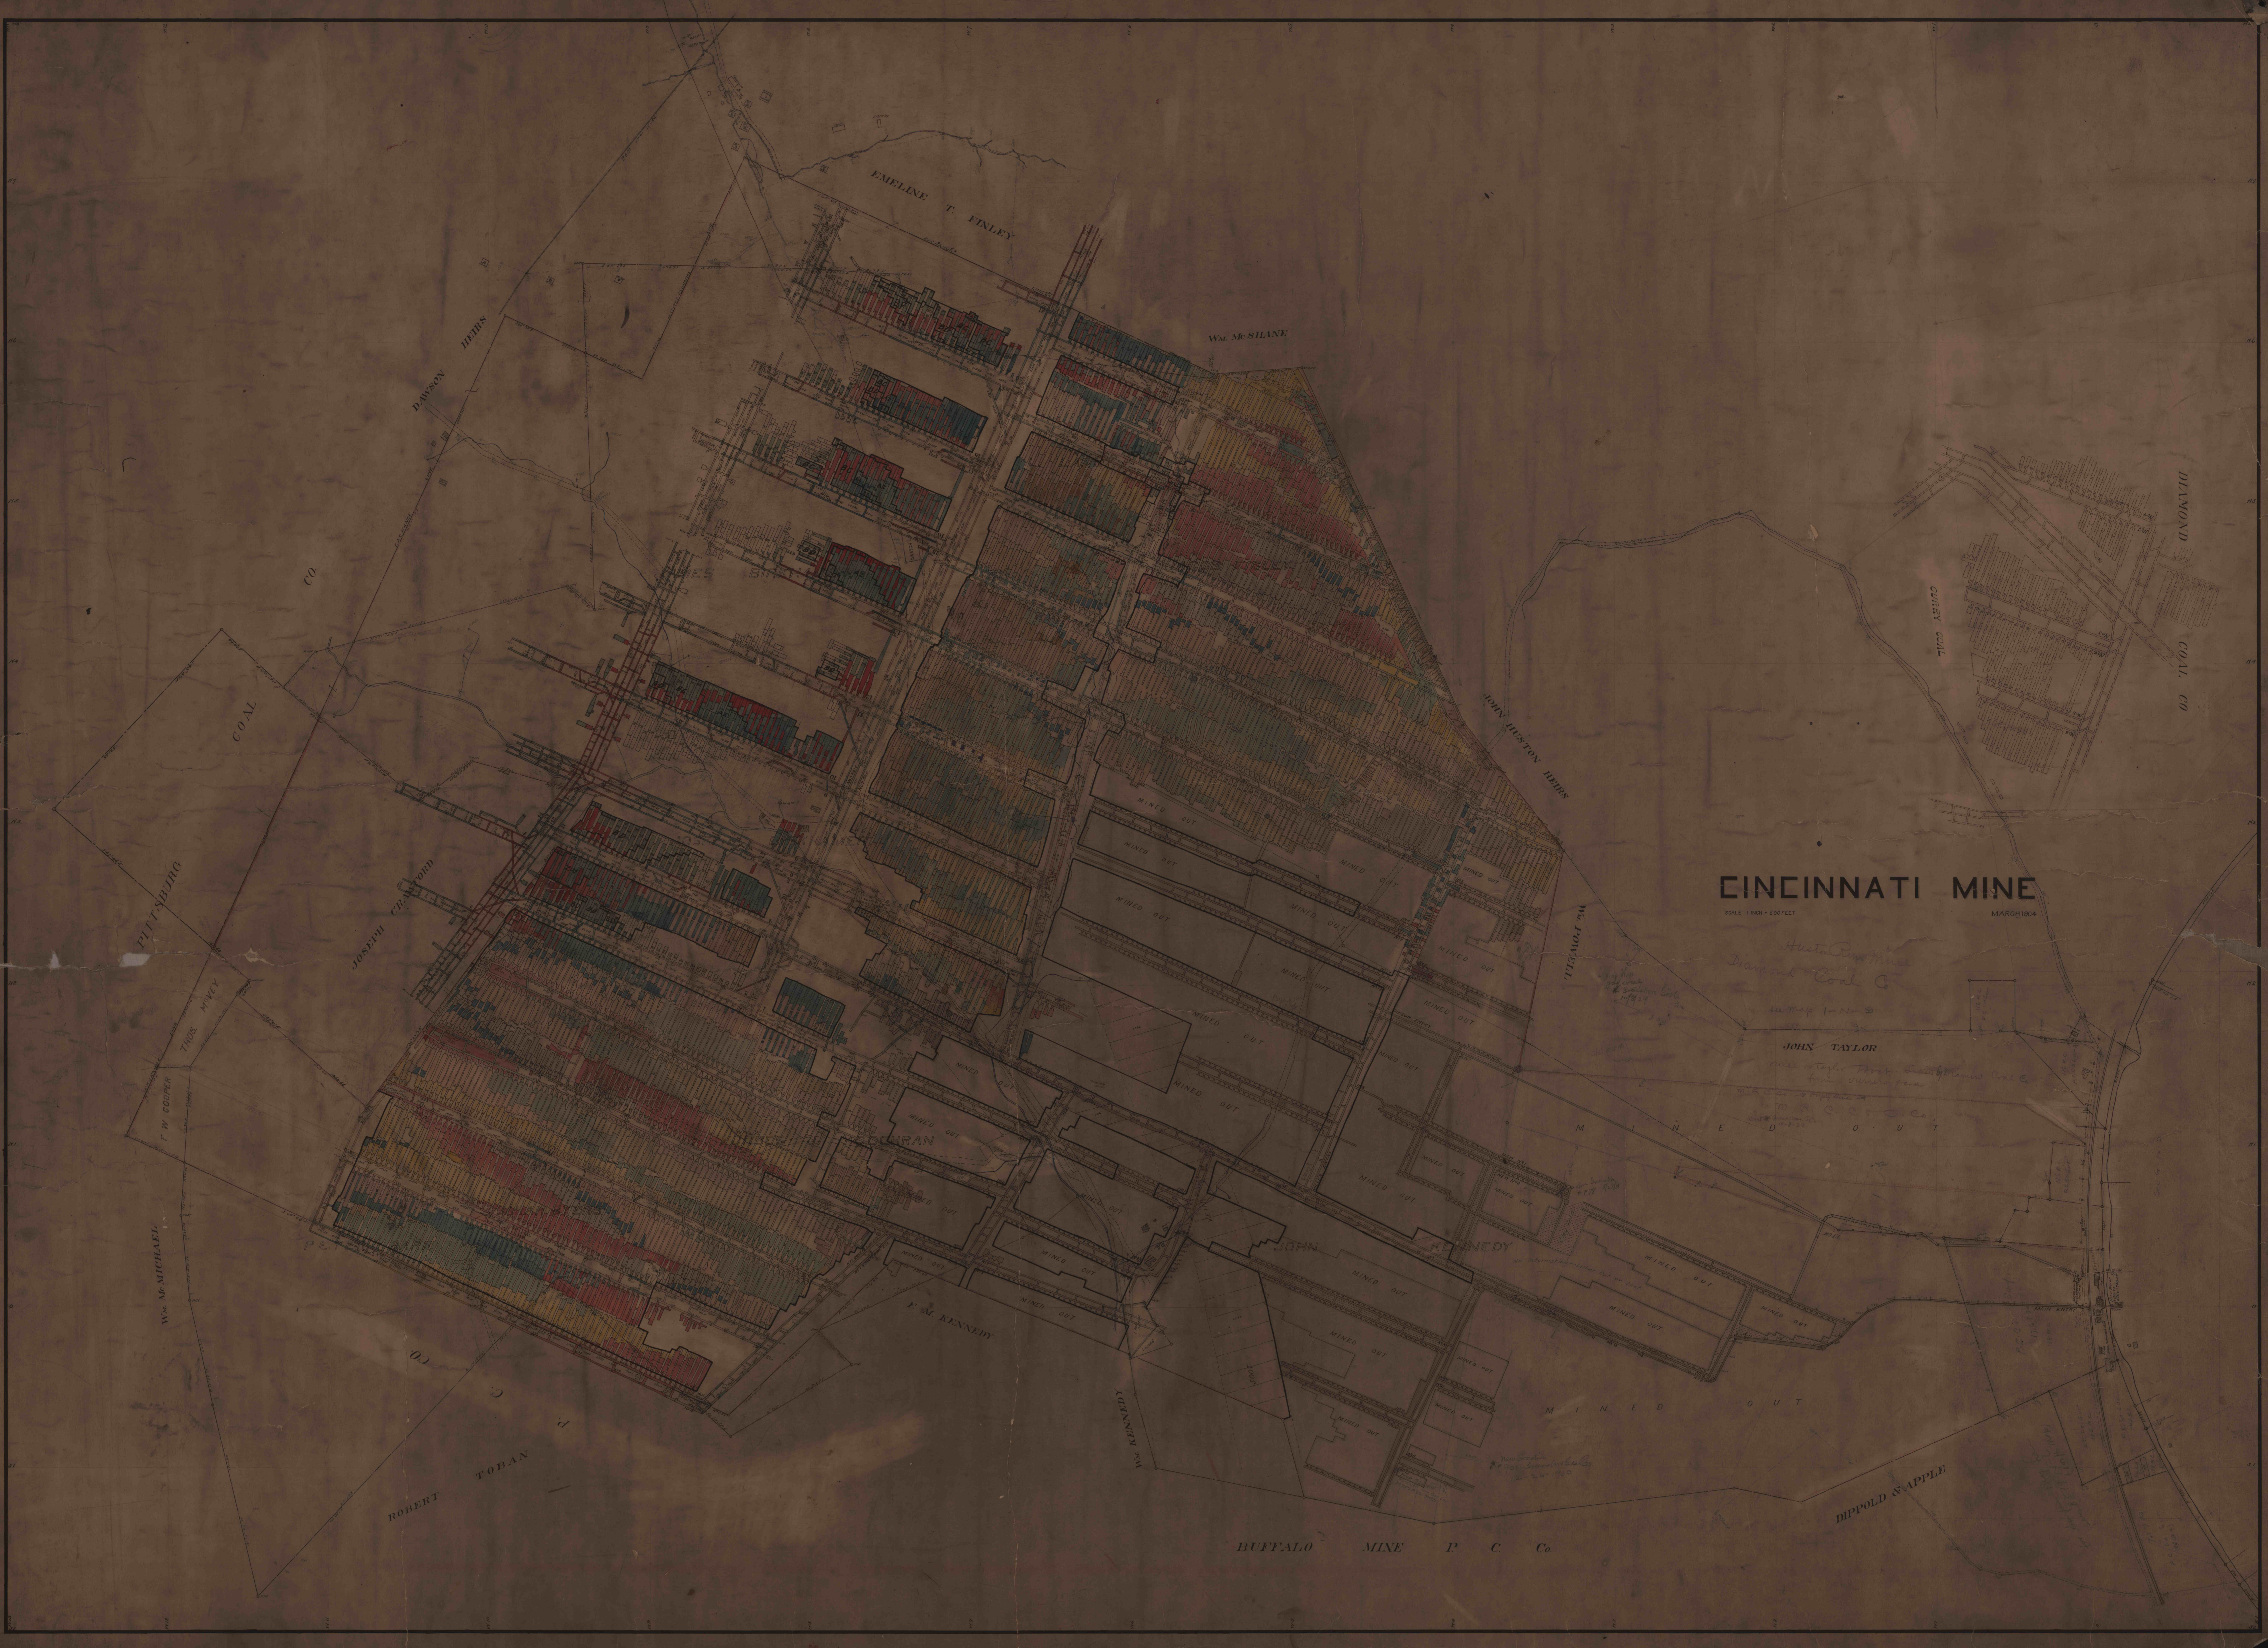

EMELINE T. FINLEY

Wm. McSHANE

JOHN HUSTON

CINCINNATI MINE

SCALE 1 INCH = 200 FEET

MARCH 1904

*Huston Mine
Diamond Coal Co.*

JOHN TAYLOR

*John Taylor Mine
Diamond Coal Co.*

M. C. C. C. C.

Mc POWNELL

JOHN KENNEDY

F. M. KENNEDY

ROBERT TORAN

BUFFALO MINE P. C. Co.

DIPPOLD & APPLE

DIAMOND COAL CO.

COAL

PITTSBURGH

F. W. COOPER

Wm. McMICHAEL

DAWSON

