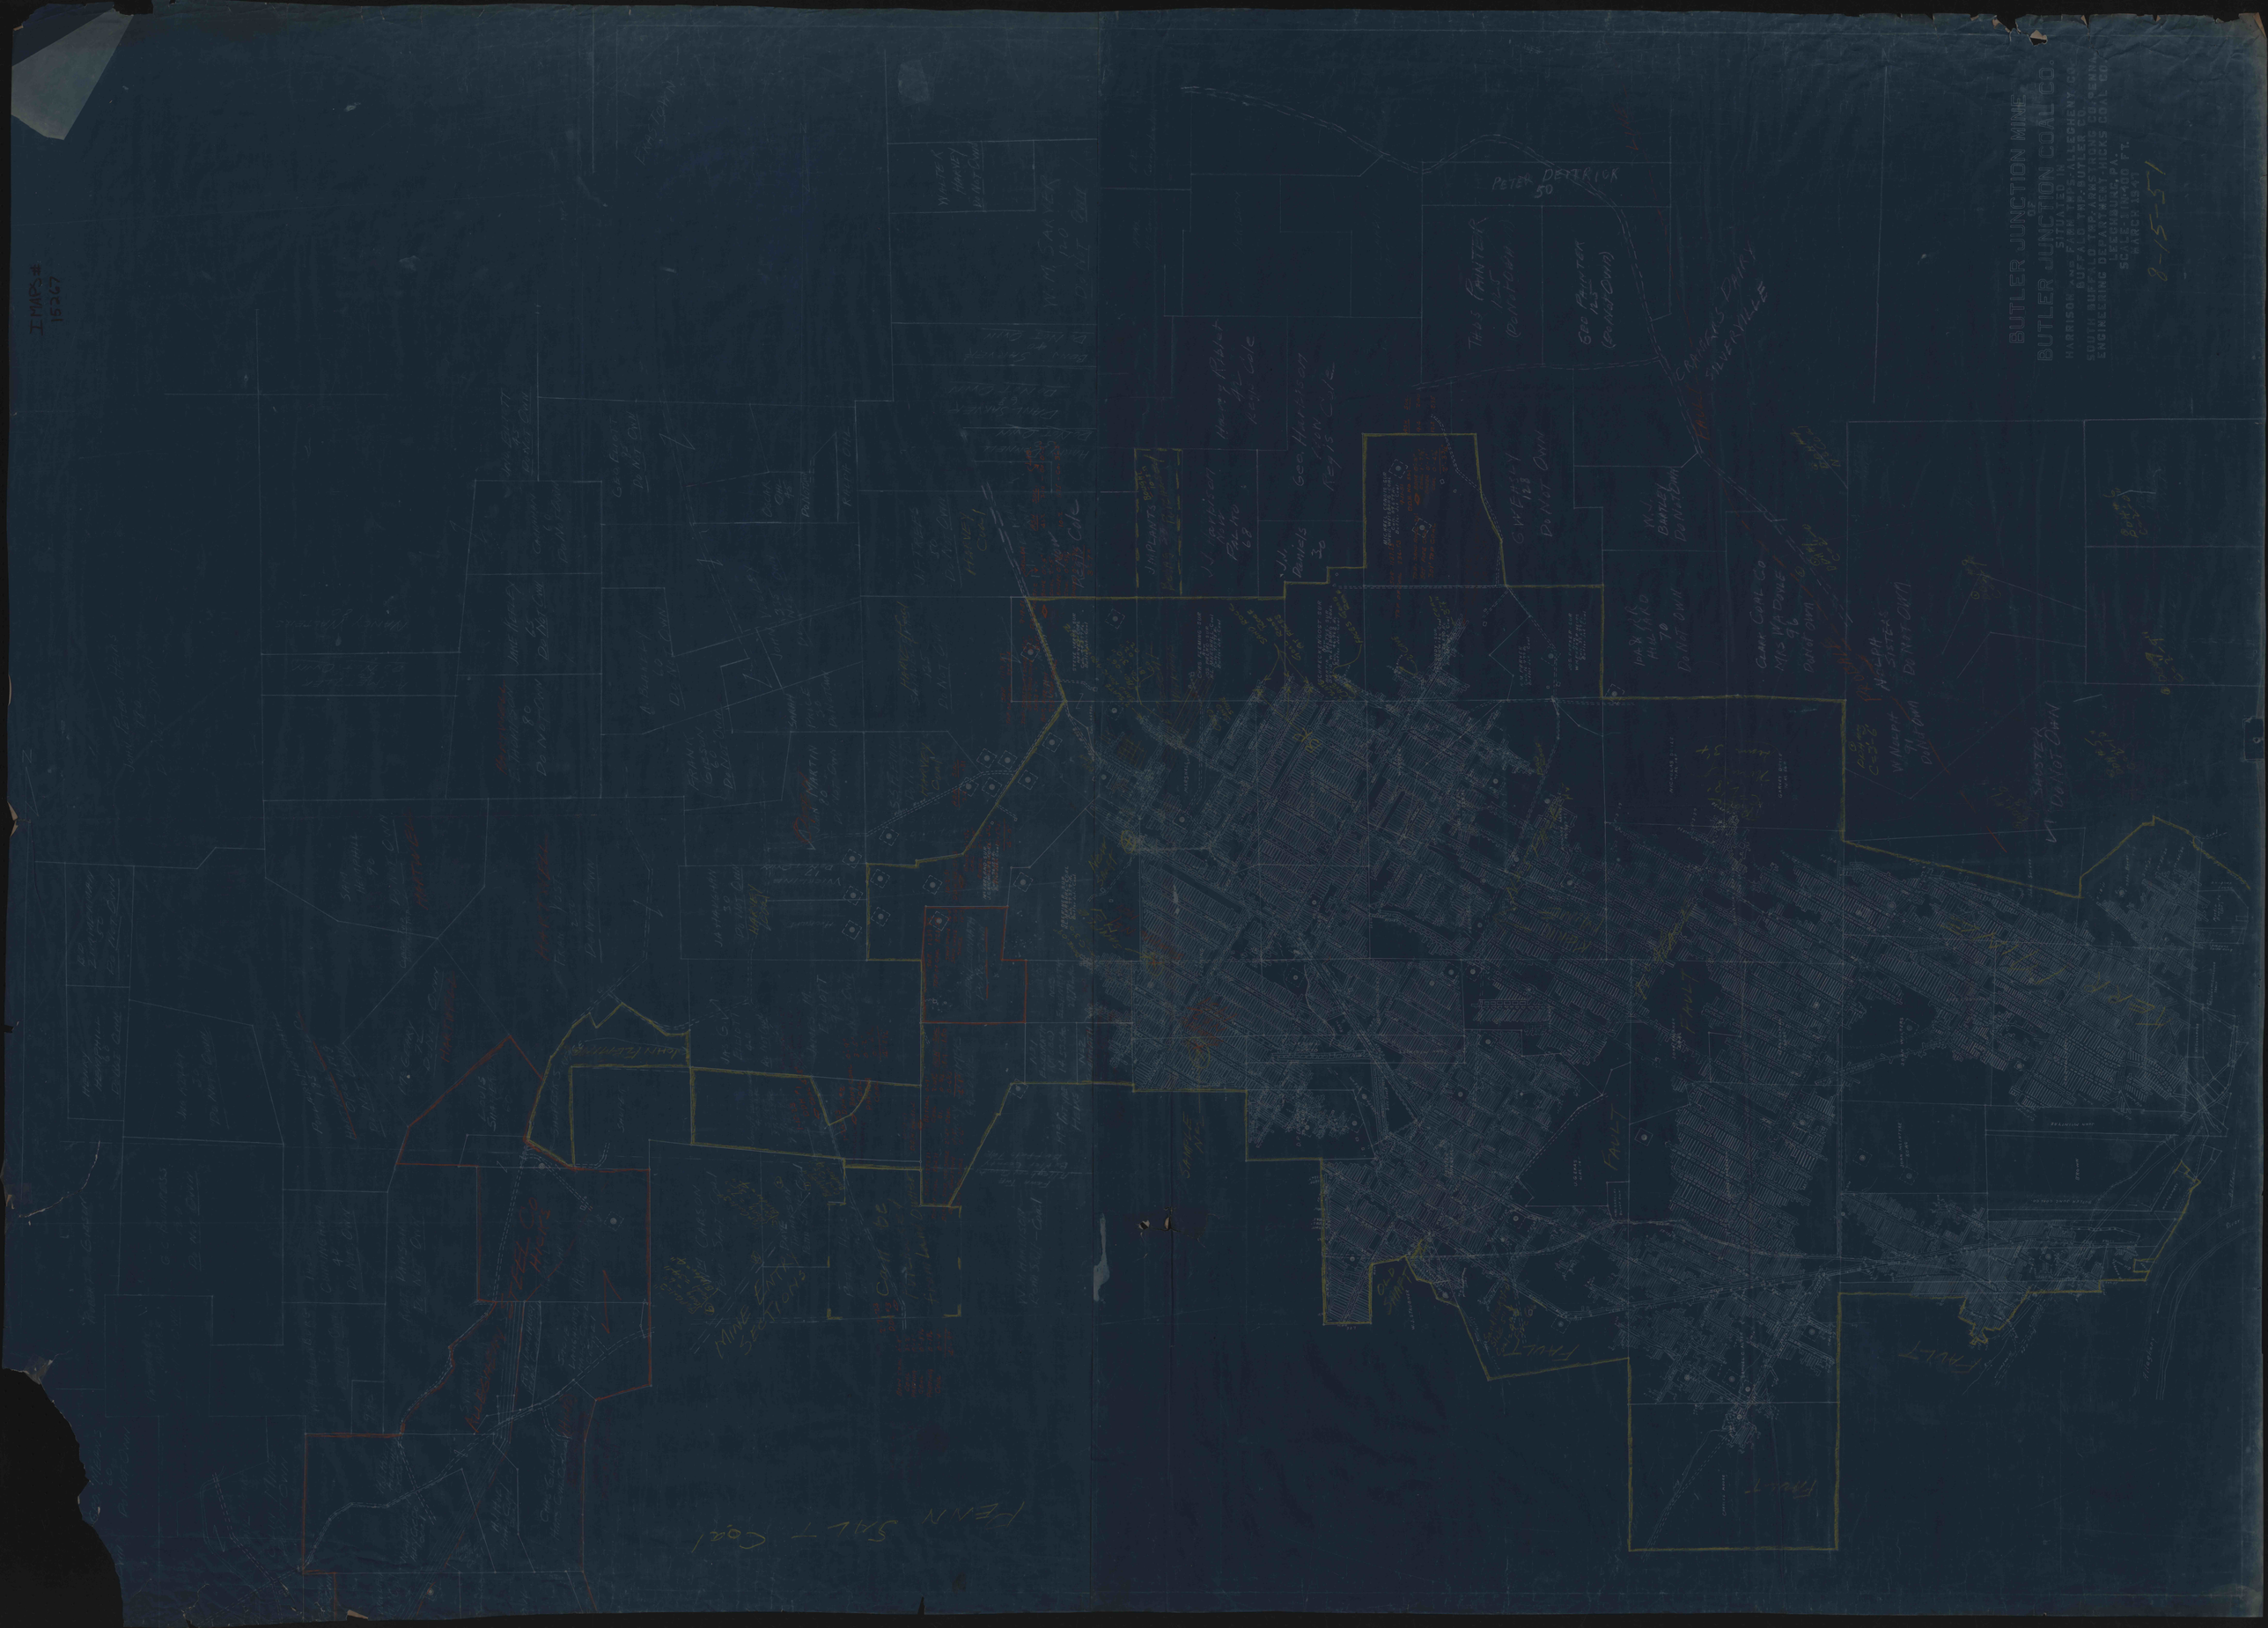
BUTLER JUNCTION MINE
OF
BUTLER JUNCTION COAL CO.
HARRISON AND BUFFALO TWPS.
SITUATED IN
SOUTH BUFFALO TWP. ARMSTRONG CO. PENNA.
ENGINEERING DEPARTMENT, HICKS COAL CO.
LEECHBURG, PA.
SCALE 1 IN. = 400 FT.
MARCH 1947
8-15-51
IMRS#
15267
PETER DETTRICK
50
THOS. PAINTER
1.7
(Not Owned)
GEO. PAINTER
1.25
(Not Owned)
CARNEGIE
SILVERVILLE
J.J. Pepper
Part No.
62
J.H.
Daniels
30
GEO. Harrison
Reps
G.W. Perry
1.25
Do Not Own
Mrs. Butler
Do Not Own
Clark Coal Co.
1915 Mc Cune
96
Do Not Own
Mrs. Mc Cune
70
Do Not Own
Sister's
Do Not Own
Sister's
Do Not Own
Willert
Do Not Own
Mine Entry
Sections
Fault
Fault
Fault
Fault
Penn Salt Coal