


BLAIRSVILLE-BOLIVAR
DRILLING
NACCO & R.D.

LEGEND
TT STATION
BM
DDH

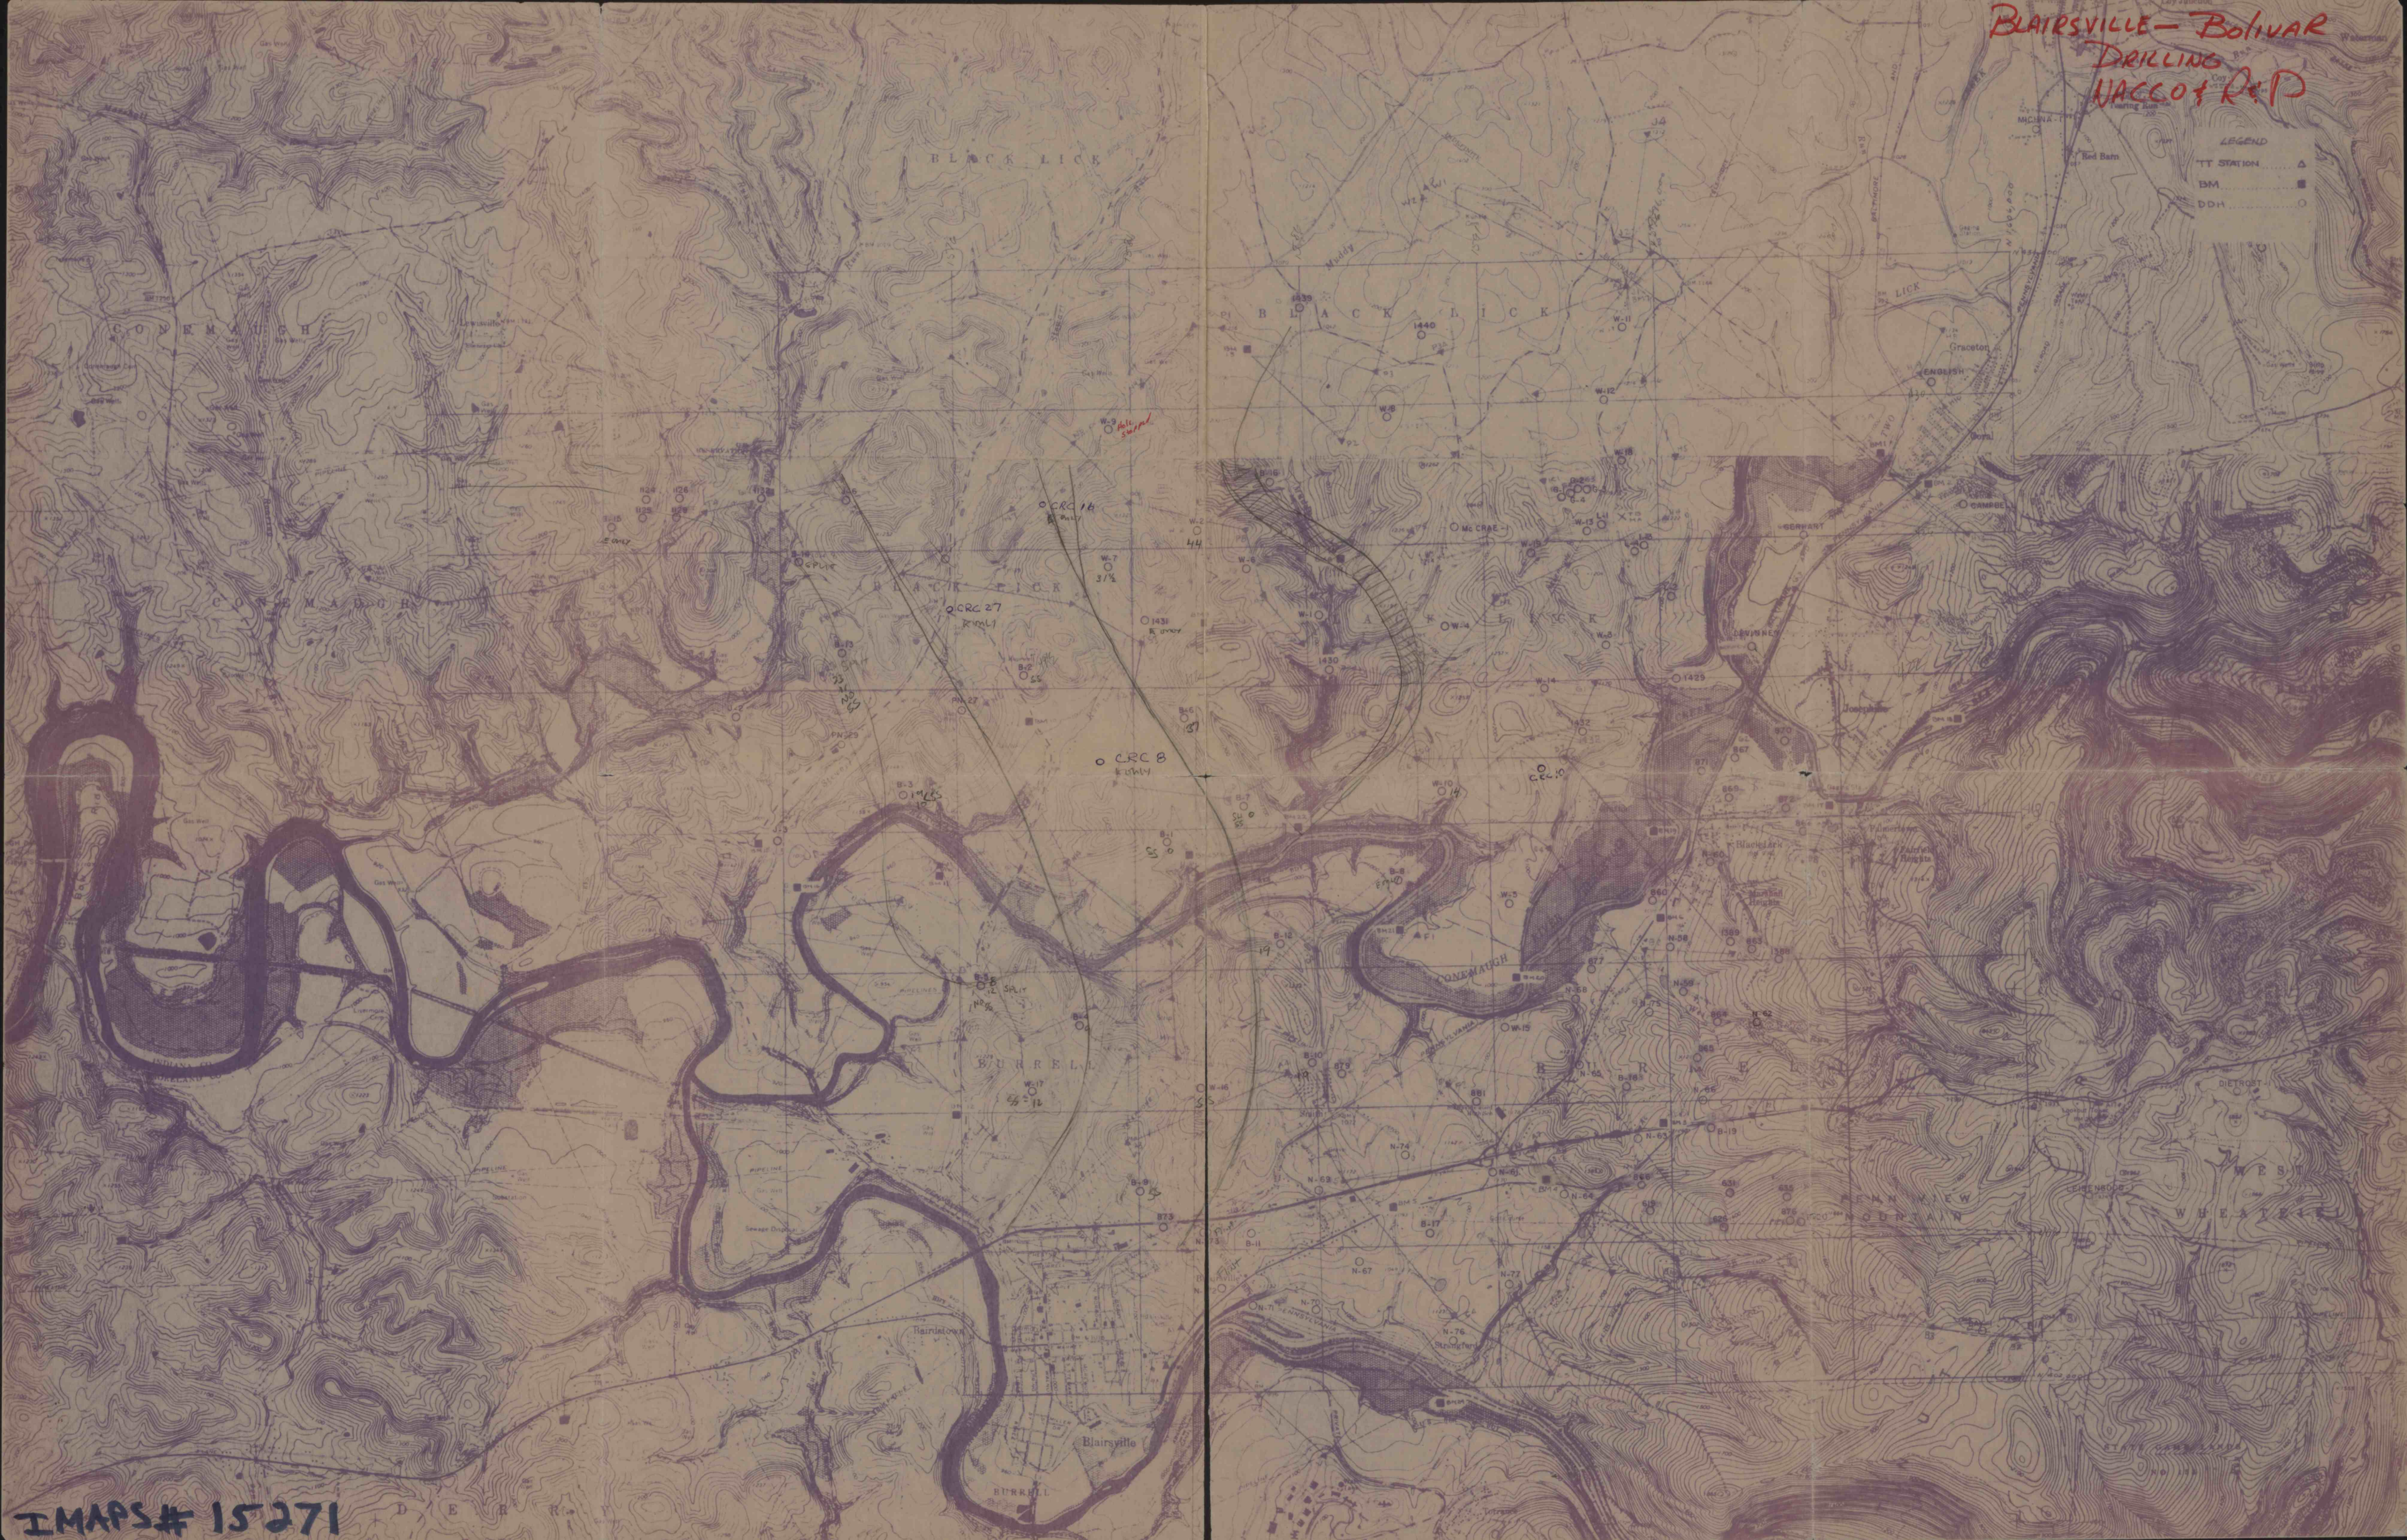

IMAPS# 15271