NOTE: ALL CROSS SUPPORTS ARE TO BE BOLTED IN PLACE

SCALE 1/2" = 1'

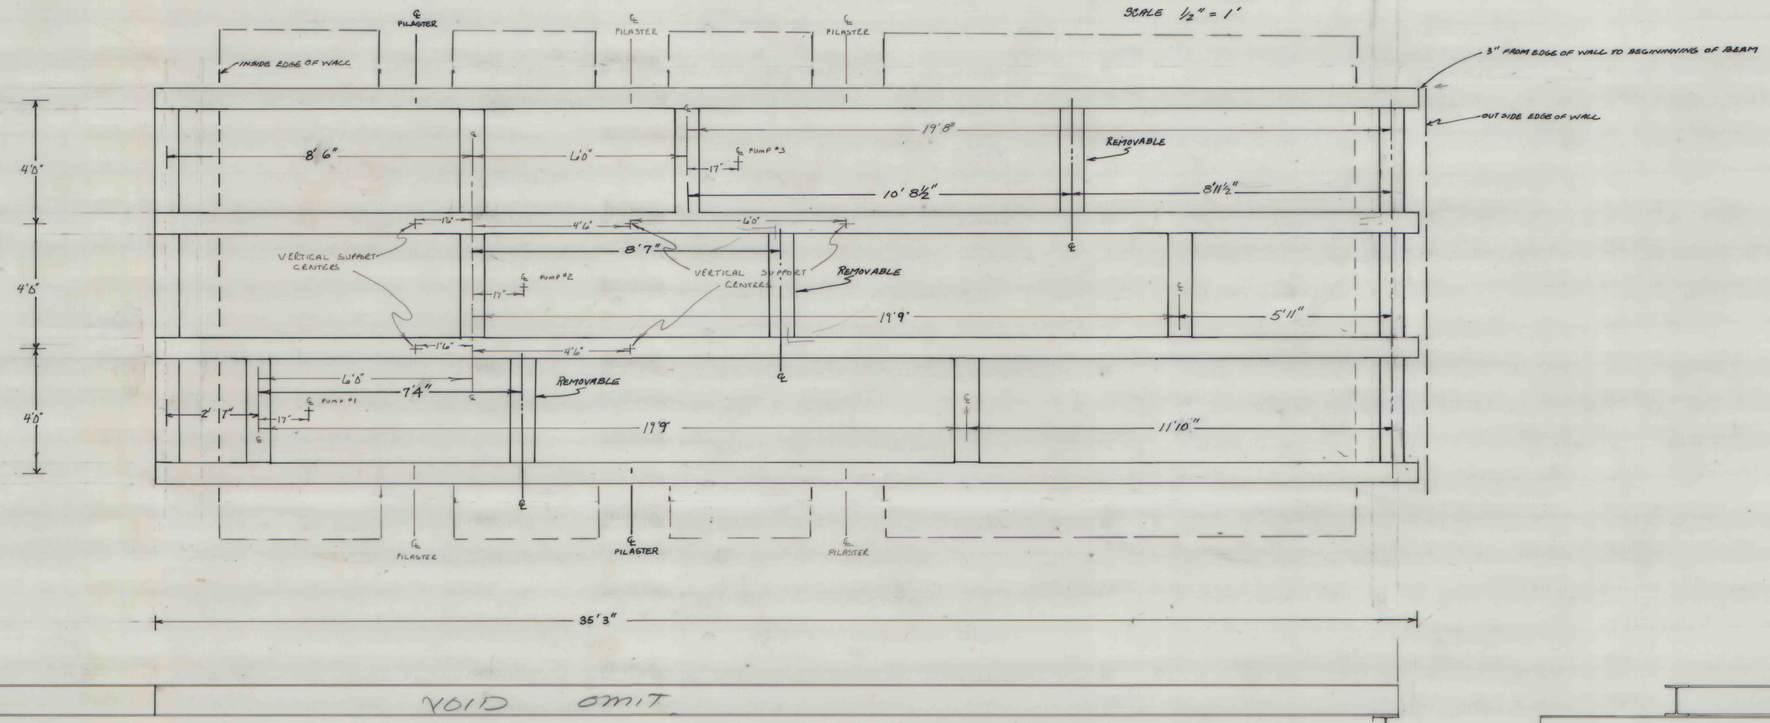

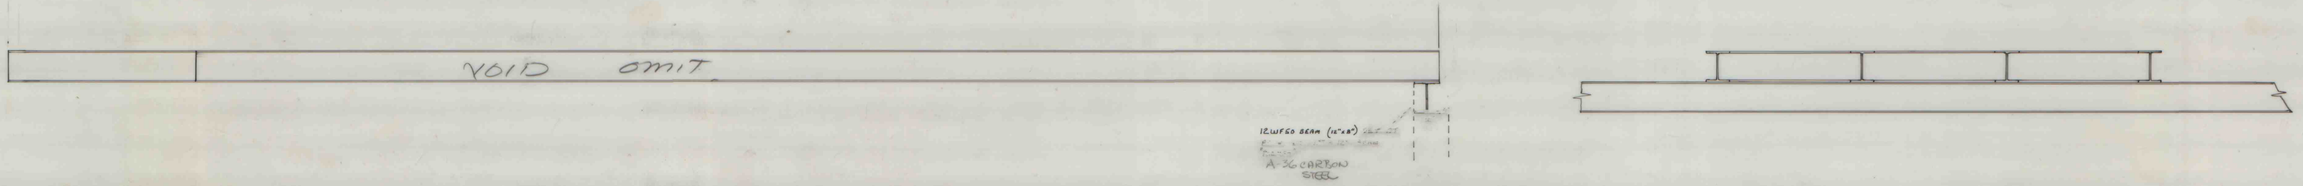

HELVETIA COAL CO. ENGINEERING DEPT., INDIANA, PA.	
PLATFORM DETAIL LUCERNE NO. 6 MINE SUMP	
MADE BY M. D. S.	SCALE 1/2" = 1'
TRACED BY	DATE 4/17/84
CHECKED BY	NO.

IMAPS # 15301

A02268