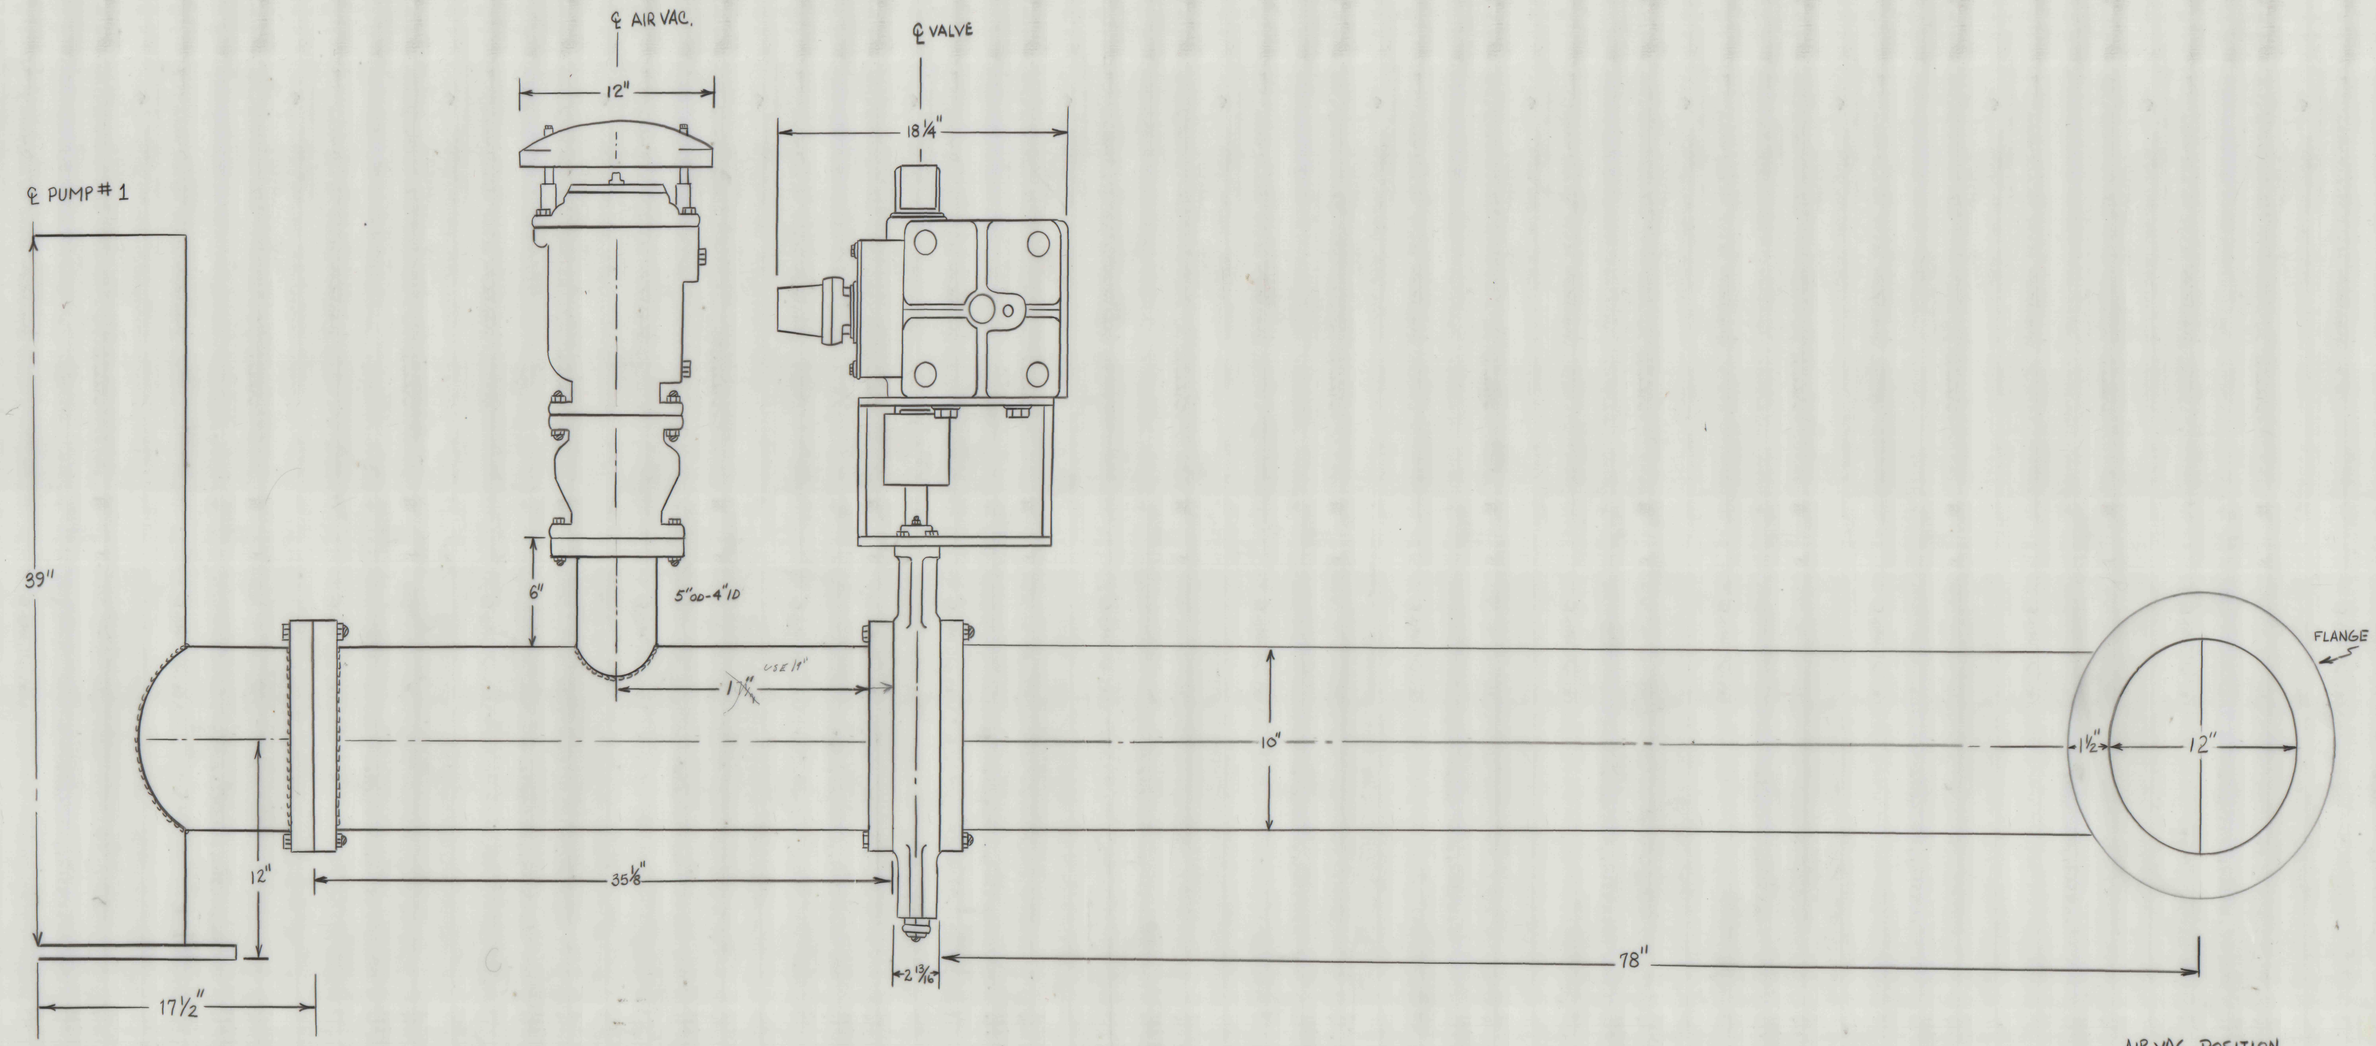

AIR VAC POSITION
#1 PUMP
SCALE 1/4" = 1"

IMAPS #15303