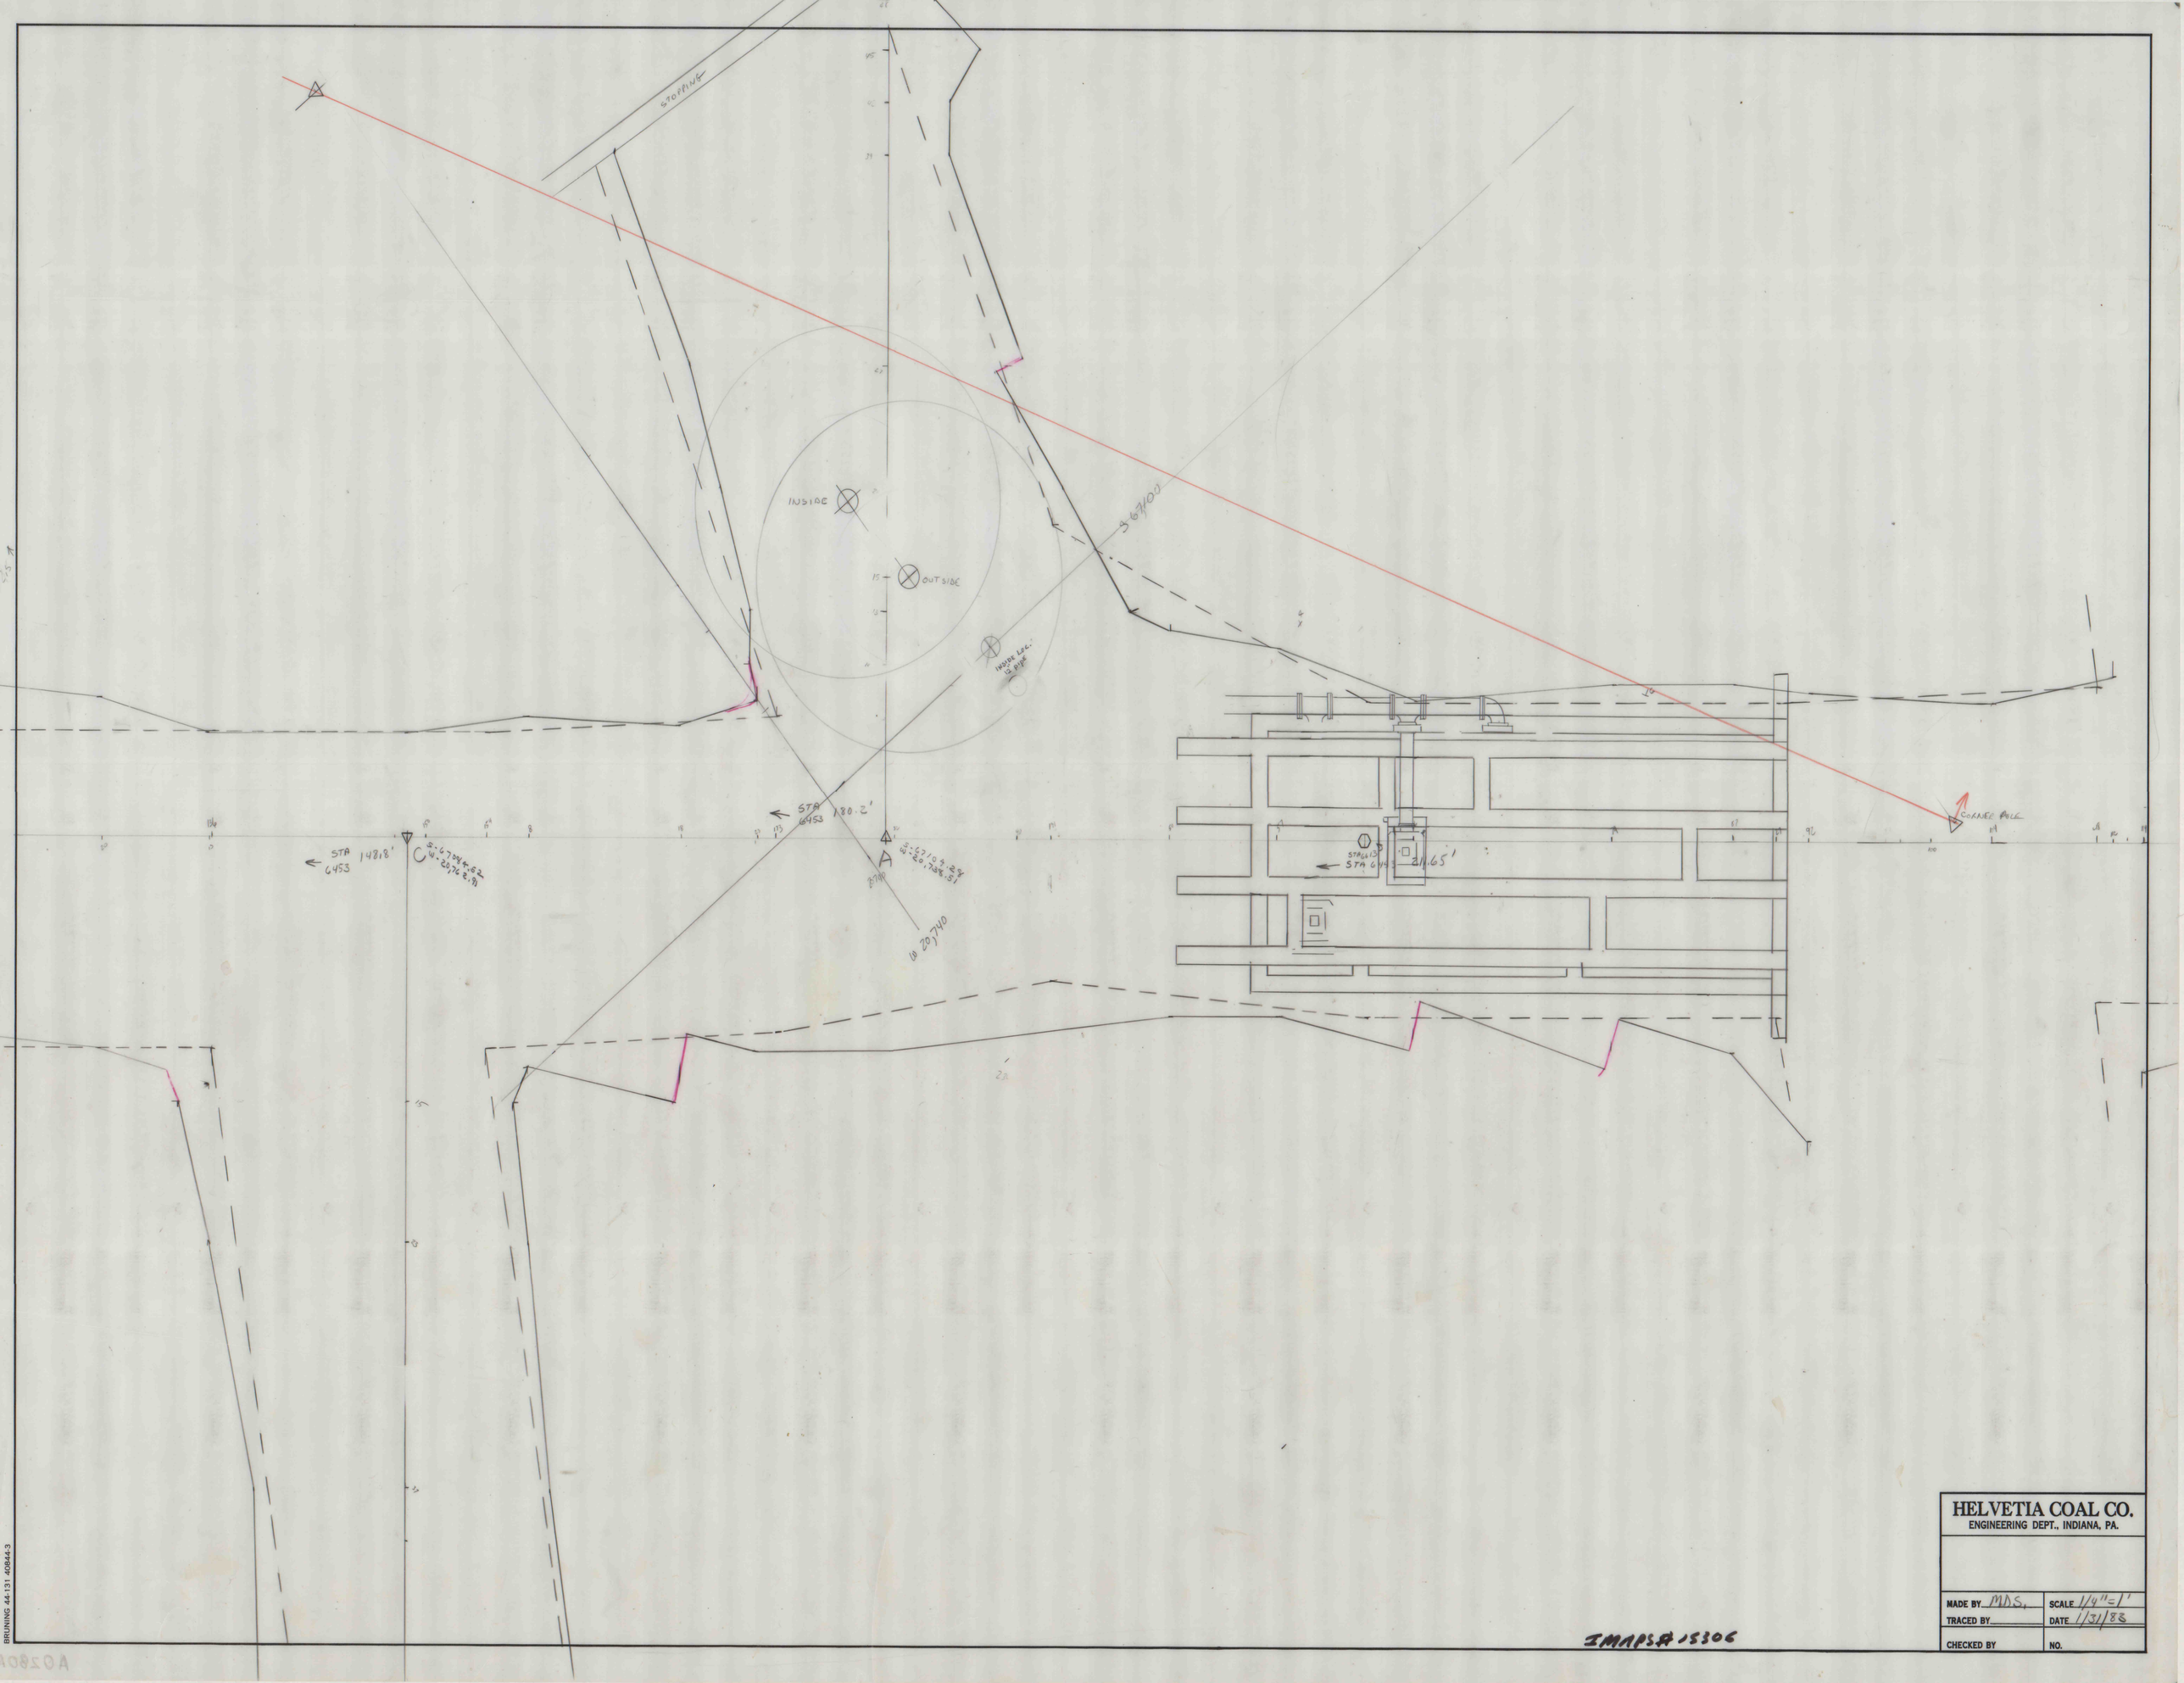

HELVETIA COAL CO.
ENGINEERING DEPT., INDIANA, PA.

MADE BY MDS.	SCALE 1/4"=1'
TRACED BY	DATE 1/31/88
CHECKED BY	NO.

IMAPS#15306

BRUNING 44-131 40844-3