



CONTROMATICS 800 SPRING
RETURN ACTUATOR

FRONT VIEW

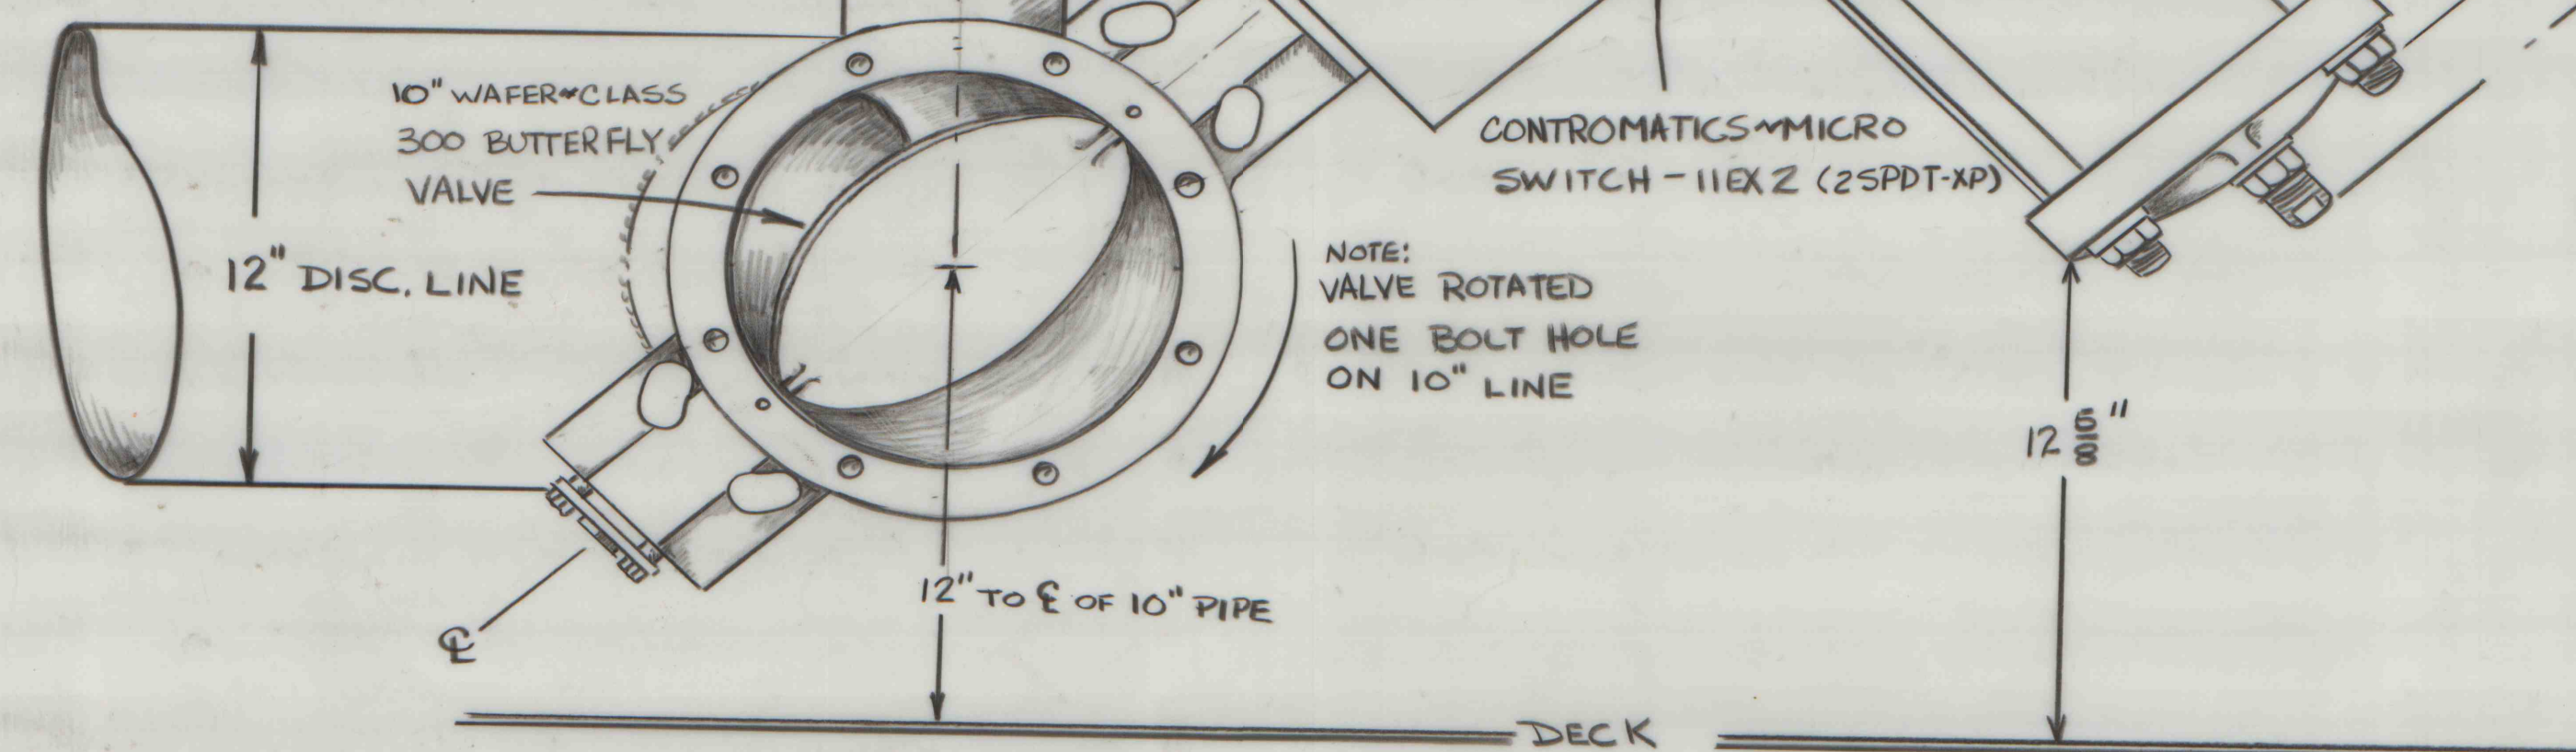

SIDE VIEW

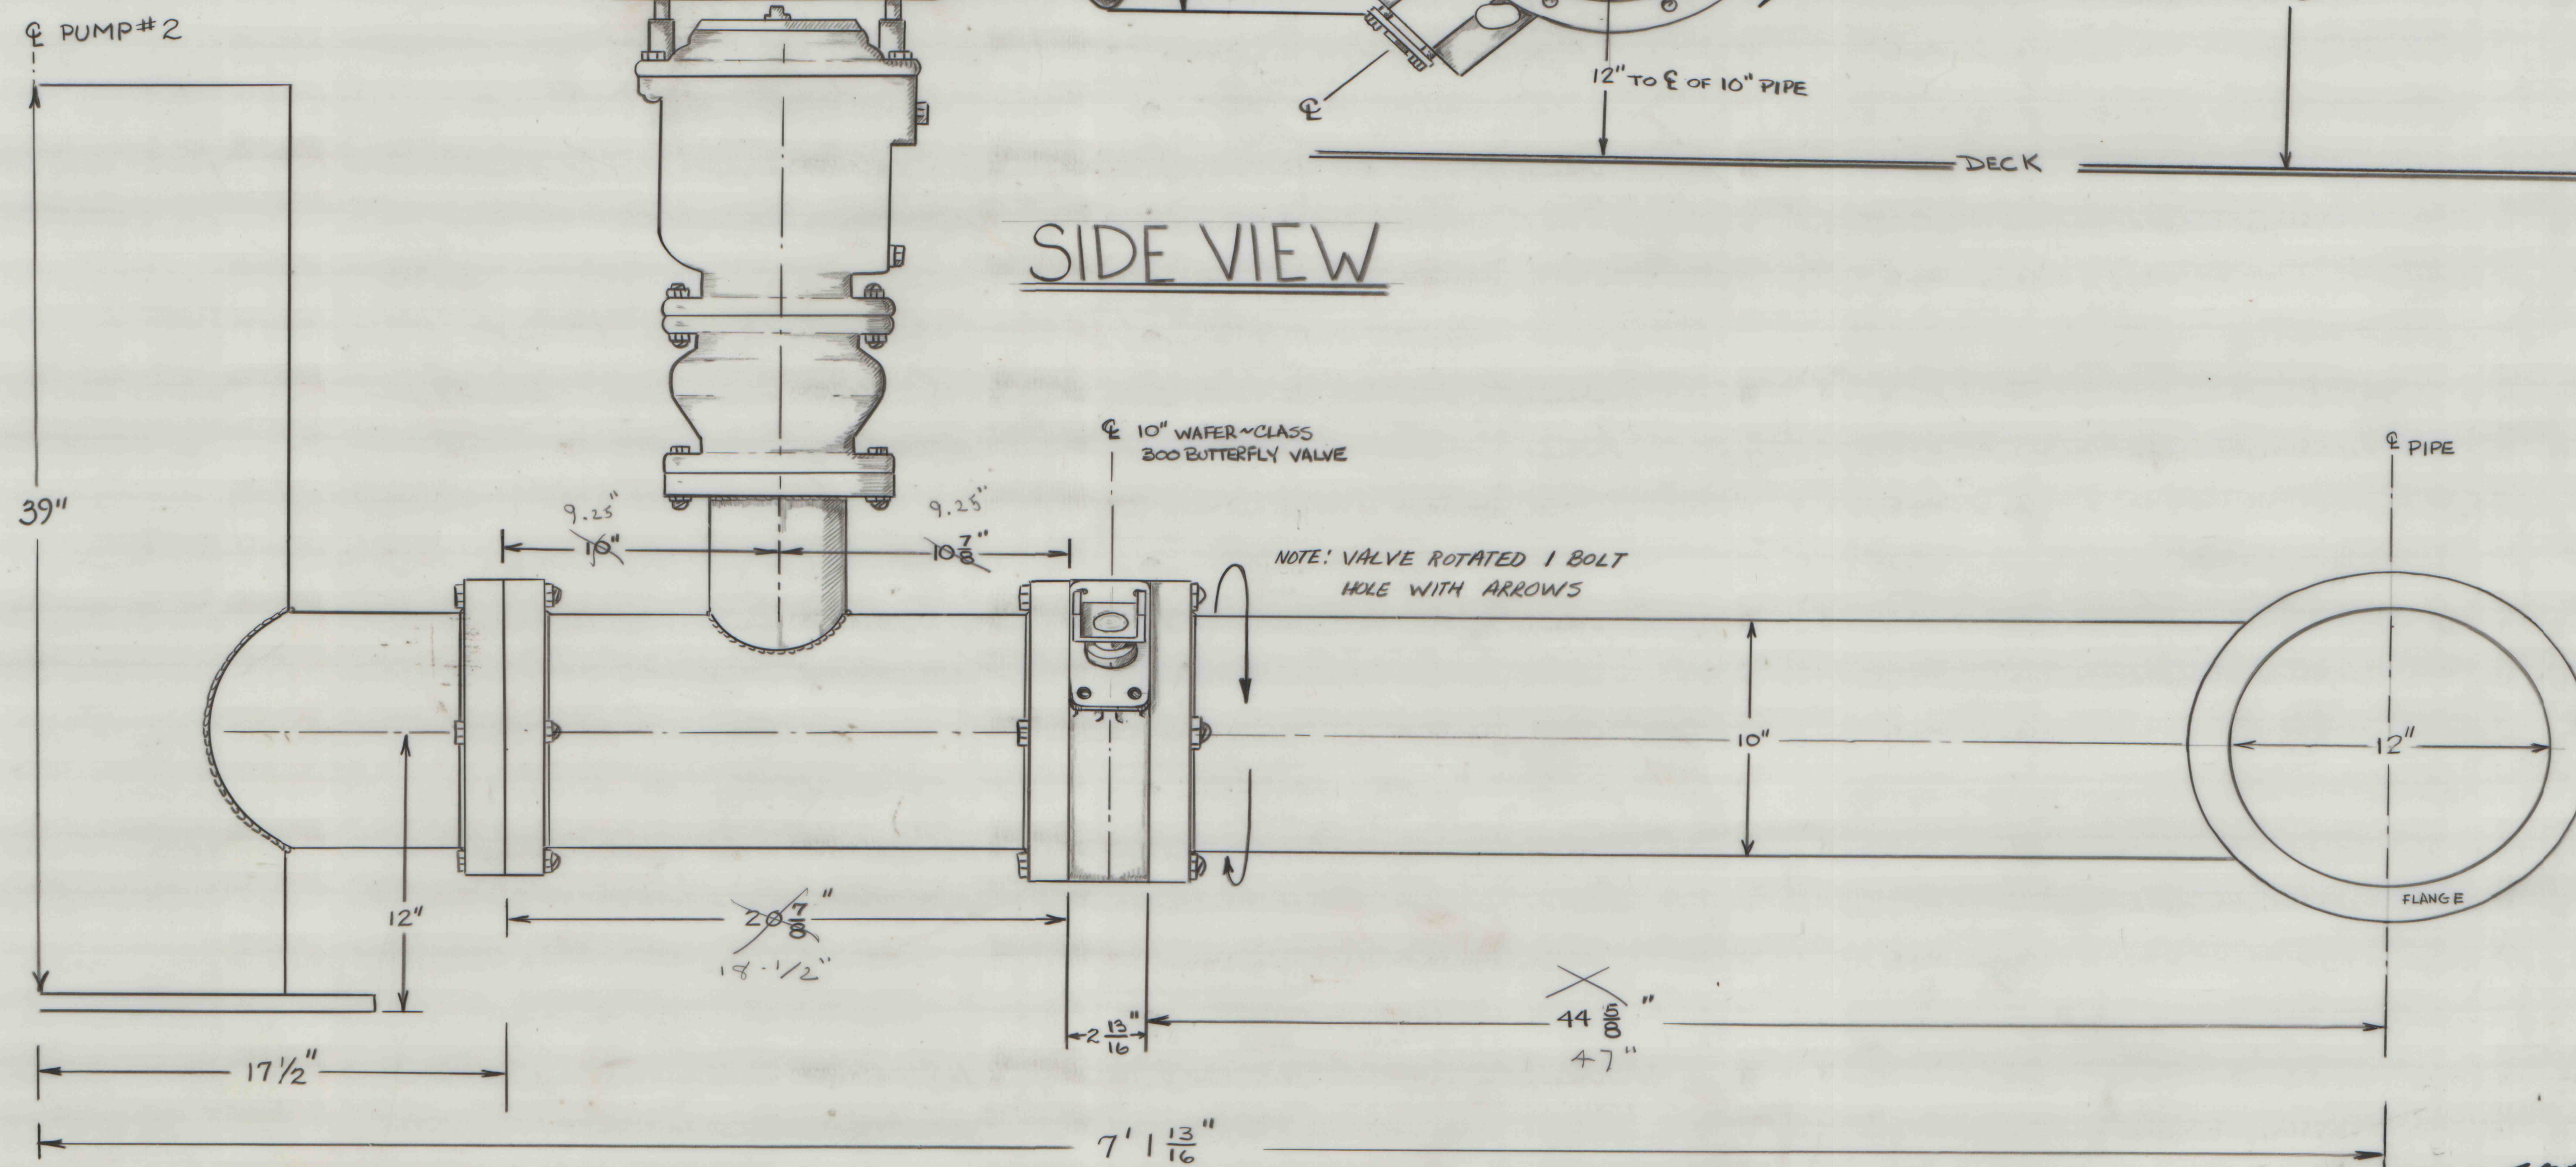

AIR VAC & CLOSING ACTUATOR,
VALVE POSITION, SPOOL & TEE
DIMENSIONS.
SCALE: 1/4" = 1" 6-26-86 J.R.T.

2744PSH 1534

5750A