
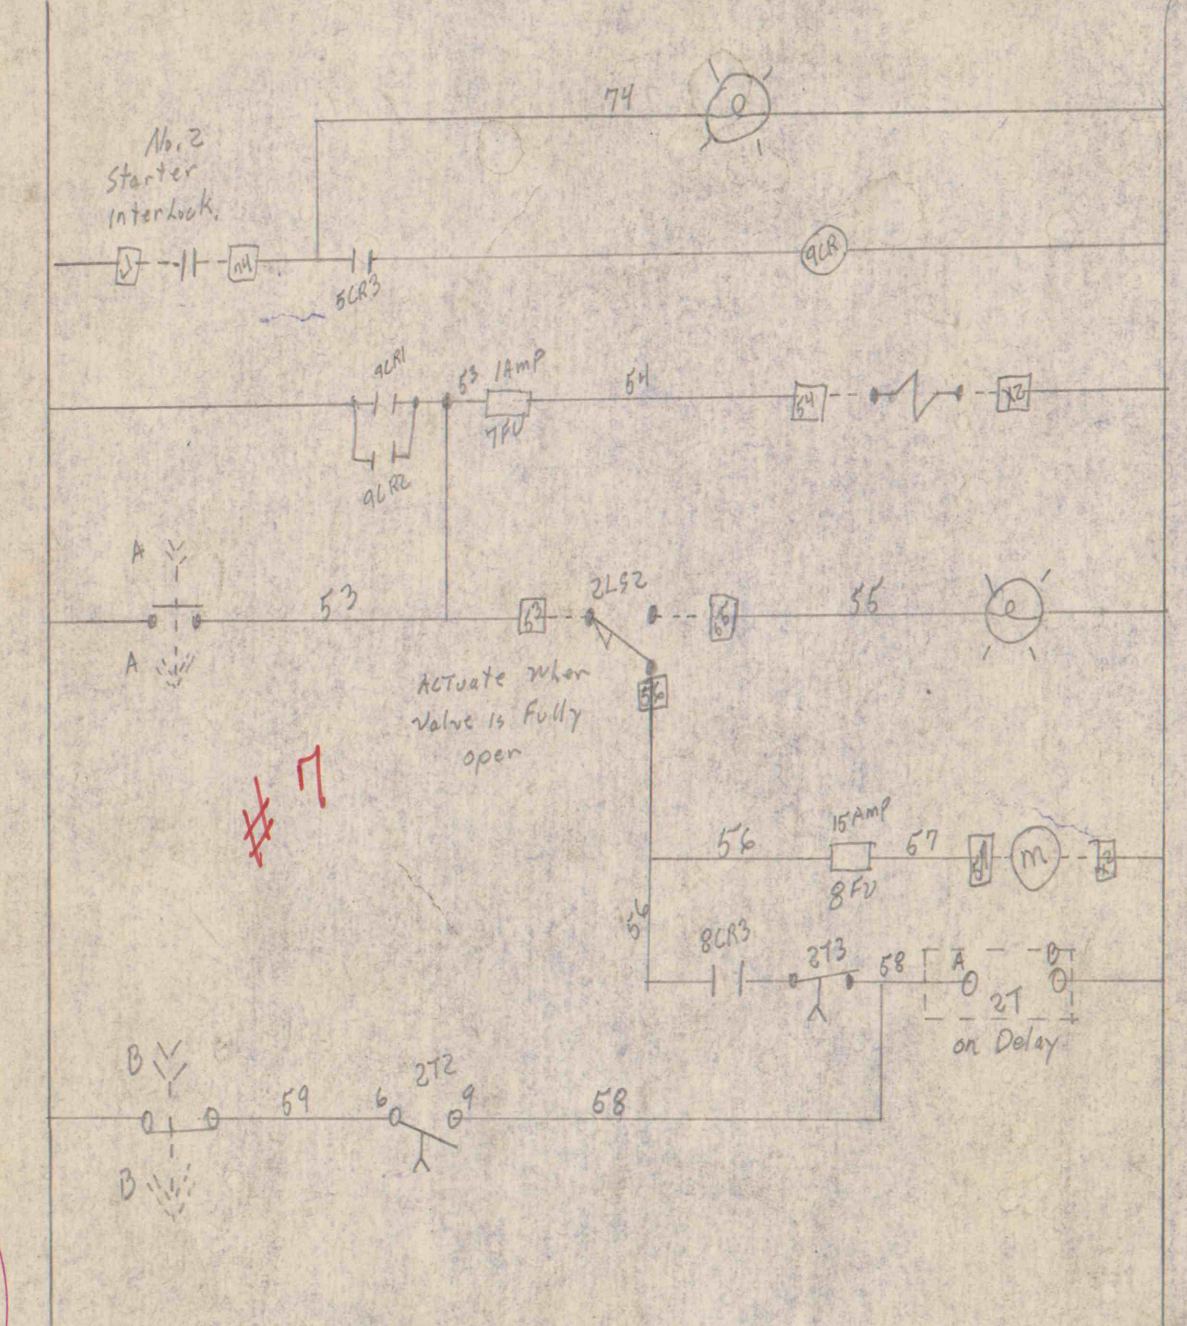
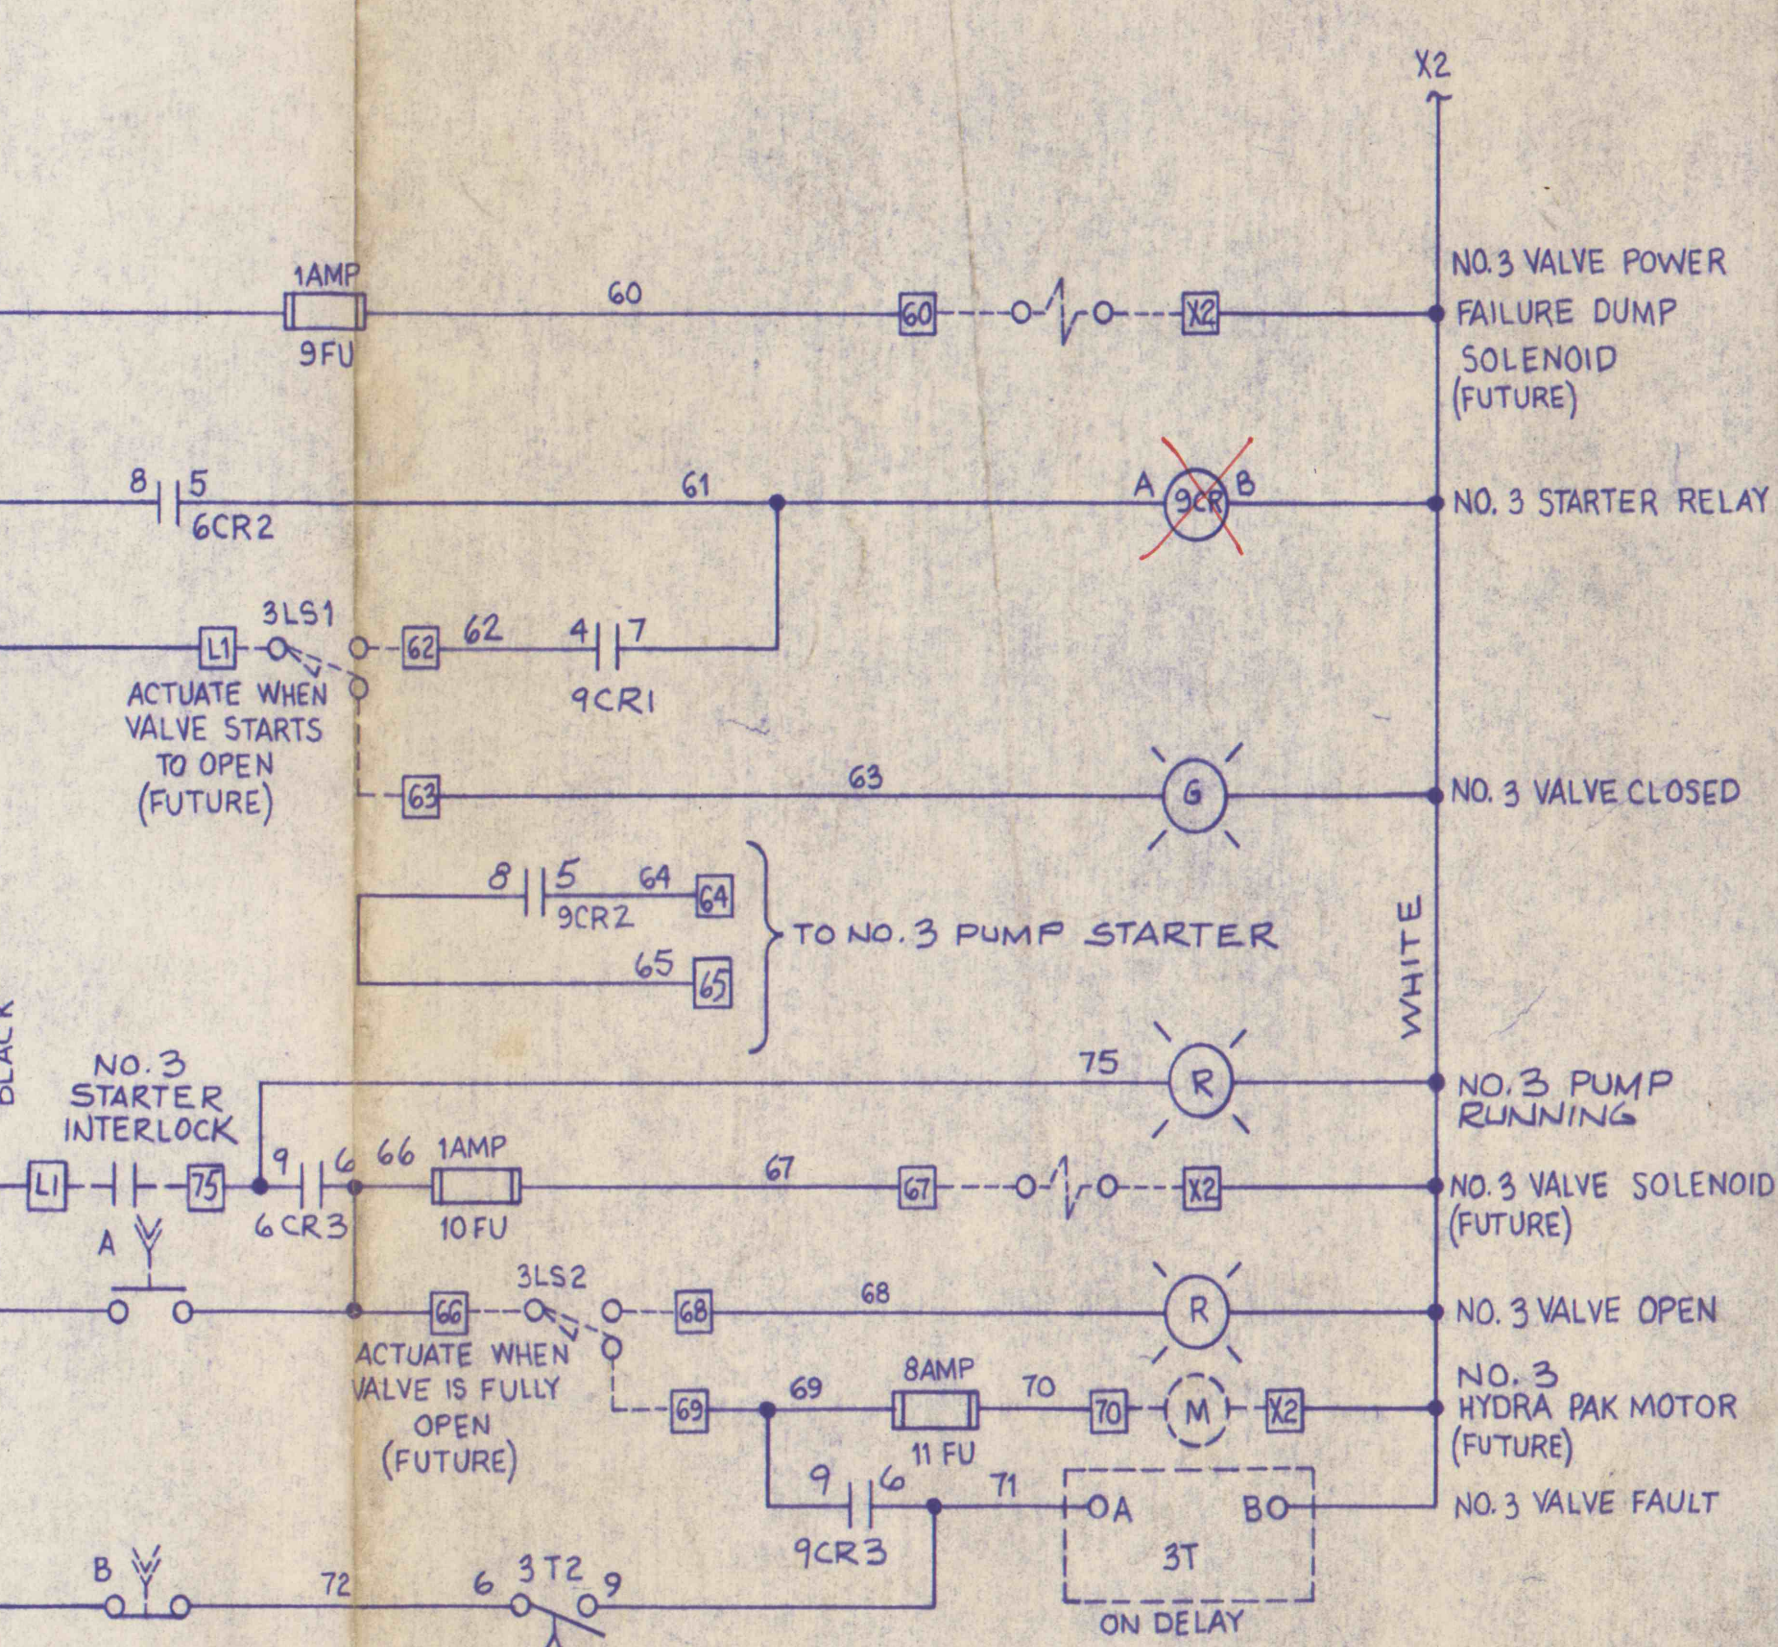
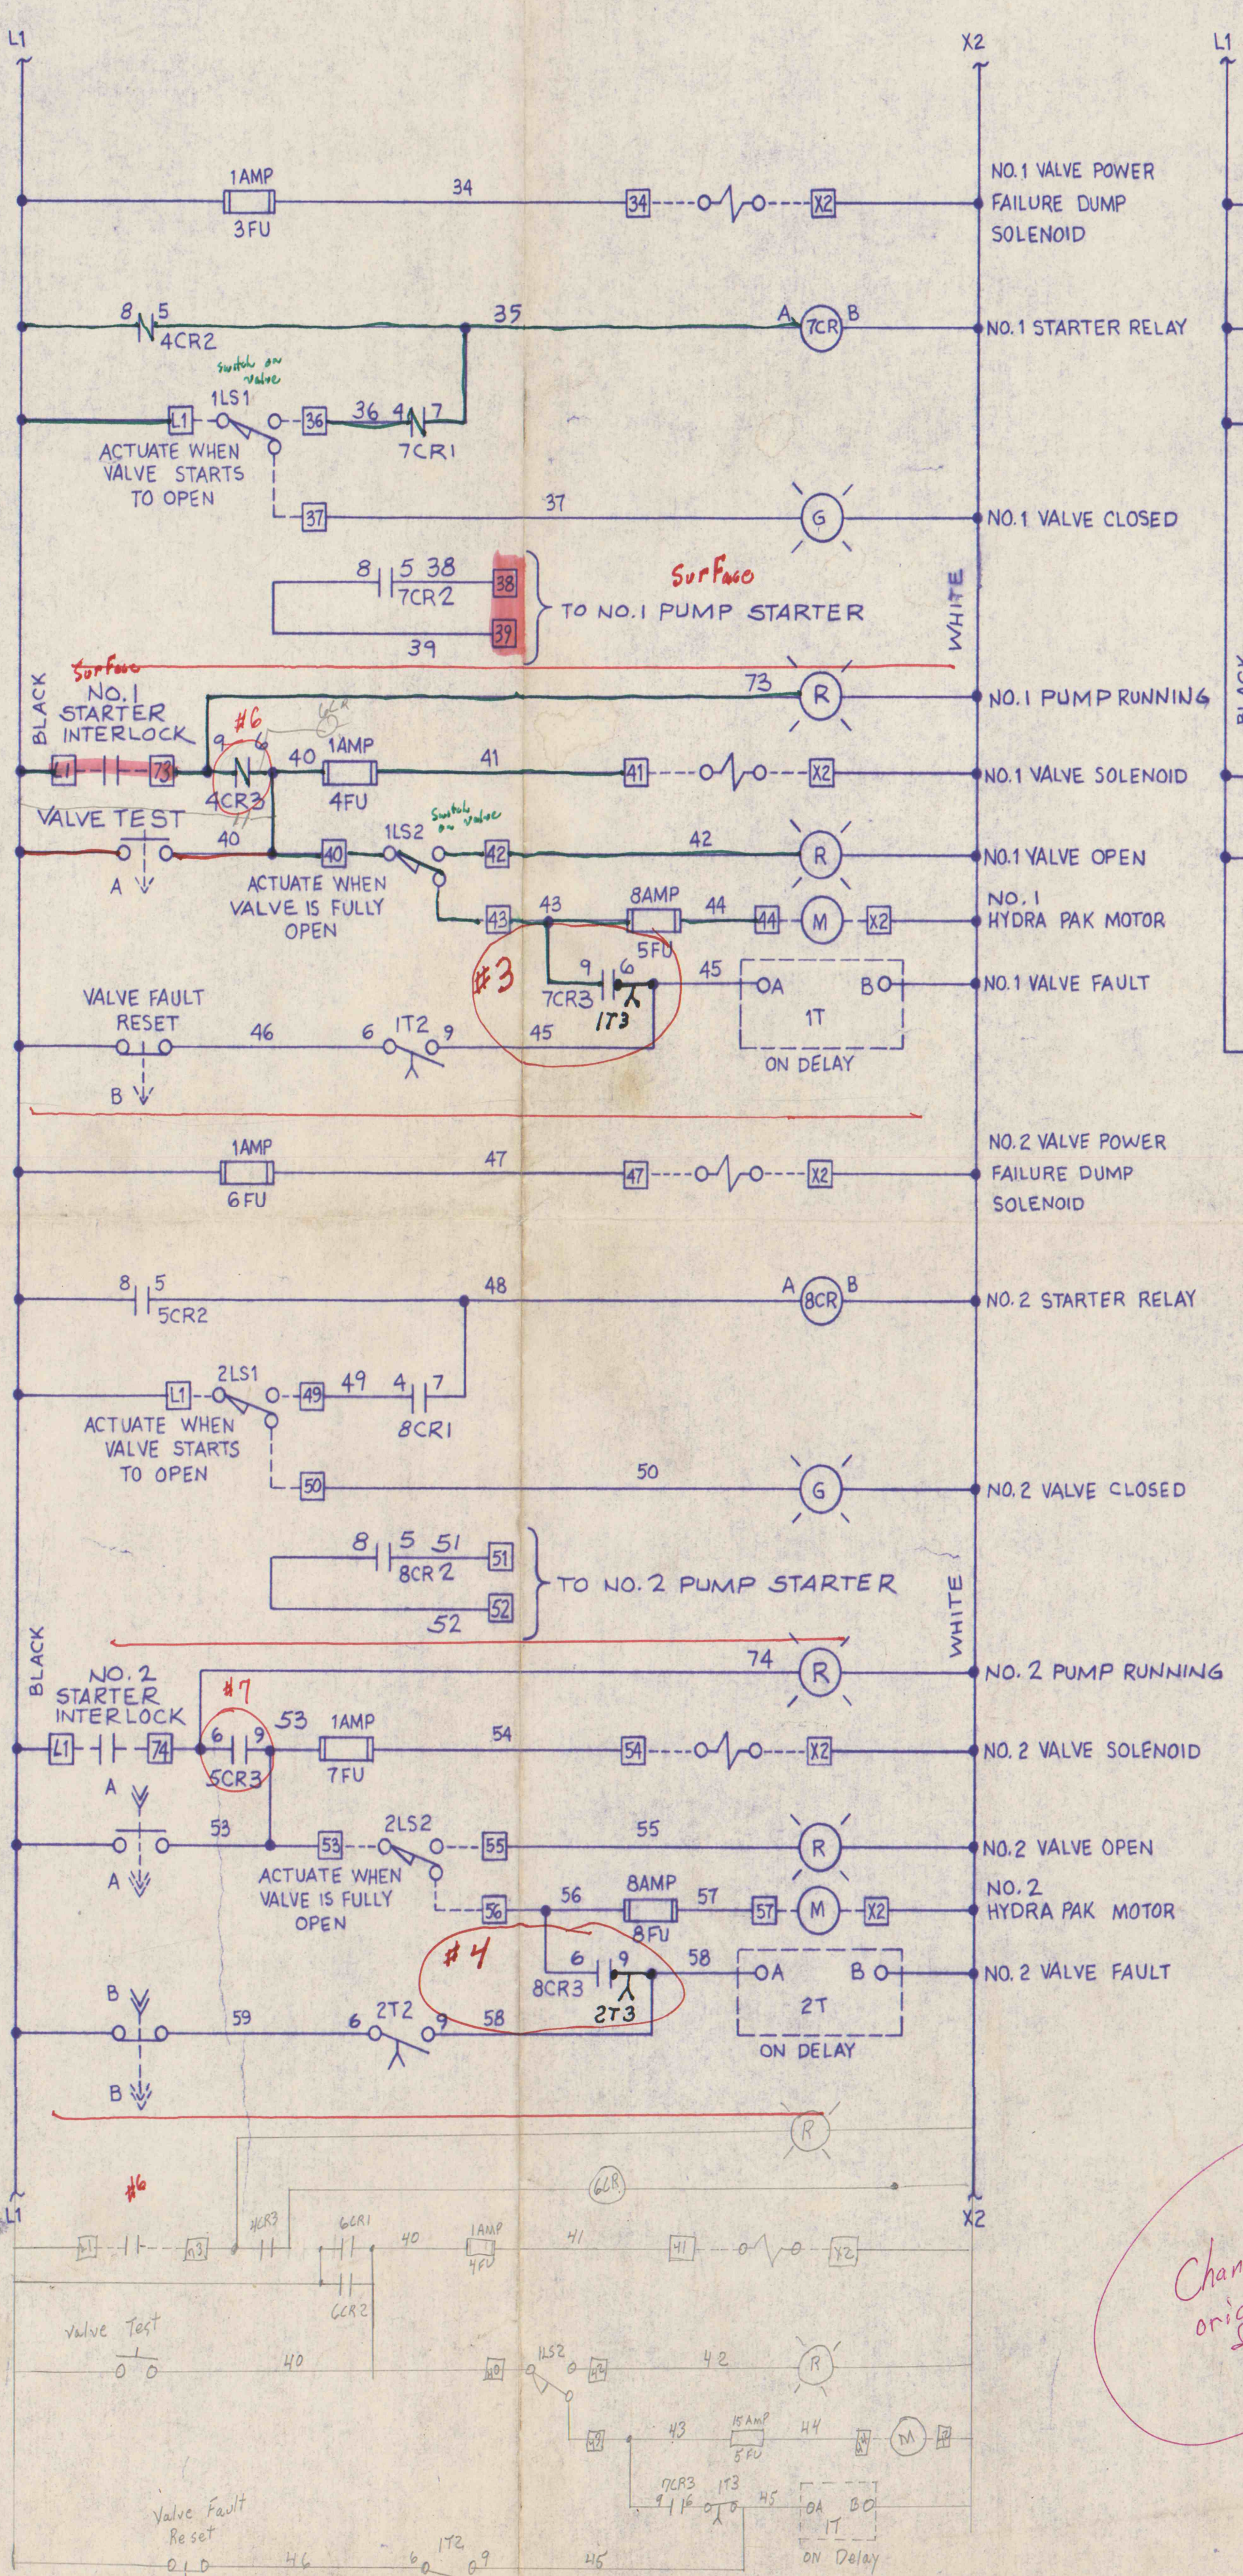


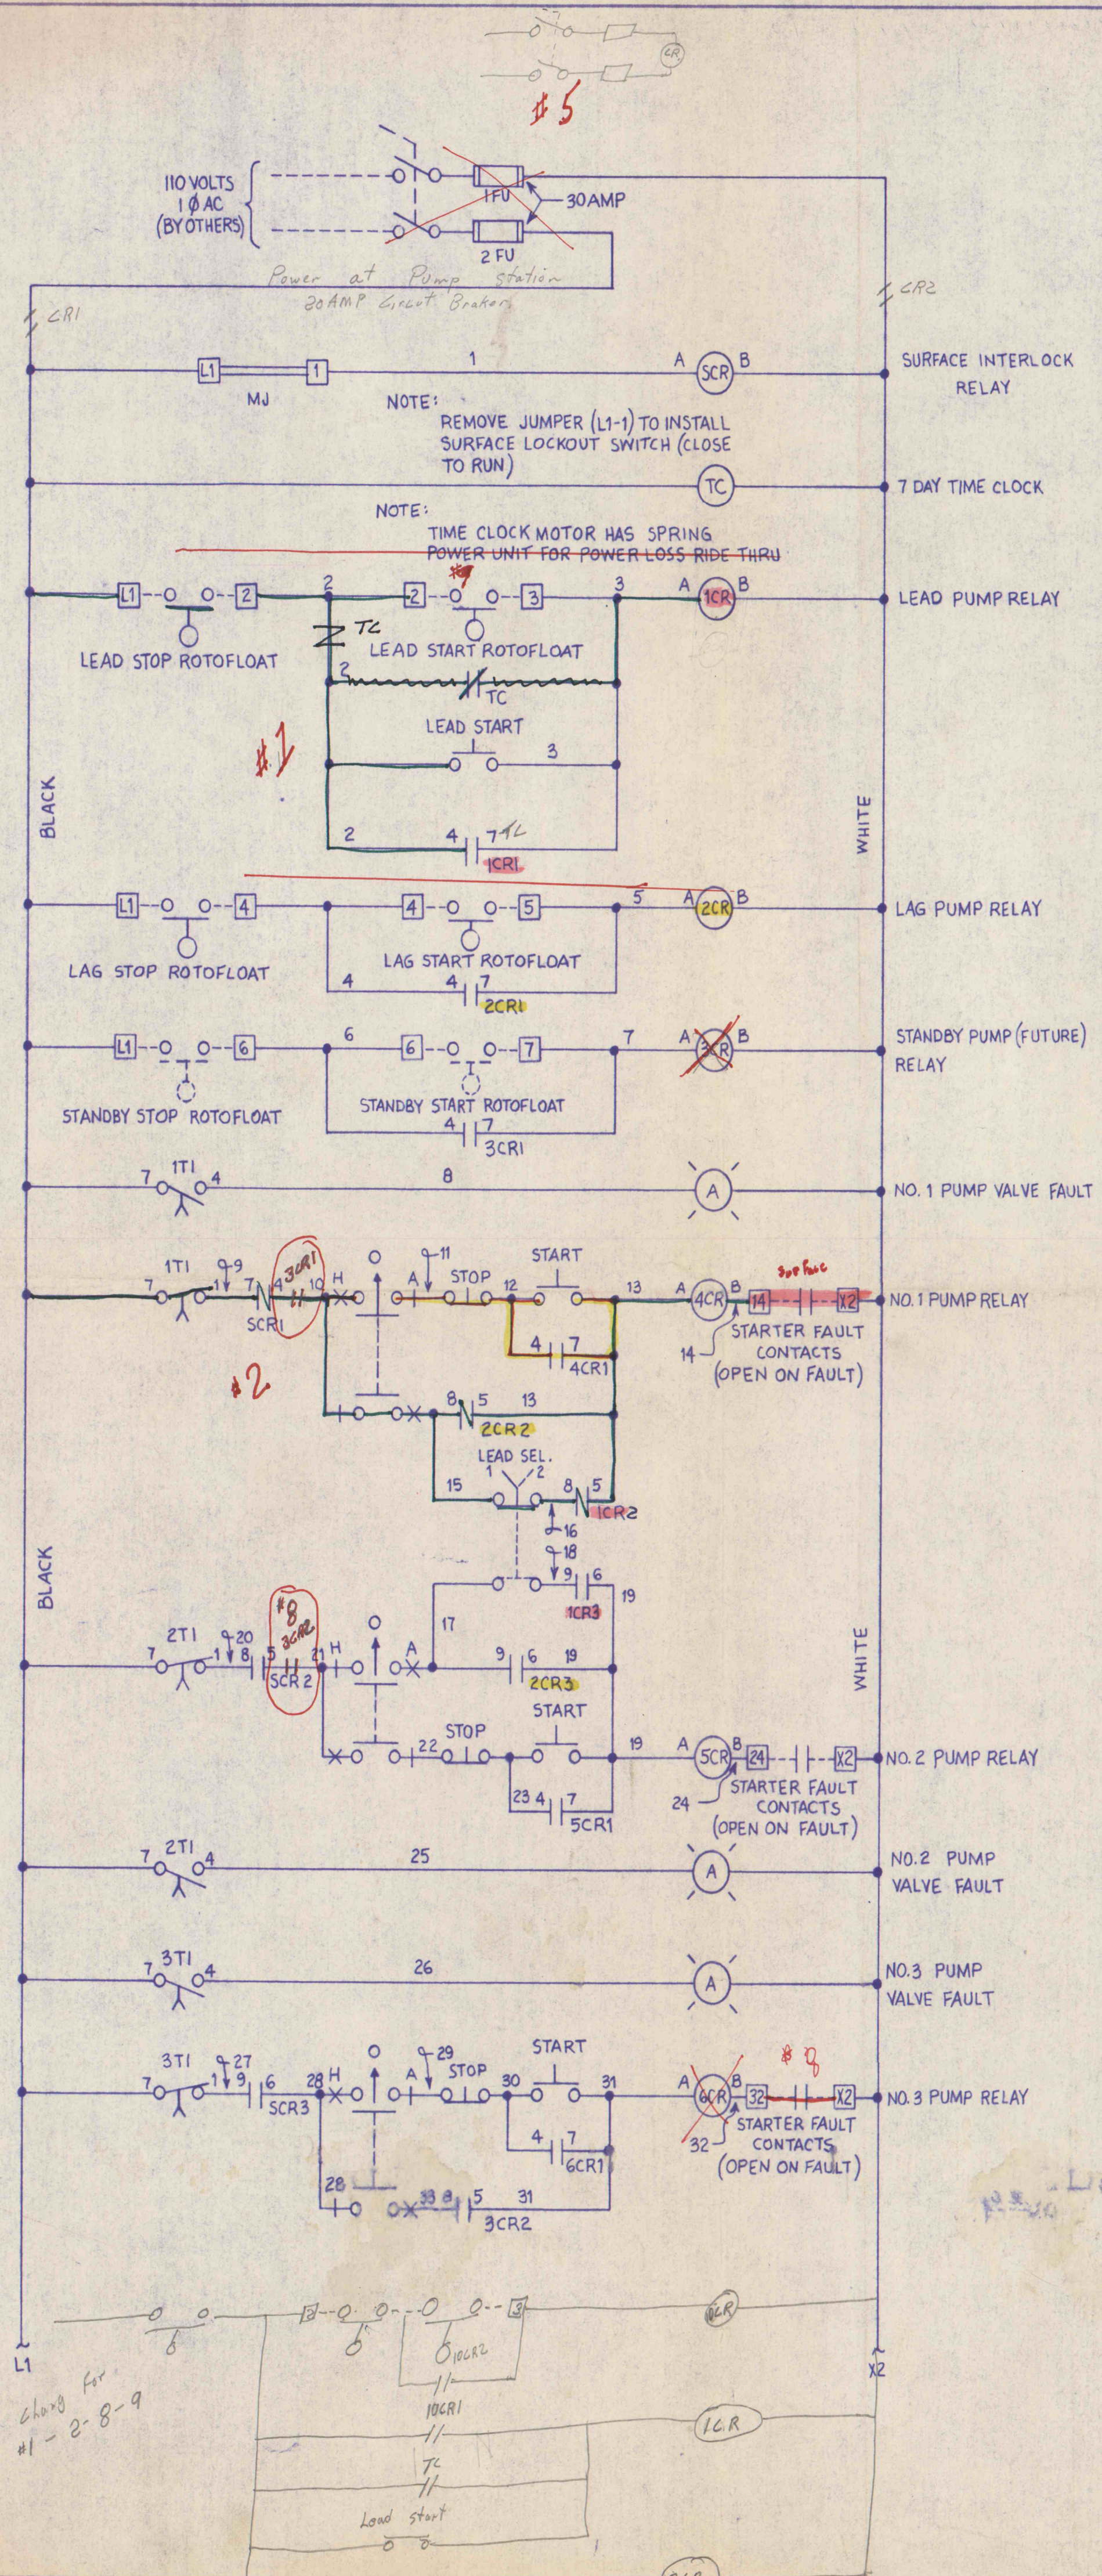

Changes made to original drawing

ITEM	SIZE	DESCRIPTION	MATERIAL	REFERENCE	RECD
b Barrett Haentjens & Co. of Pittsburgh					
WIRING SCHEMATIC PUMP & VALVE CONTROL PANEL					
HELVETIA COAL COMPANY LUZERNE NO. 6 PUMP STATION					
PMW	RS	DATE	3-25-85	SHEET	1
		NONE			1
					85D041