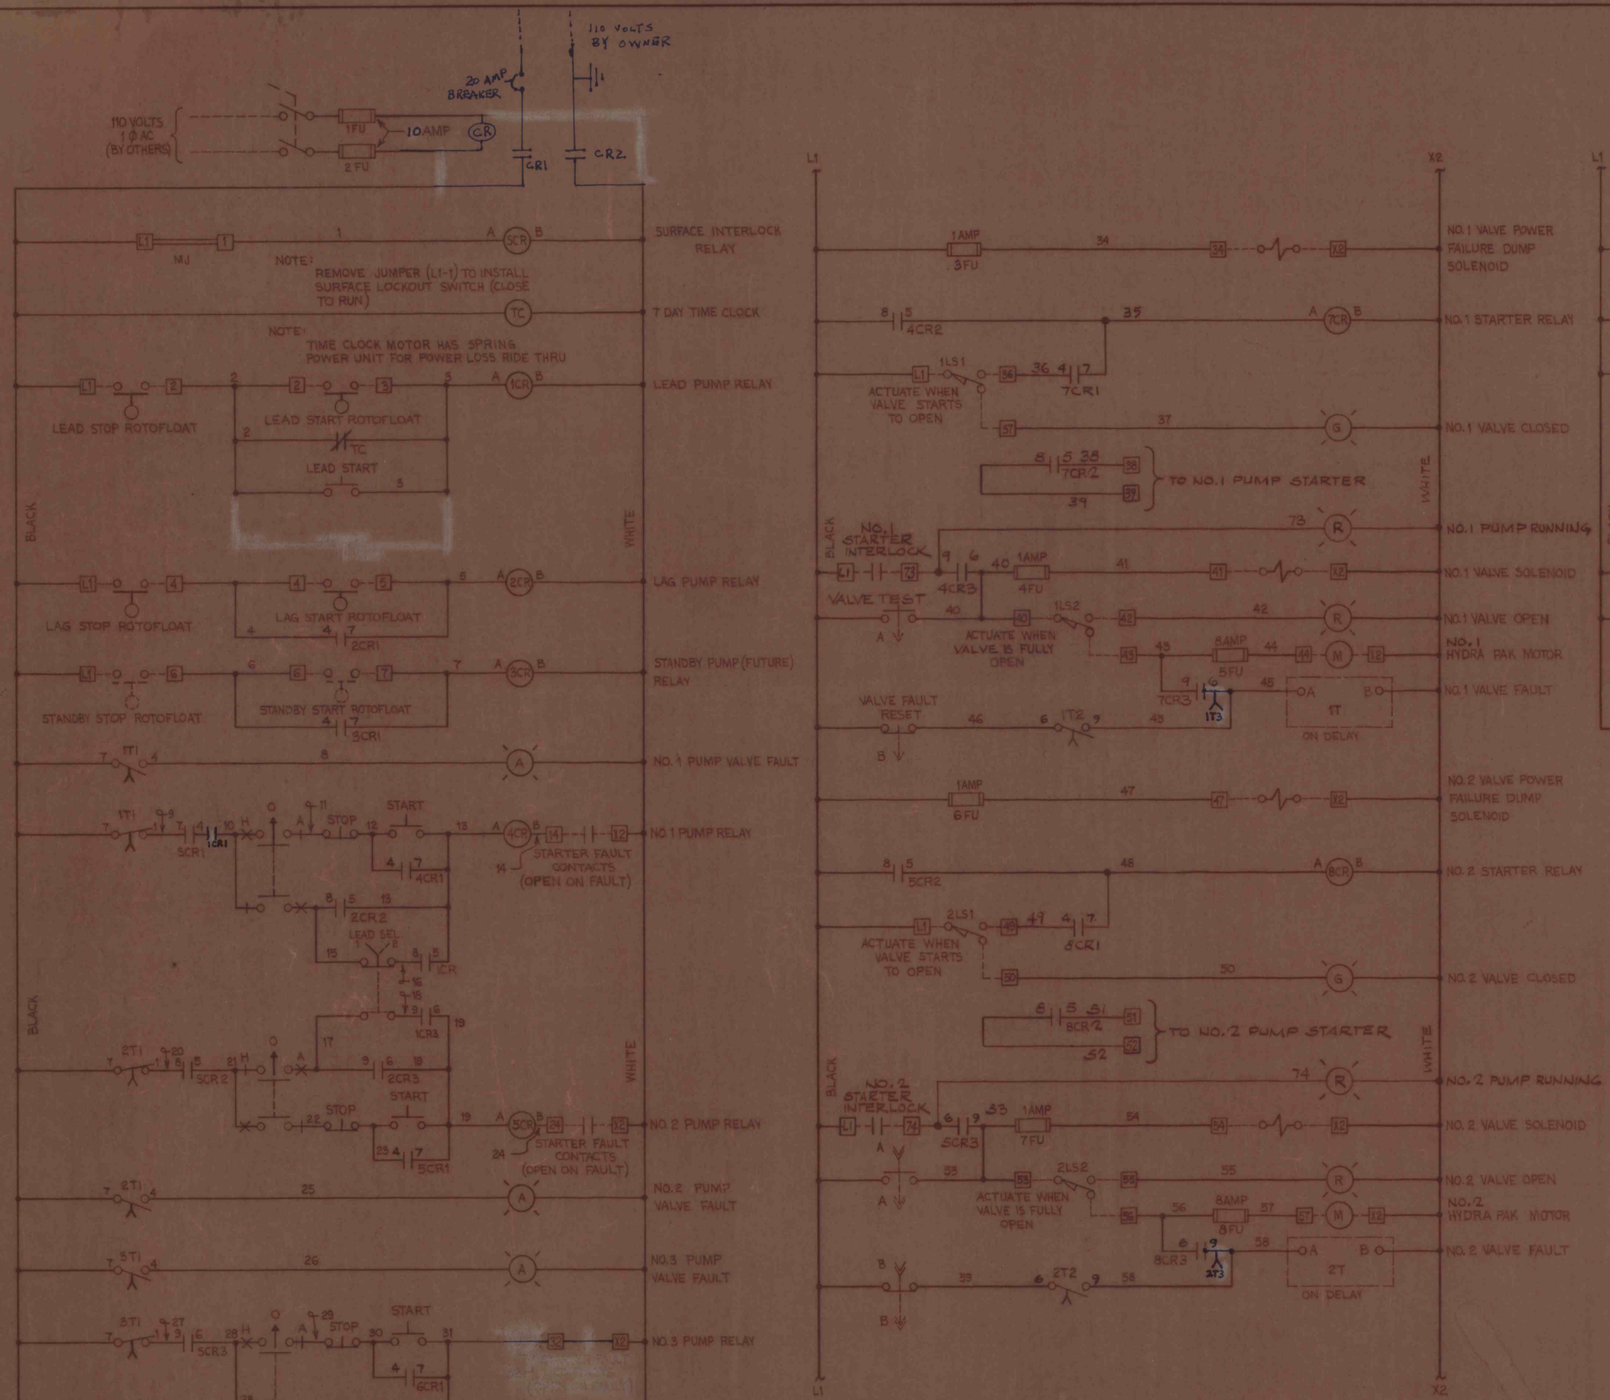

IMAPS#15325

ITEM	SIZE	DESCRIPTION	MATERIAL	REFERENCE	REQD

REV.	*	DATE
	REV.	6-25-86
	REV.	5-22-86

This print is the exclusive property of Barrett Haentjens & Co. of Pittsburgh and is confidential. It is loaned for engineering reference only and is not to be copied or reproduced except for use with this specific installation. It is not to be used directly or indirectly in any way detrimental to our interests. This print and all reproductions are to be returned to us upon request.

Hydra Hydraulic Pipe - U.S. Patent 3,472,342 Canadian Patent 774,196 - Foreign Patents Pending

Barrett Haentjens & Co. of Pittsburgh

TITLE: WIRING SCHEMATIC PUMP & VALVE CONTROL PANEL

FOR: HELVETIA COAL COMPANY LUZERNE NO.6 PUMP STATION

DRAWN: PMW	DATE: 3-25-85	SHEET 1 OF 1	
CHECKED: RS	SCALE: NONE	DWG NO. 85D041	
SHOP NO.			

*Denotes number of places revision symbol appears