


VOID

VOID

VOID

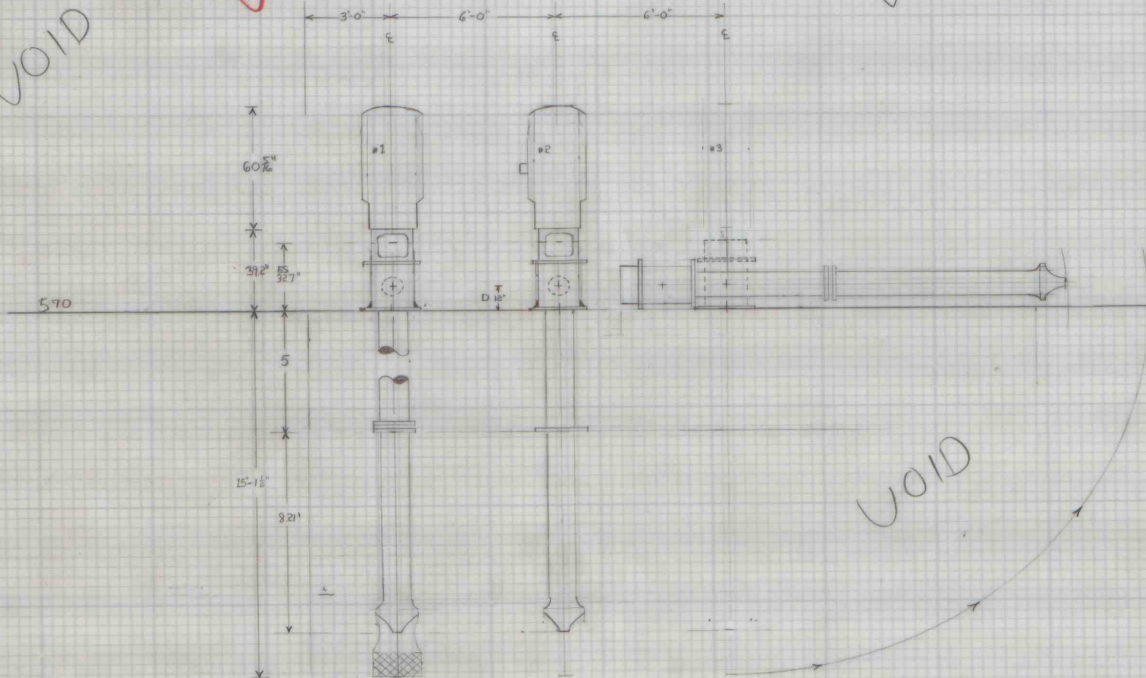

VOID

VOID

VOID

DRAFT
2-15-84

DIMENSIONS FROM 21.1 DATED 11-3-82
NOT CERTIFIED BY VPD ENGR DEPT.

RFJ

SCALE 1/4" = 1'-0"

VIT-FE 16BHC PUMP #1 - ON LINE
PUMP #2 - ON LINE

IMAPS #15226

0130A