



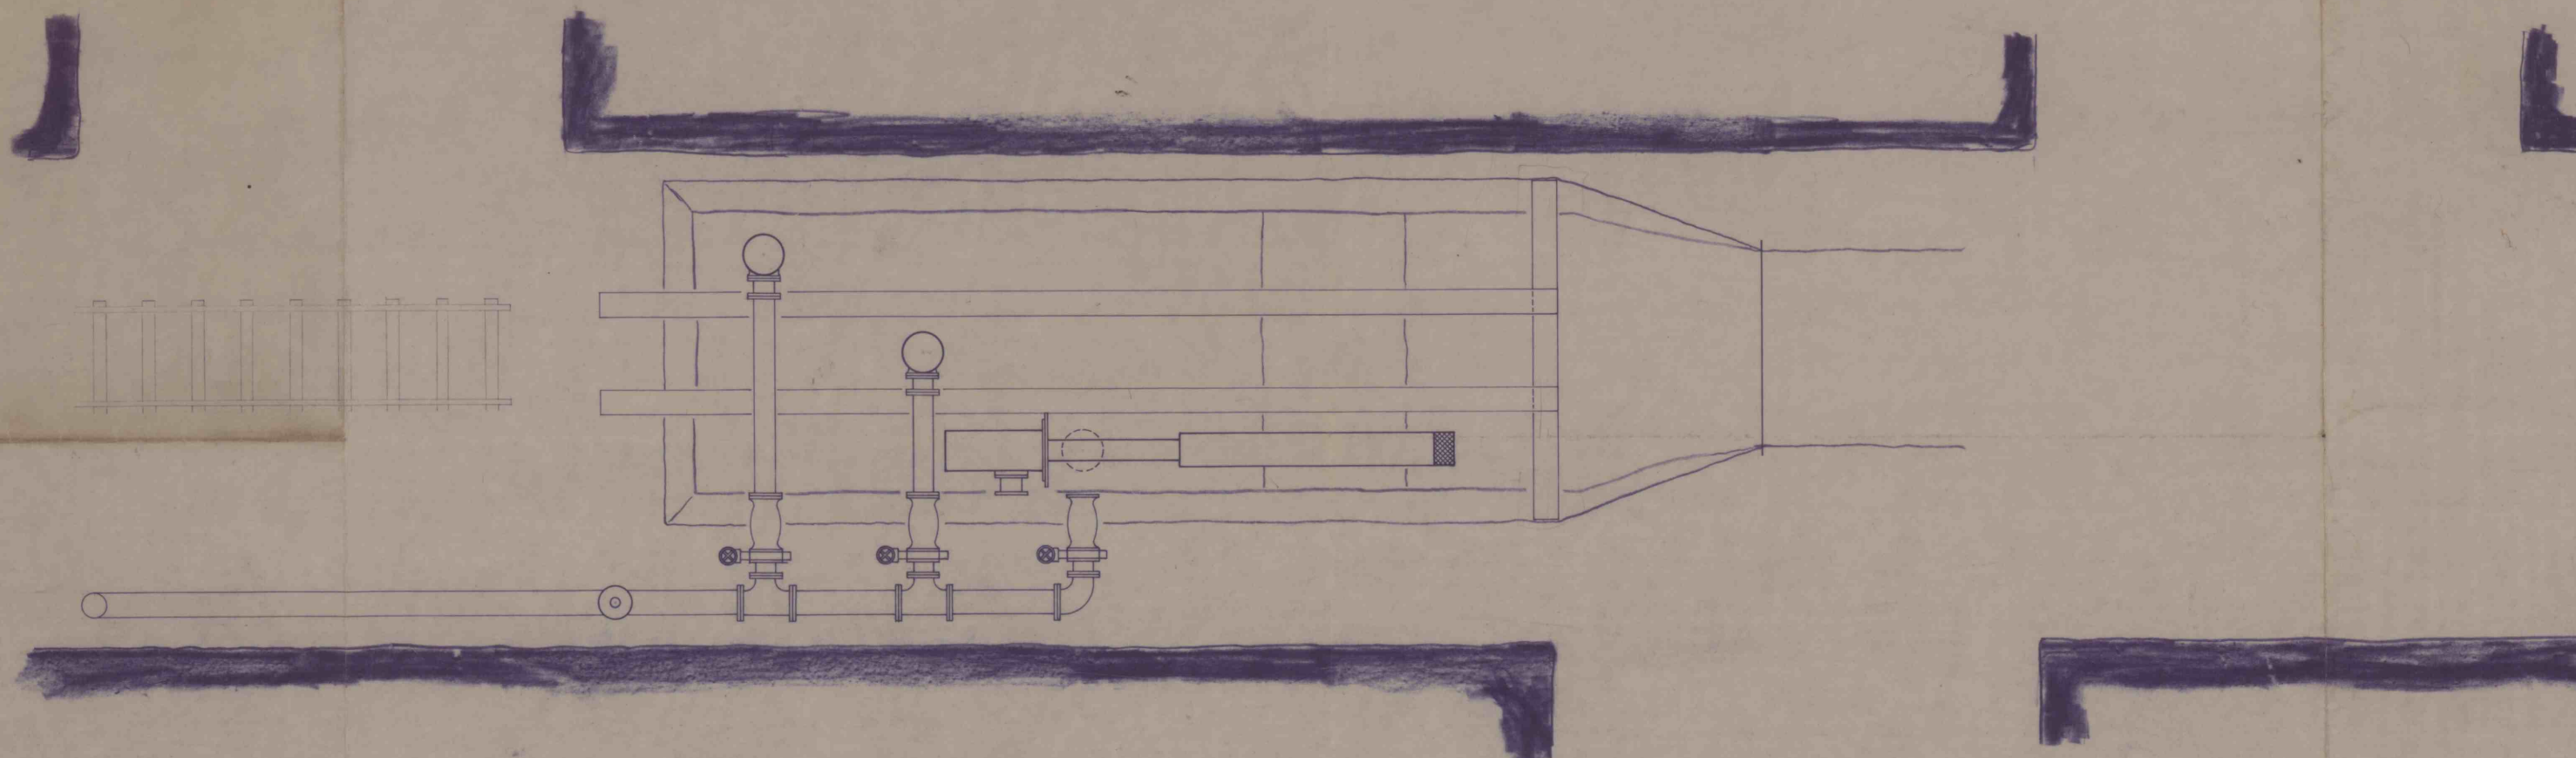

PLAN

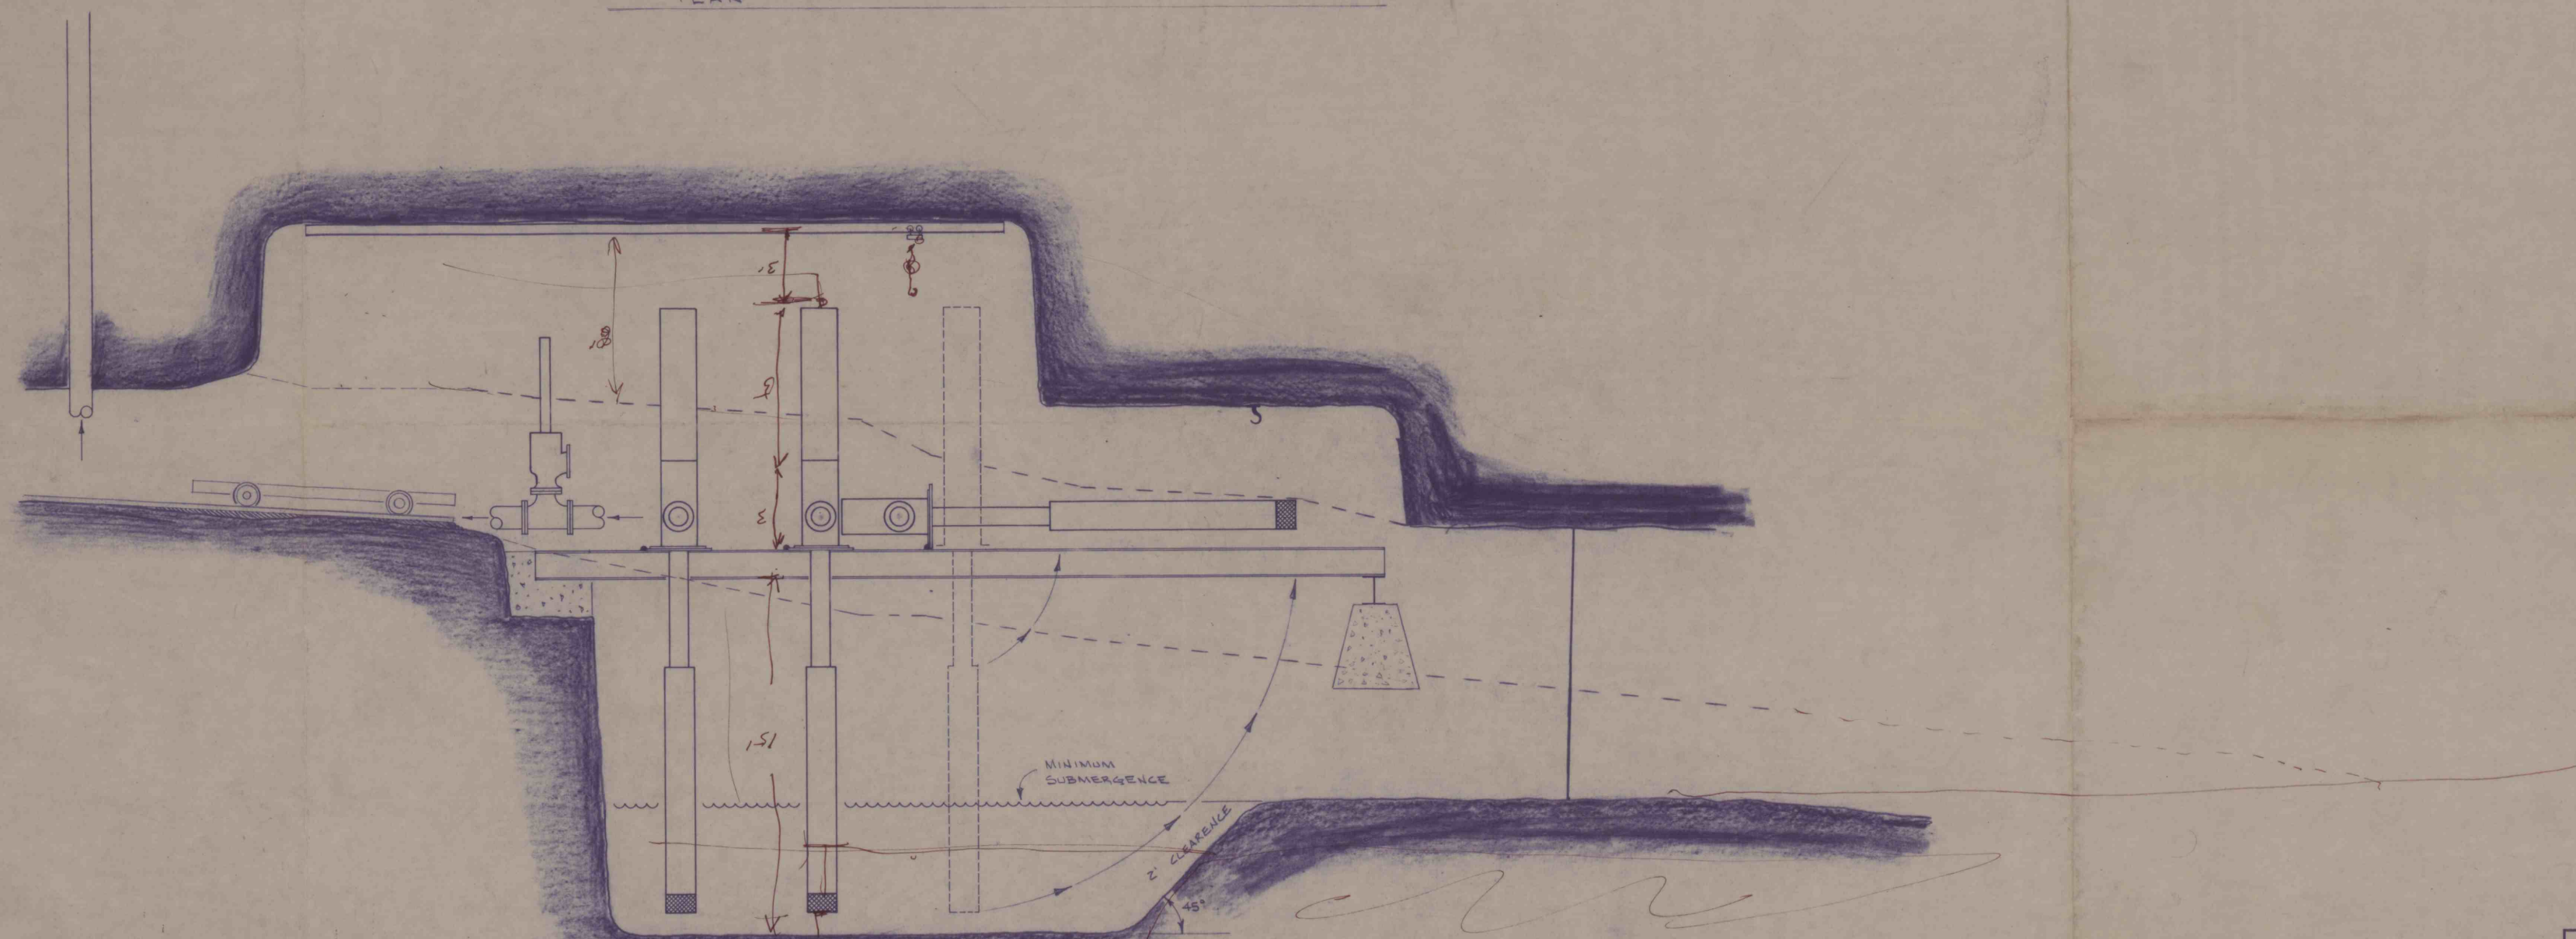

ELEVATION

IMAPS#
15330

HELVETIA COAL CO.	
ENGINEERING DEPT., INDIANA, PA.	
LUCERNE No. 6	
PUMP STATION	
MADE BY: T. STORMES	SCALE: 1/4" = 1'-0"
TRACED BY:	DATE: 11-3-82
CHECKED BY:	NO.