



570
534
36
192' = 240
8'

25 HOLES

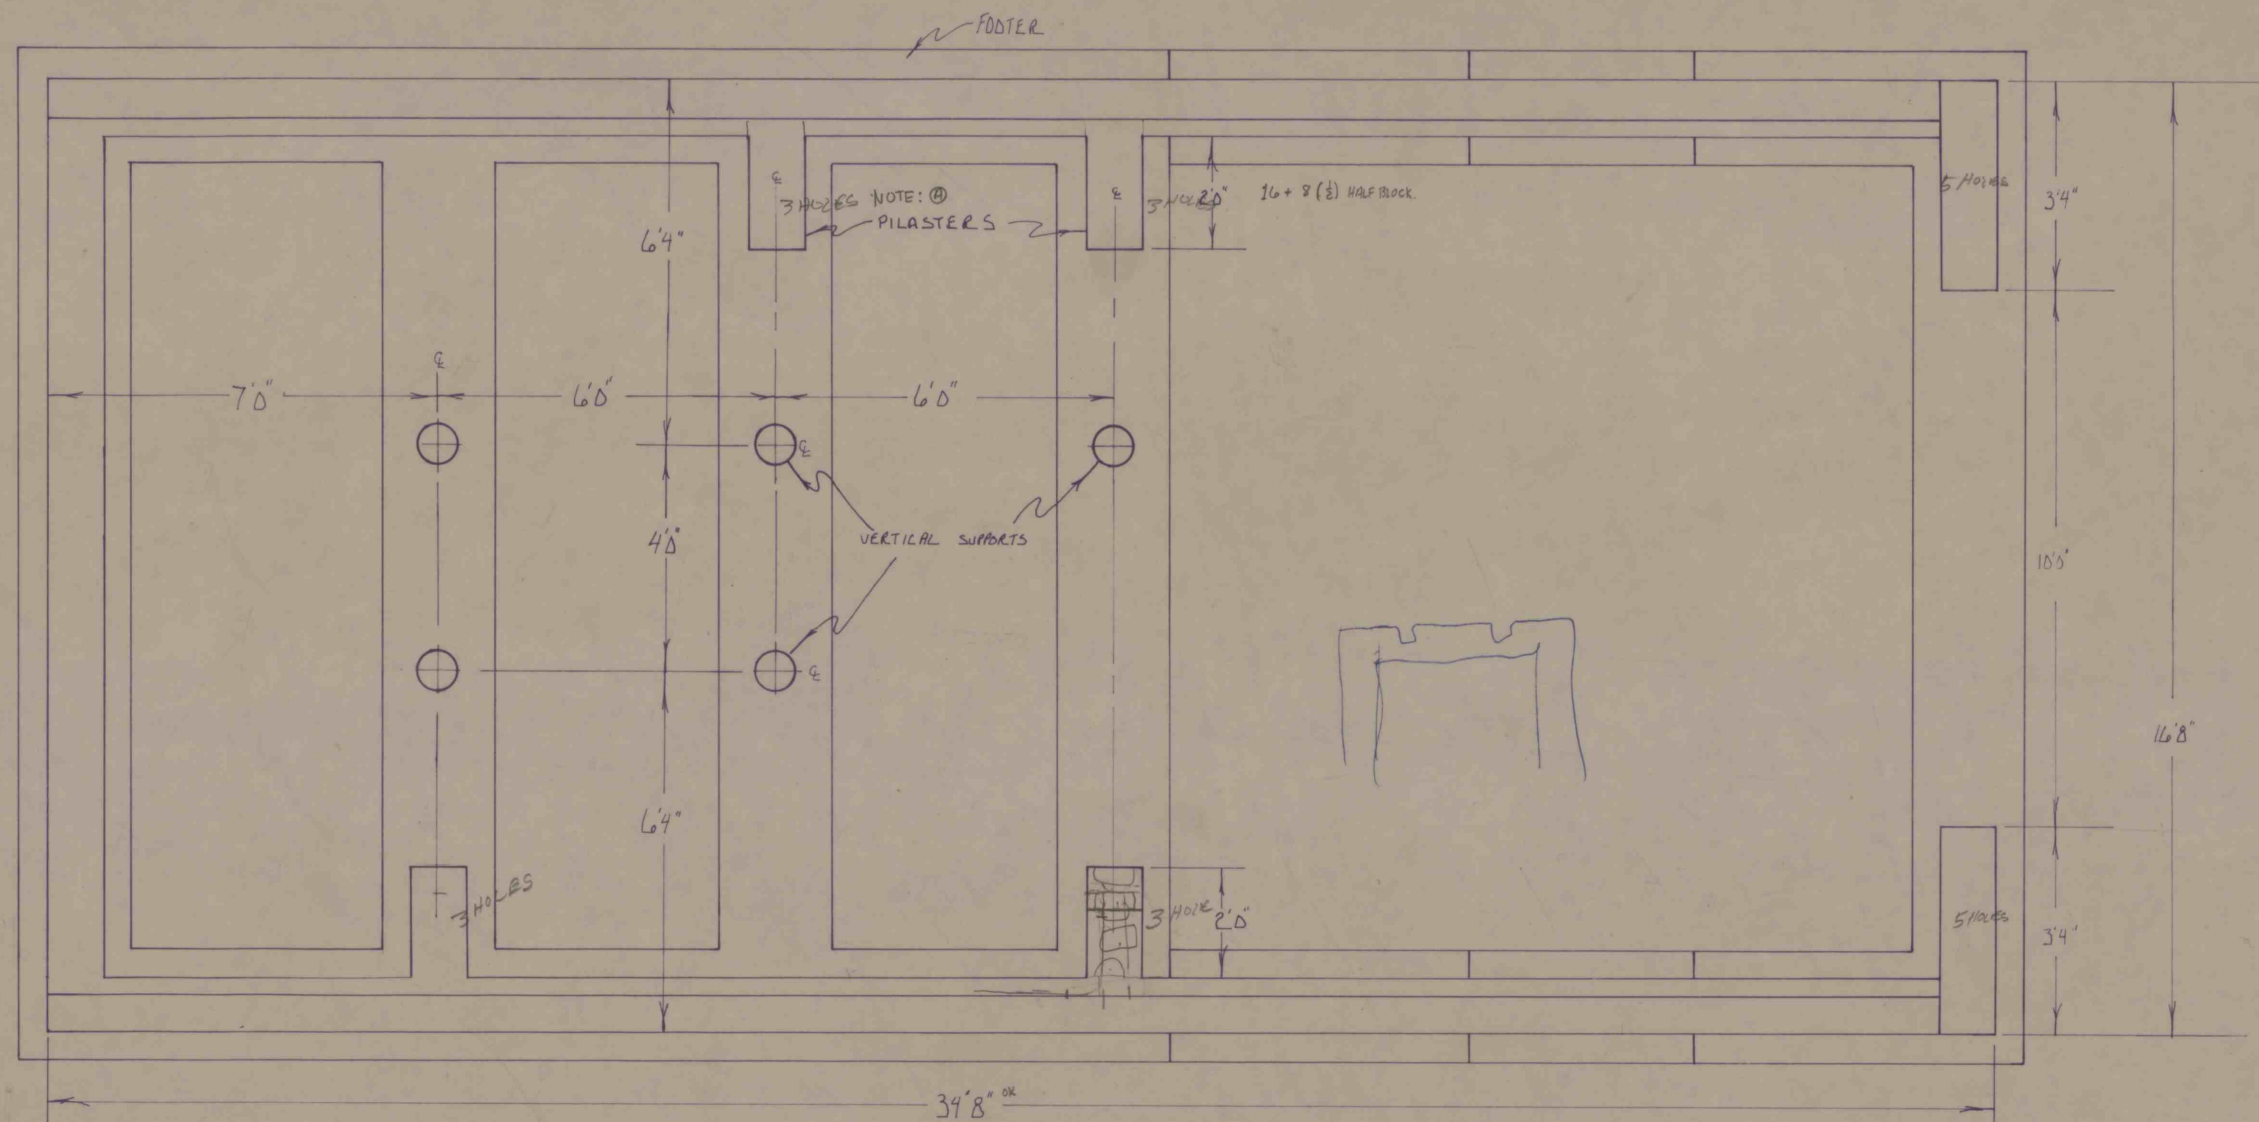


34'8" OK
408 + 8 = 416
16 = 26 BLK
52 HOLES

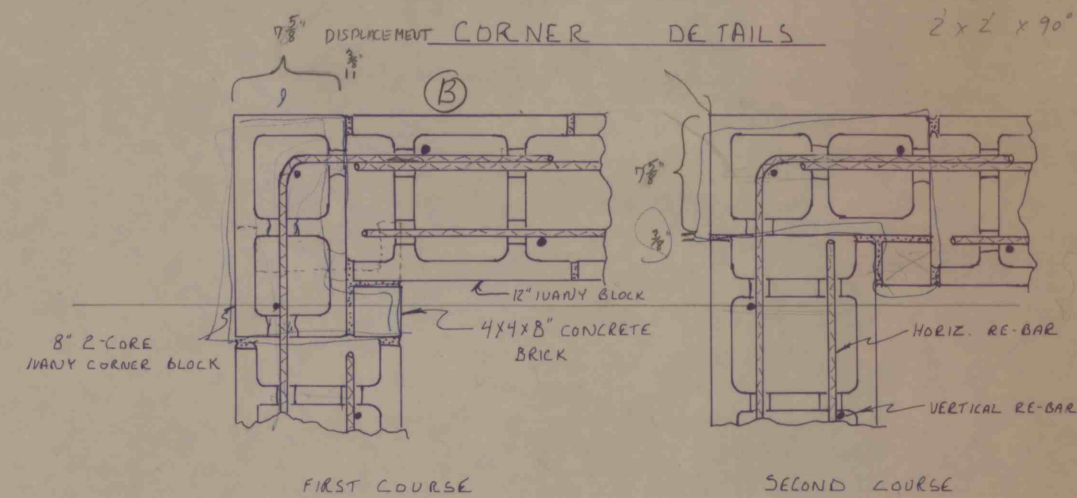

NOTES:



- ① PILASTERS TO BE TIED INTO WALL
SEE DETAIL ①
- ② CORNERS TIED - SEE DETAIL ①

N/S

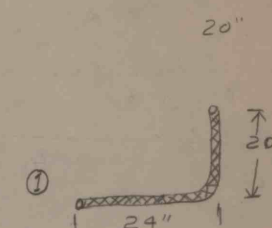

ELEV.
570.0
559.9

ELEV.
554.0
543.9

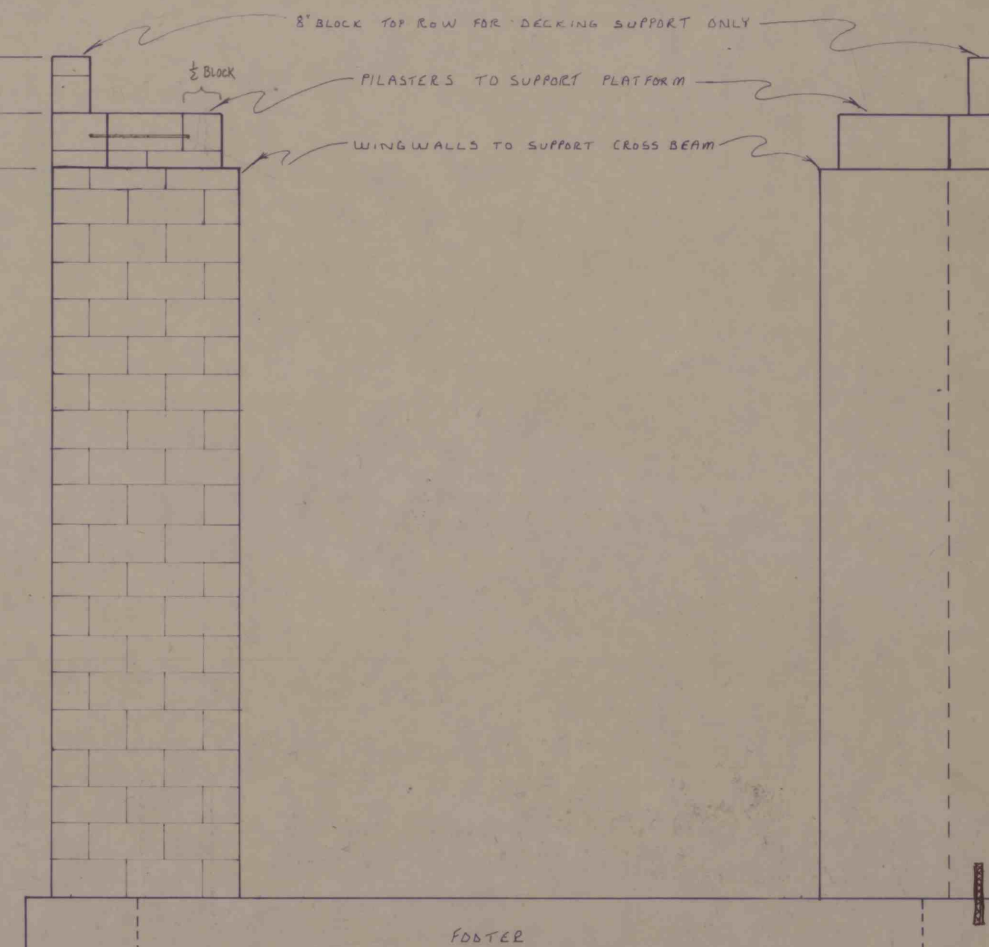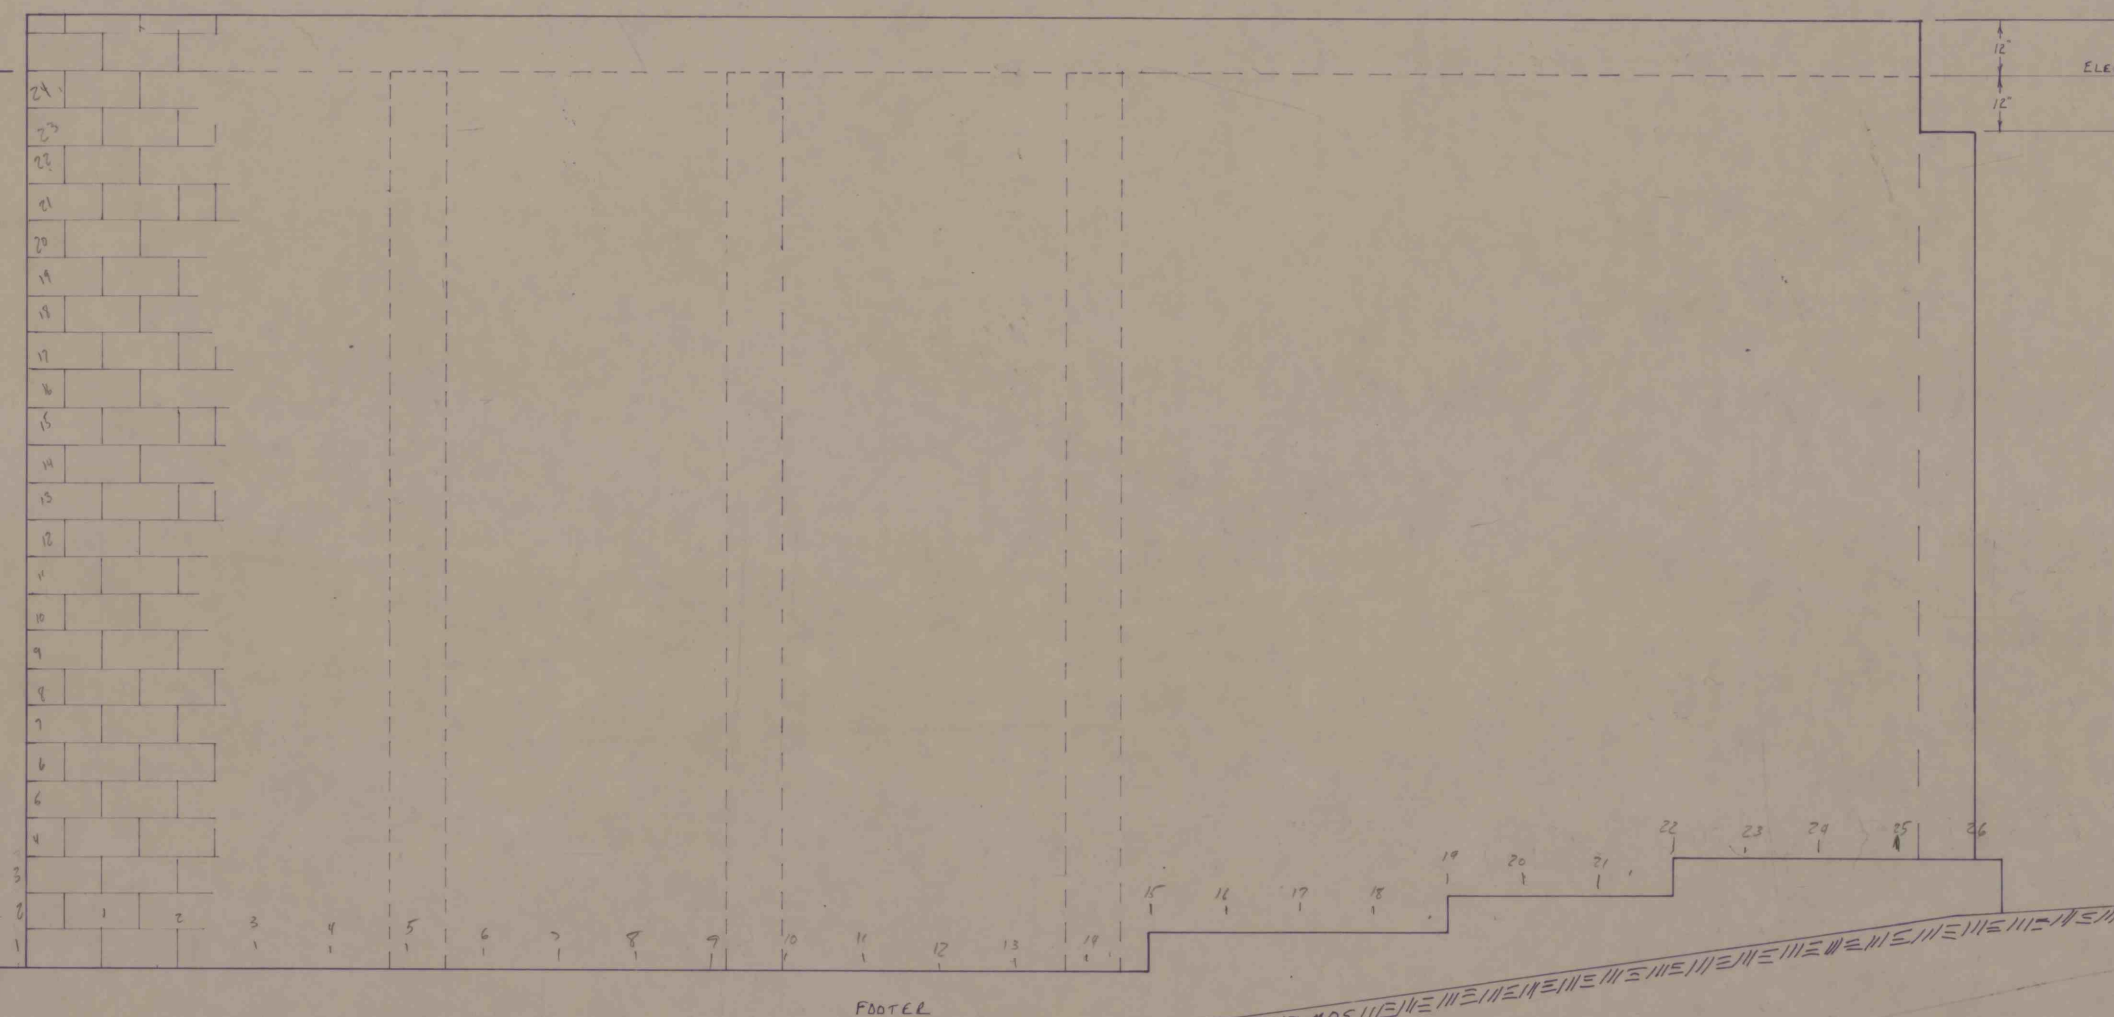

NOTE

NOTE: WALL TO BE
SHD ANCHORED INTO
FOOTER
ADD TO DRAWING

HELVETIA COAL CO. ENGINEERING DEPT., INDIANA, PA.	
WALL DETAIL LUCERNE NO. 6 MINE SUMP	
MADE BY M.O.S.	SCALE 1/2" = 1'
TRACED BY	DATE 4/12/84
CHECKED BY	NO.

NOTE: 1. WALLS ARE 12" MASONRY BLOCK
2. DUE TO CHANGES - SOME DIMENSIONS DO NOT
SCALE EXACTLY - THE DIMENSIONS ARE CORRECT M.O.S.

MAPS 15331