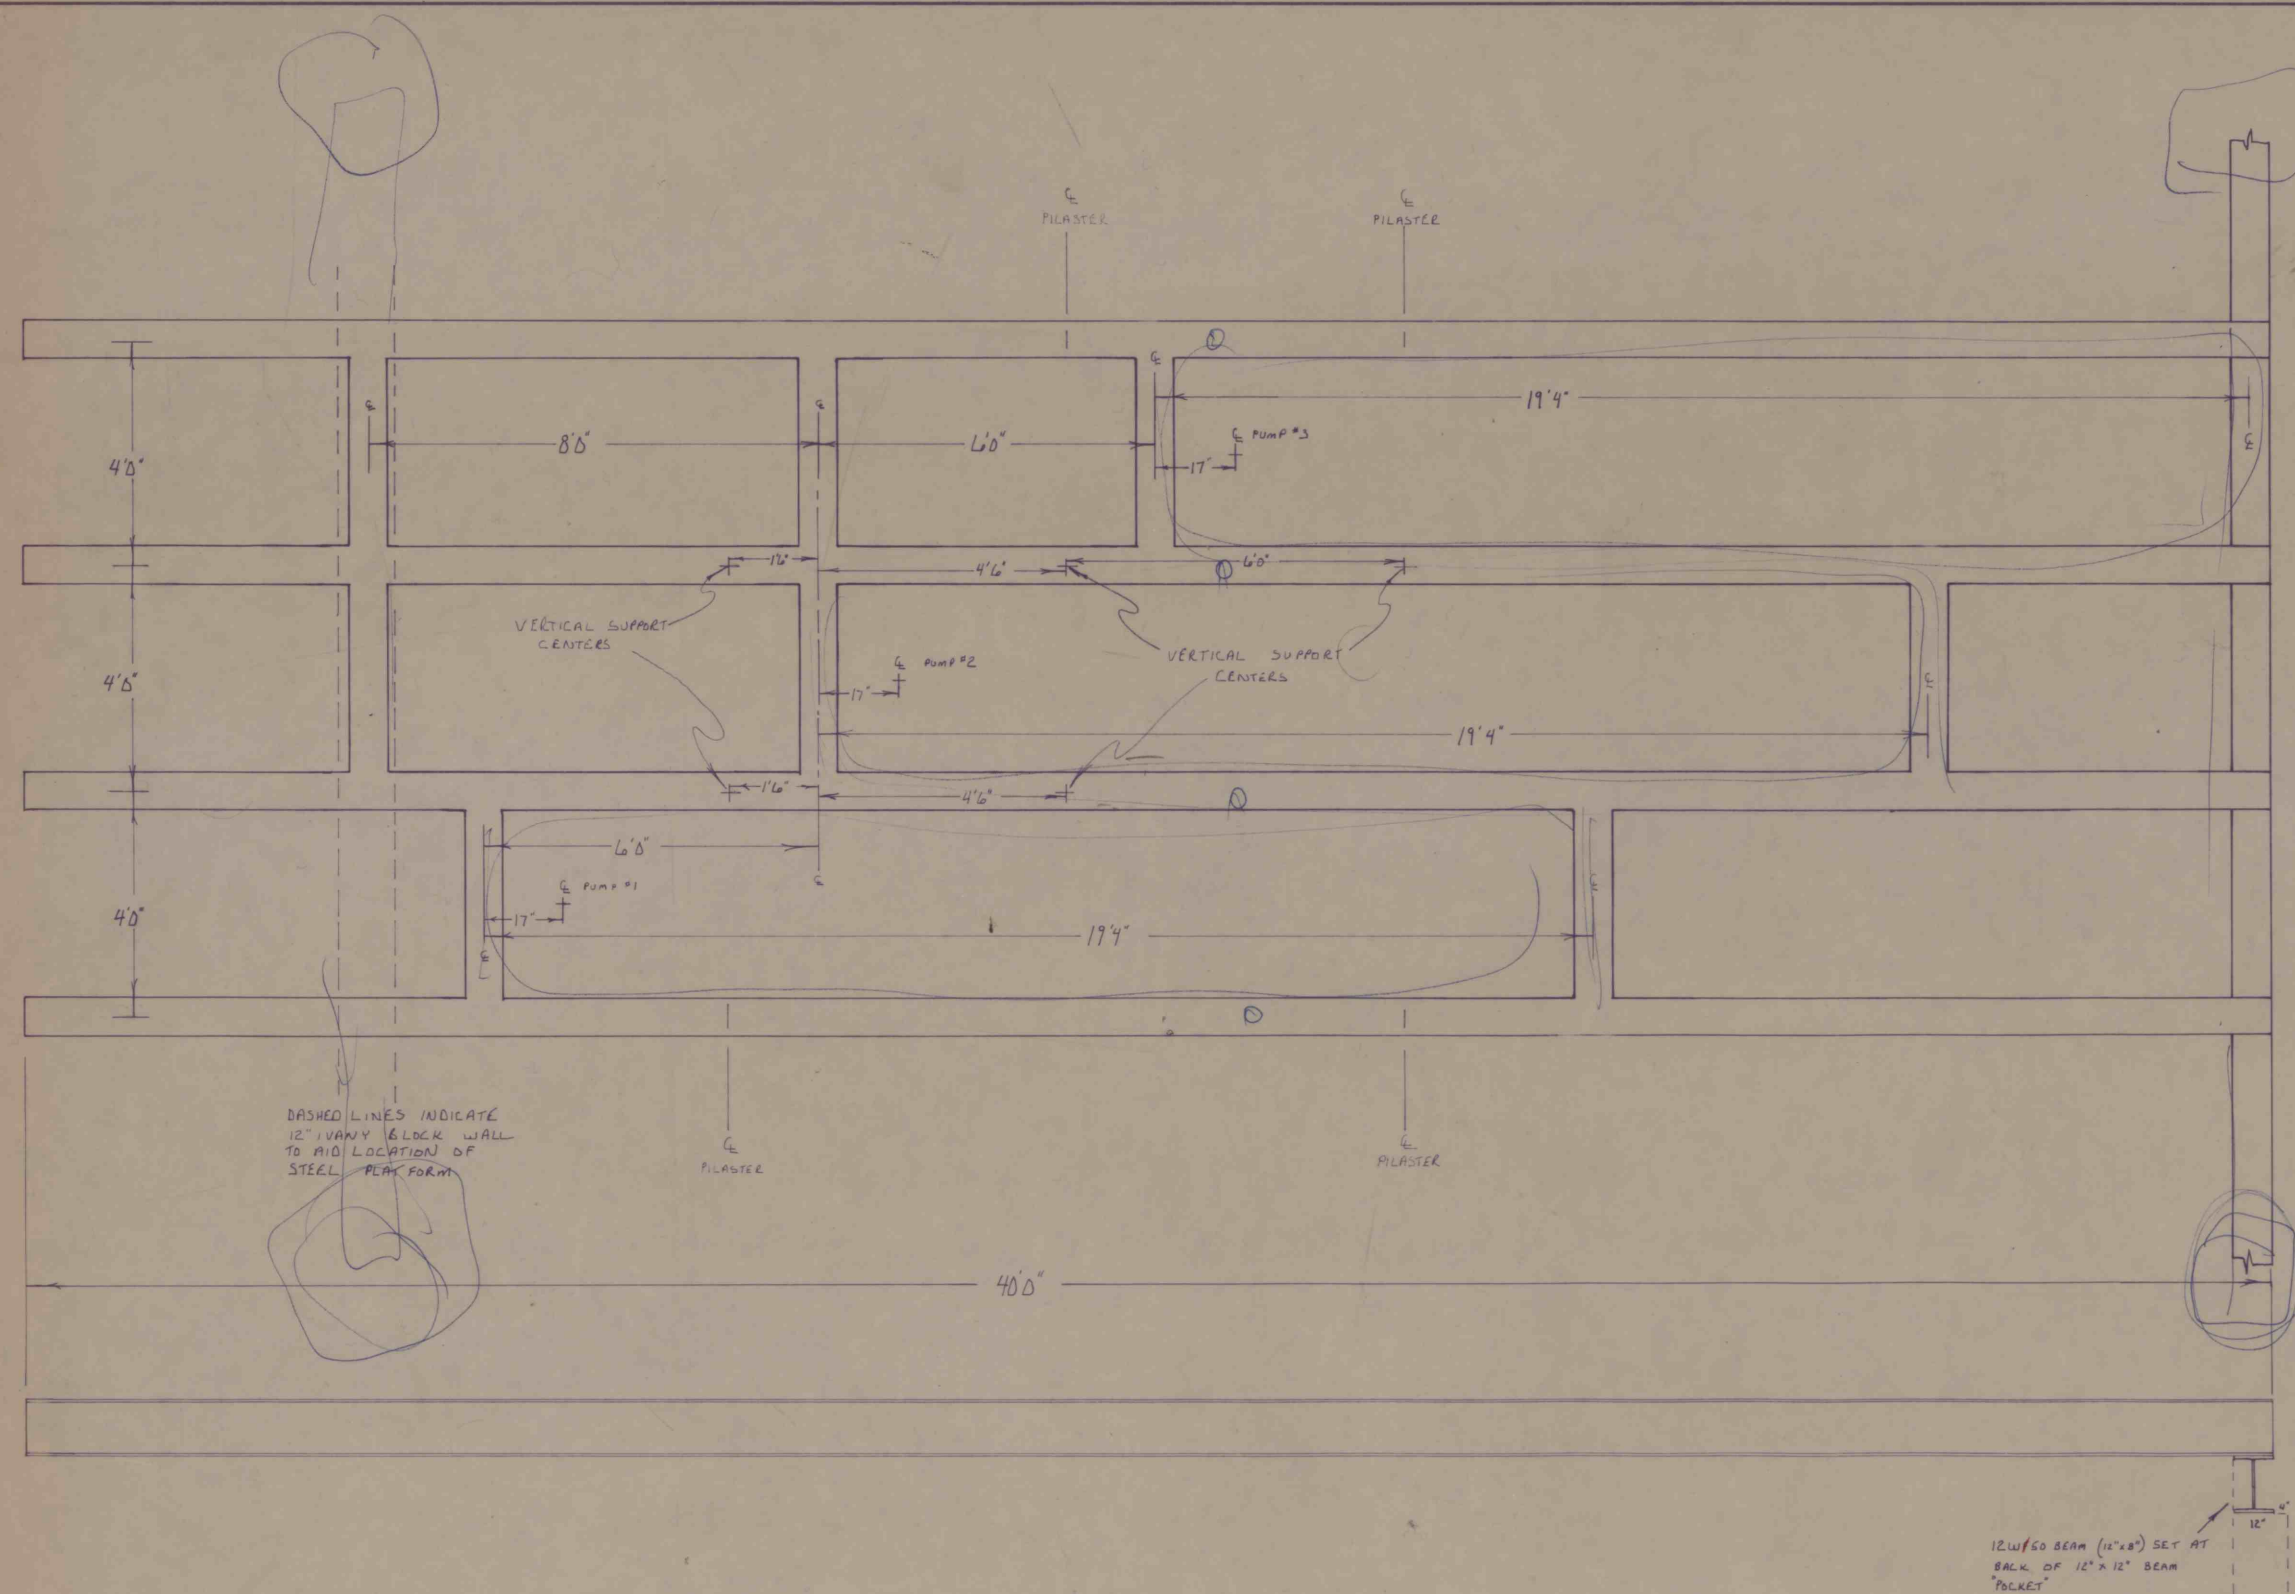


HELVETIA COAL CO.	
ENGINEERING DEPT., INDIANA, PA.	
PLATFORM DETAIL	
LUCERNE NO. 6	
MINE SUMP	
MADE BY M.D.S.	SCALE 1/2" = 1'
TRACED BY	DATE 4/17/84
CHECKED BY	NO.

EMAPS 15332