


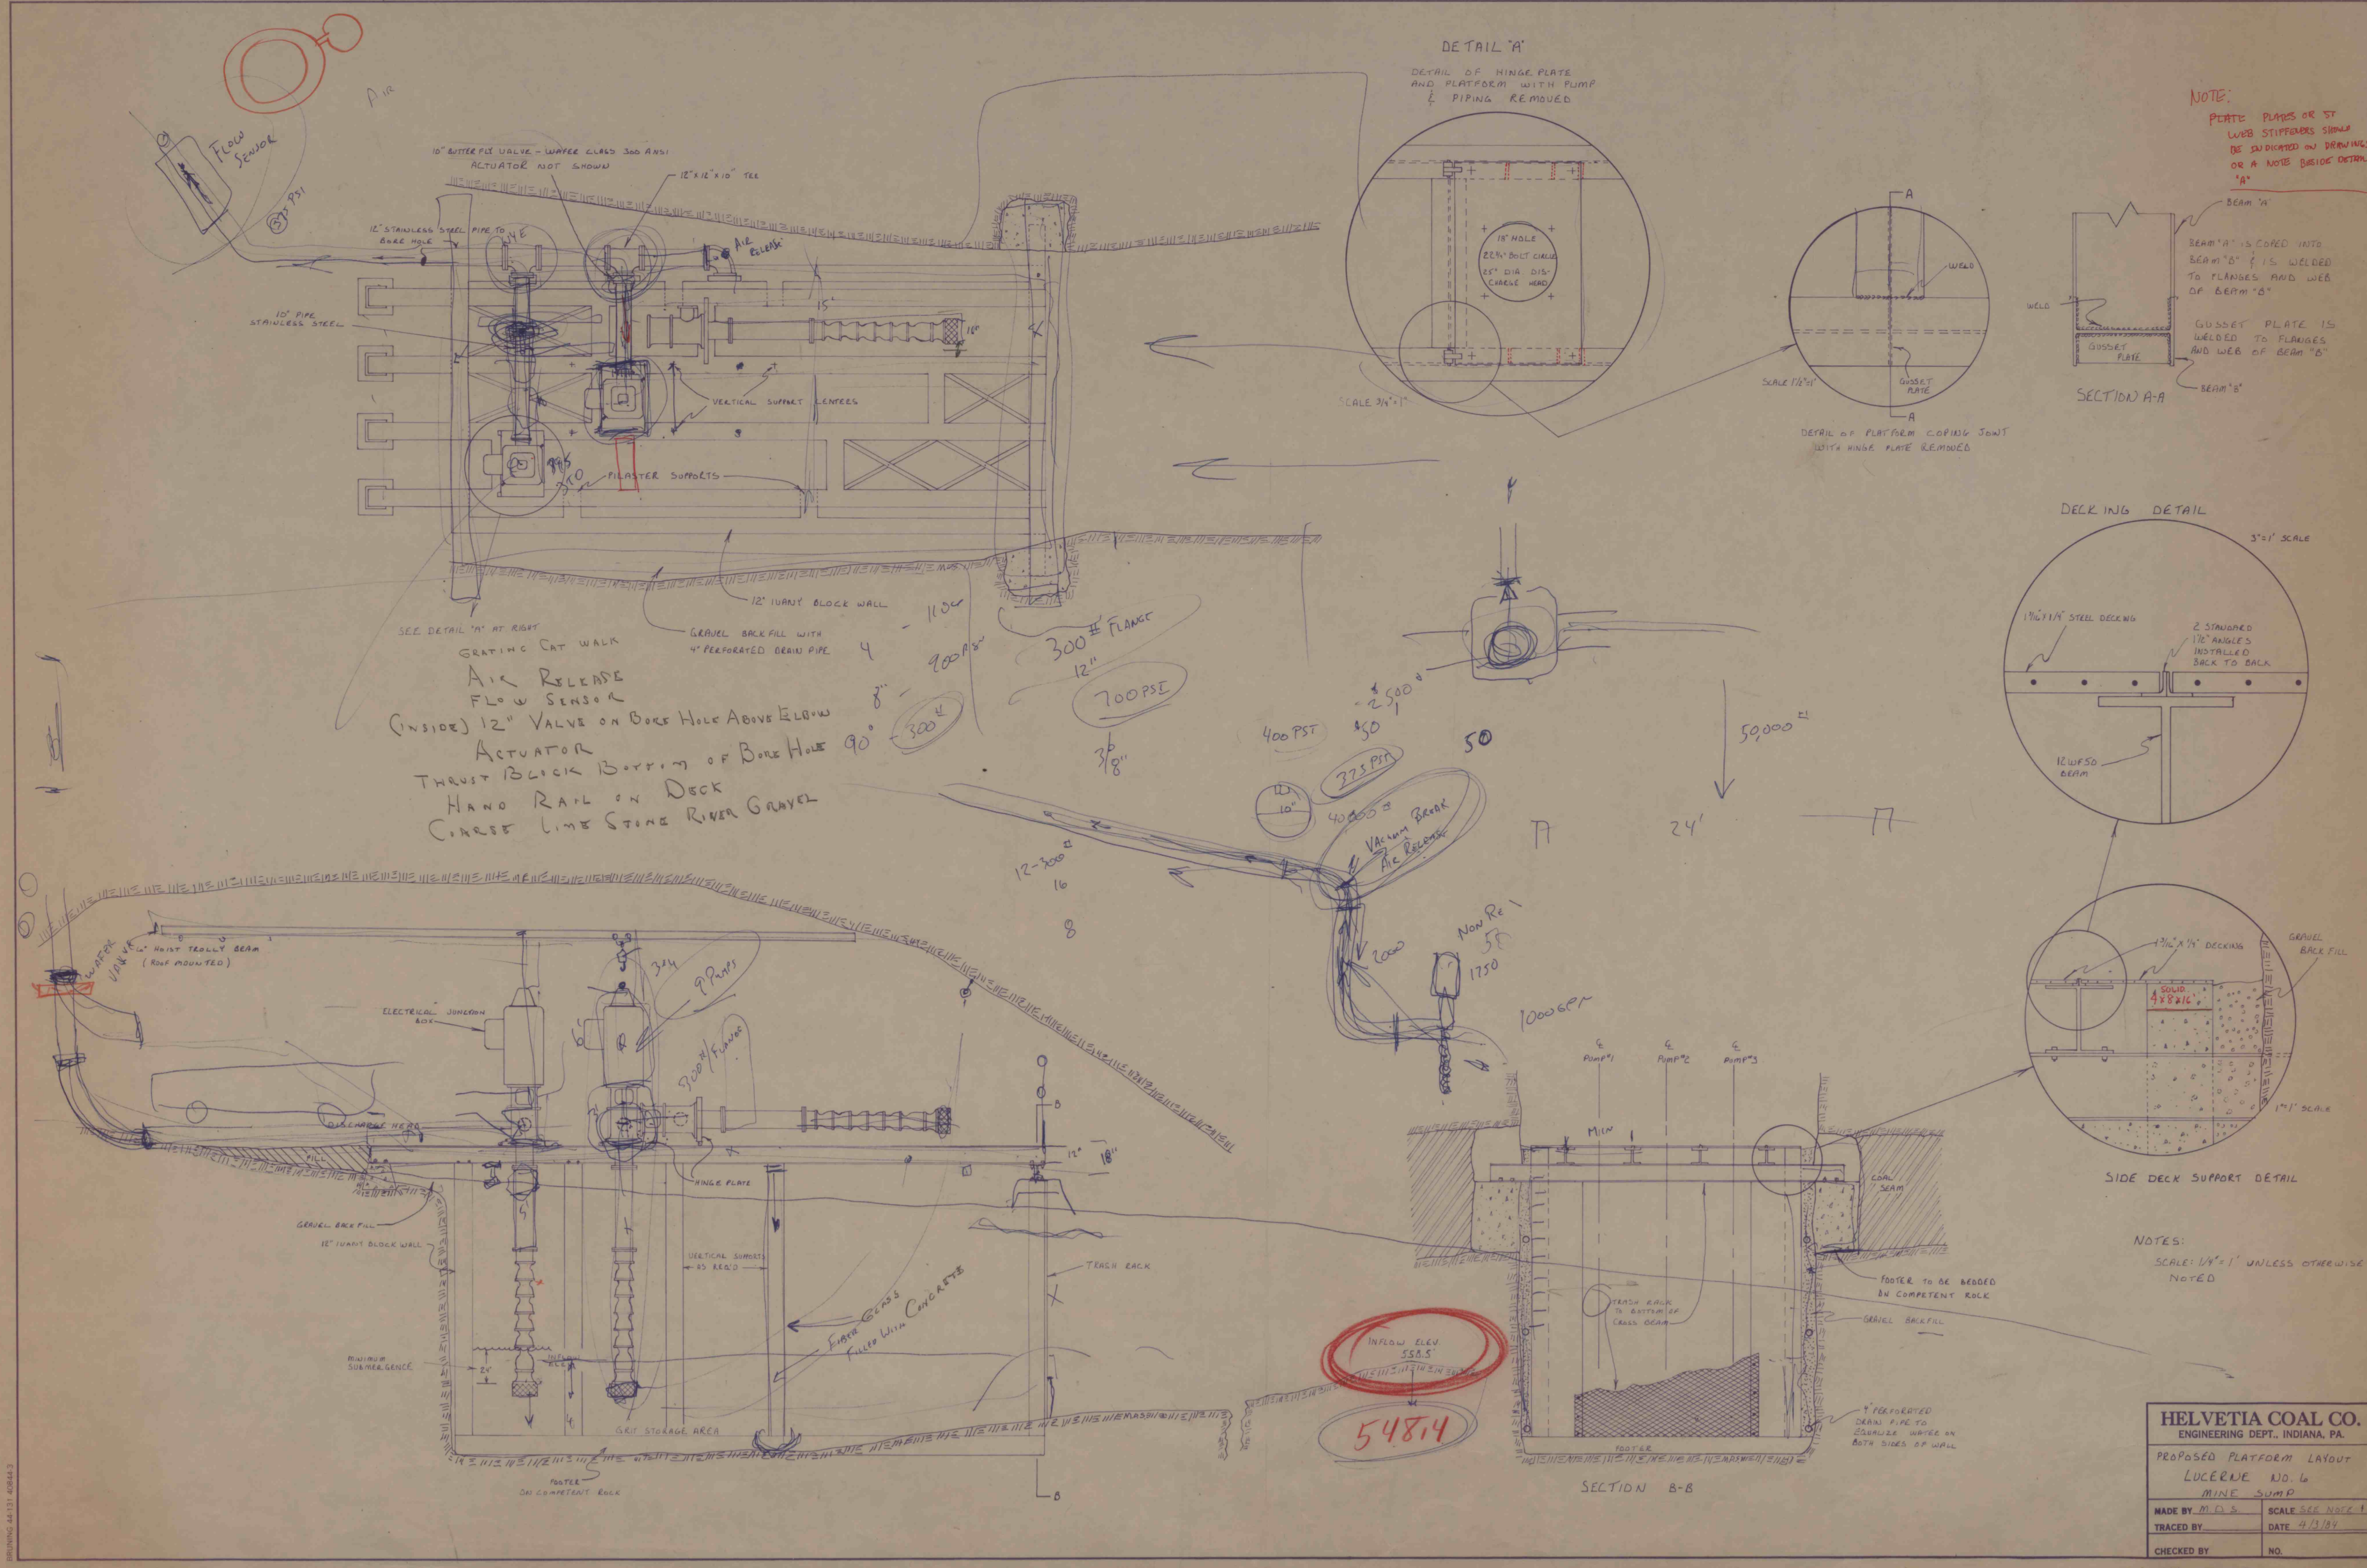

HELVETIA COAL CO.	
ENGINEERING DEPT., INDIANA, PA.	
PROPOSED PLATFORM LAYOUT	
LUCERNE NO. 6	
MINE SUMP	
MADE BY M.D.S.	SCALE SEE NOTE 1
TRACED BY	DATE 4/3/84
CHECKED BY	NO.