
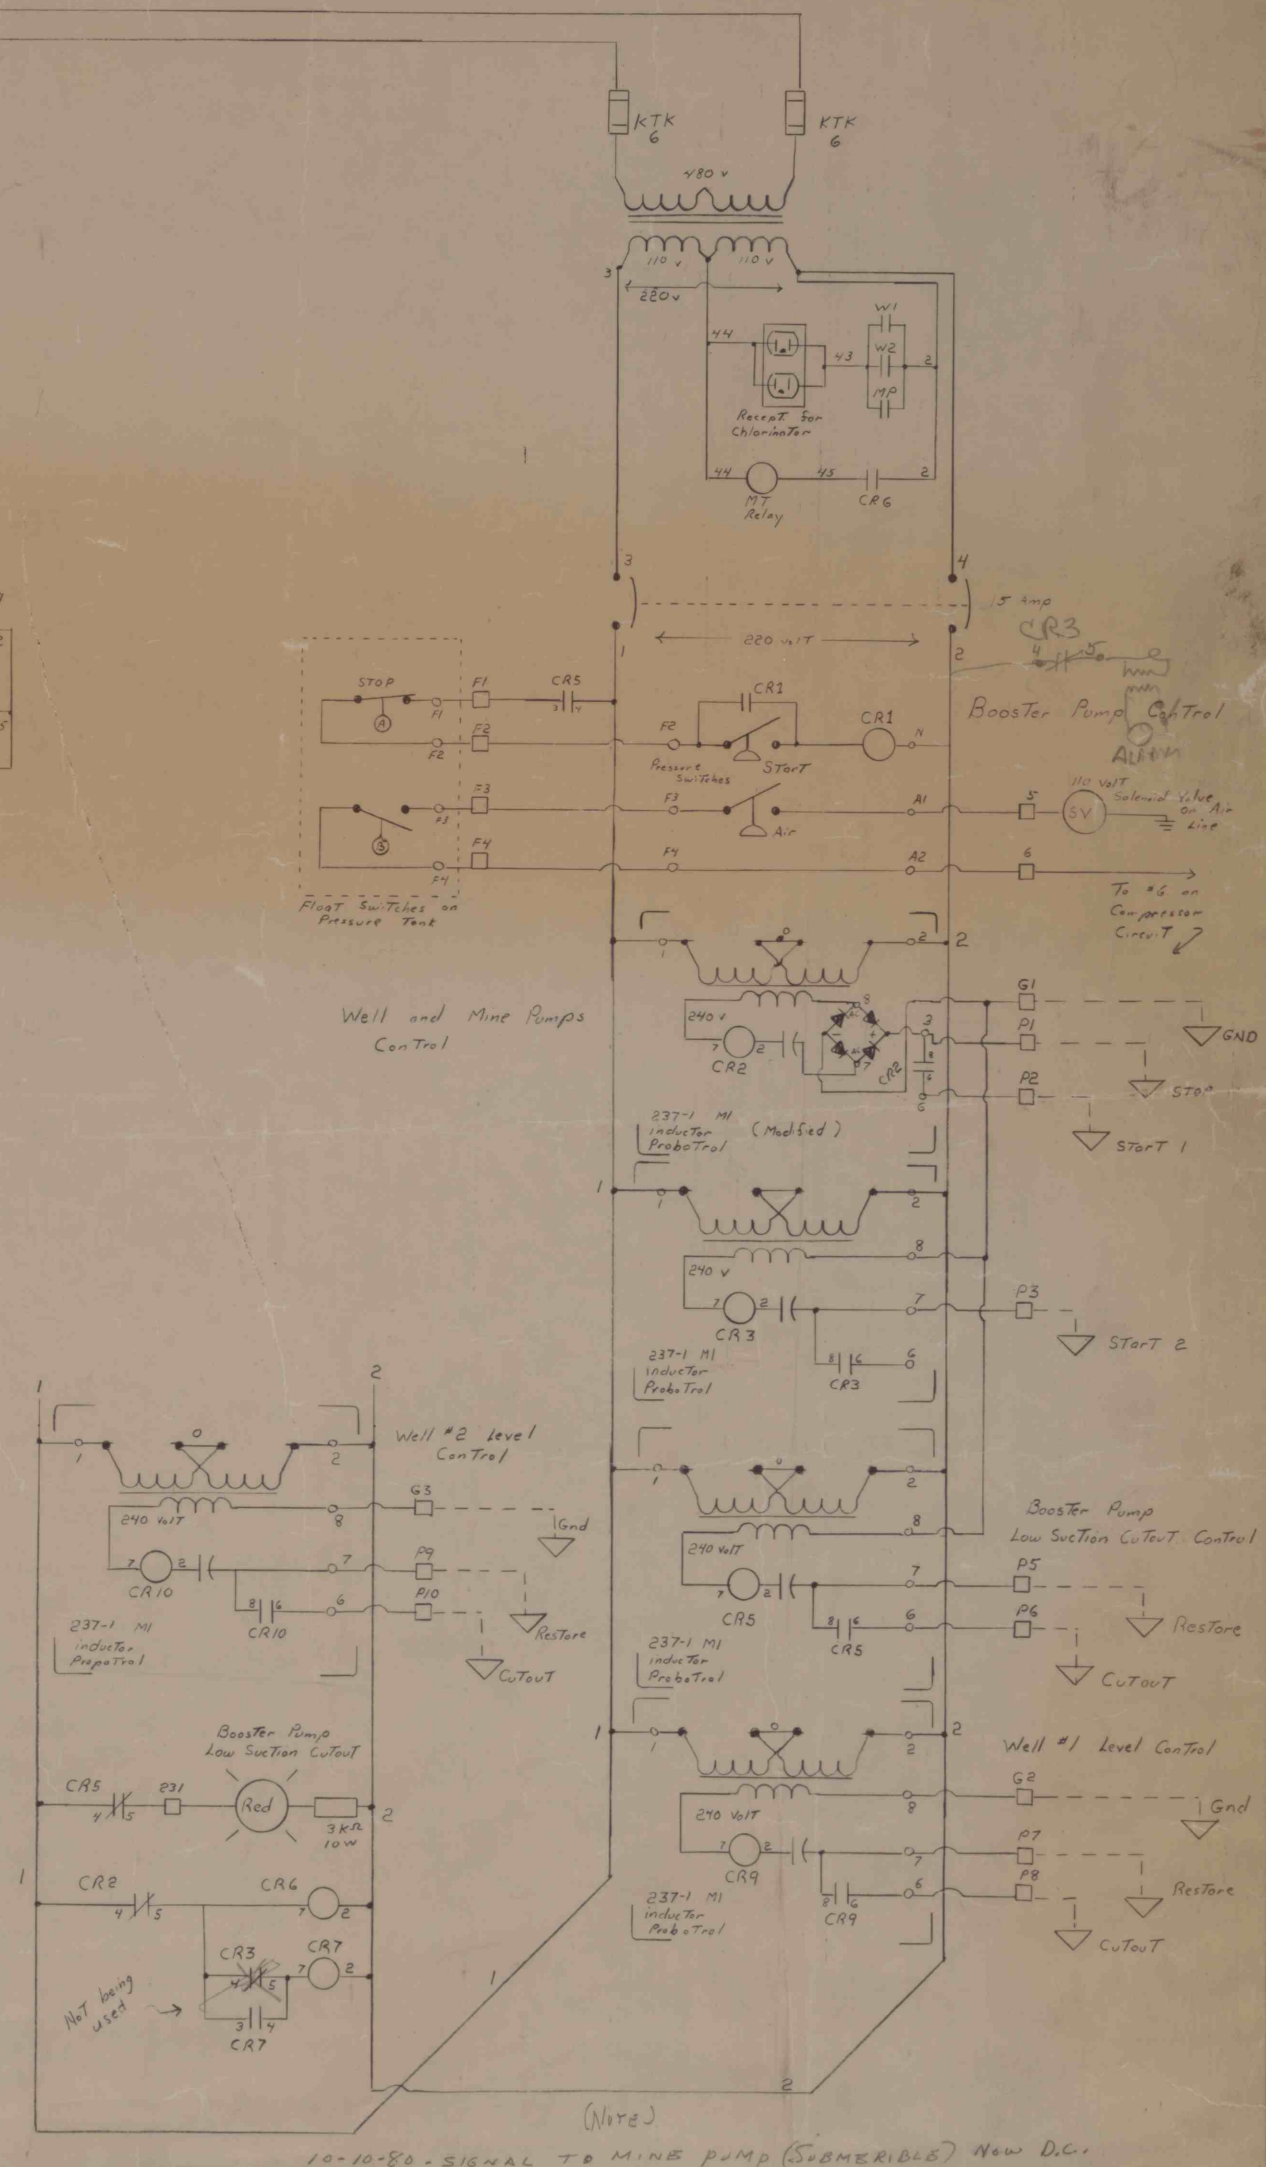
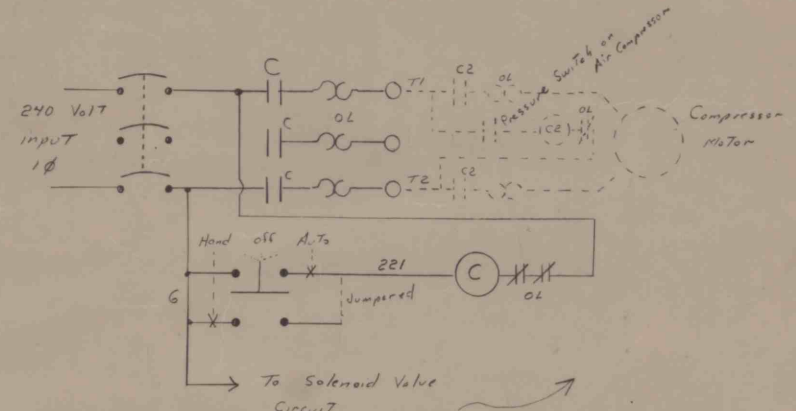
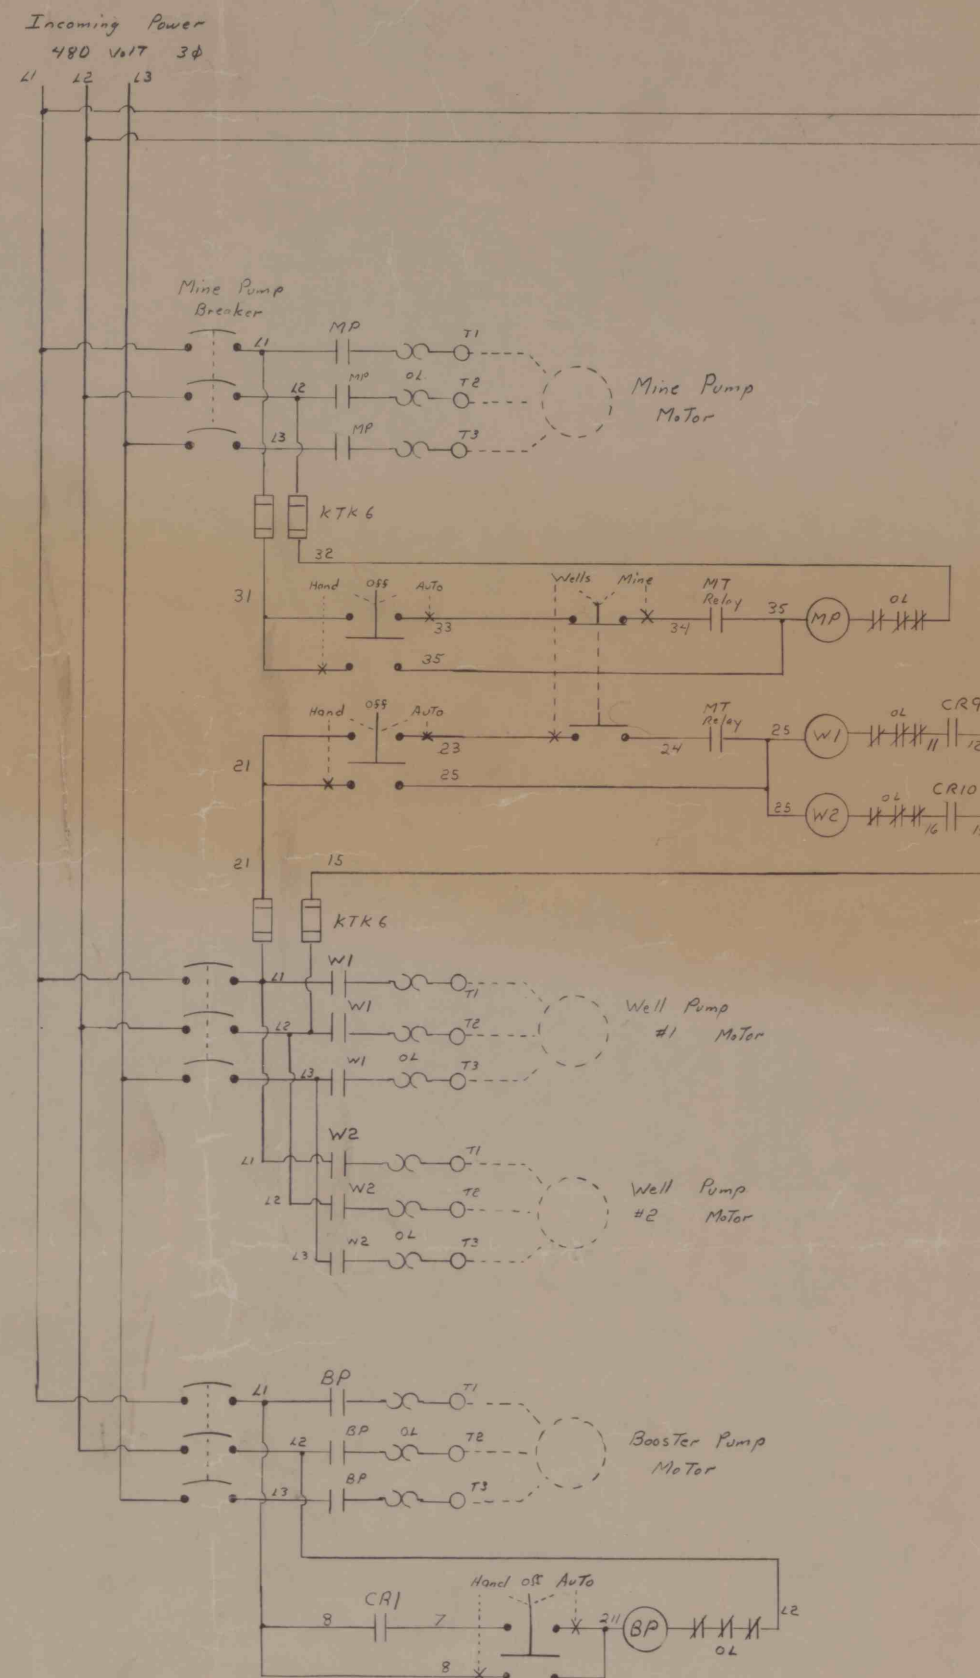


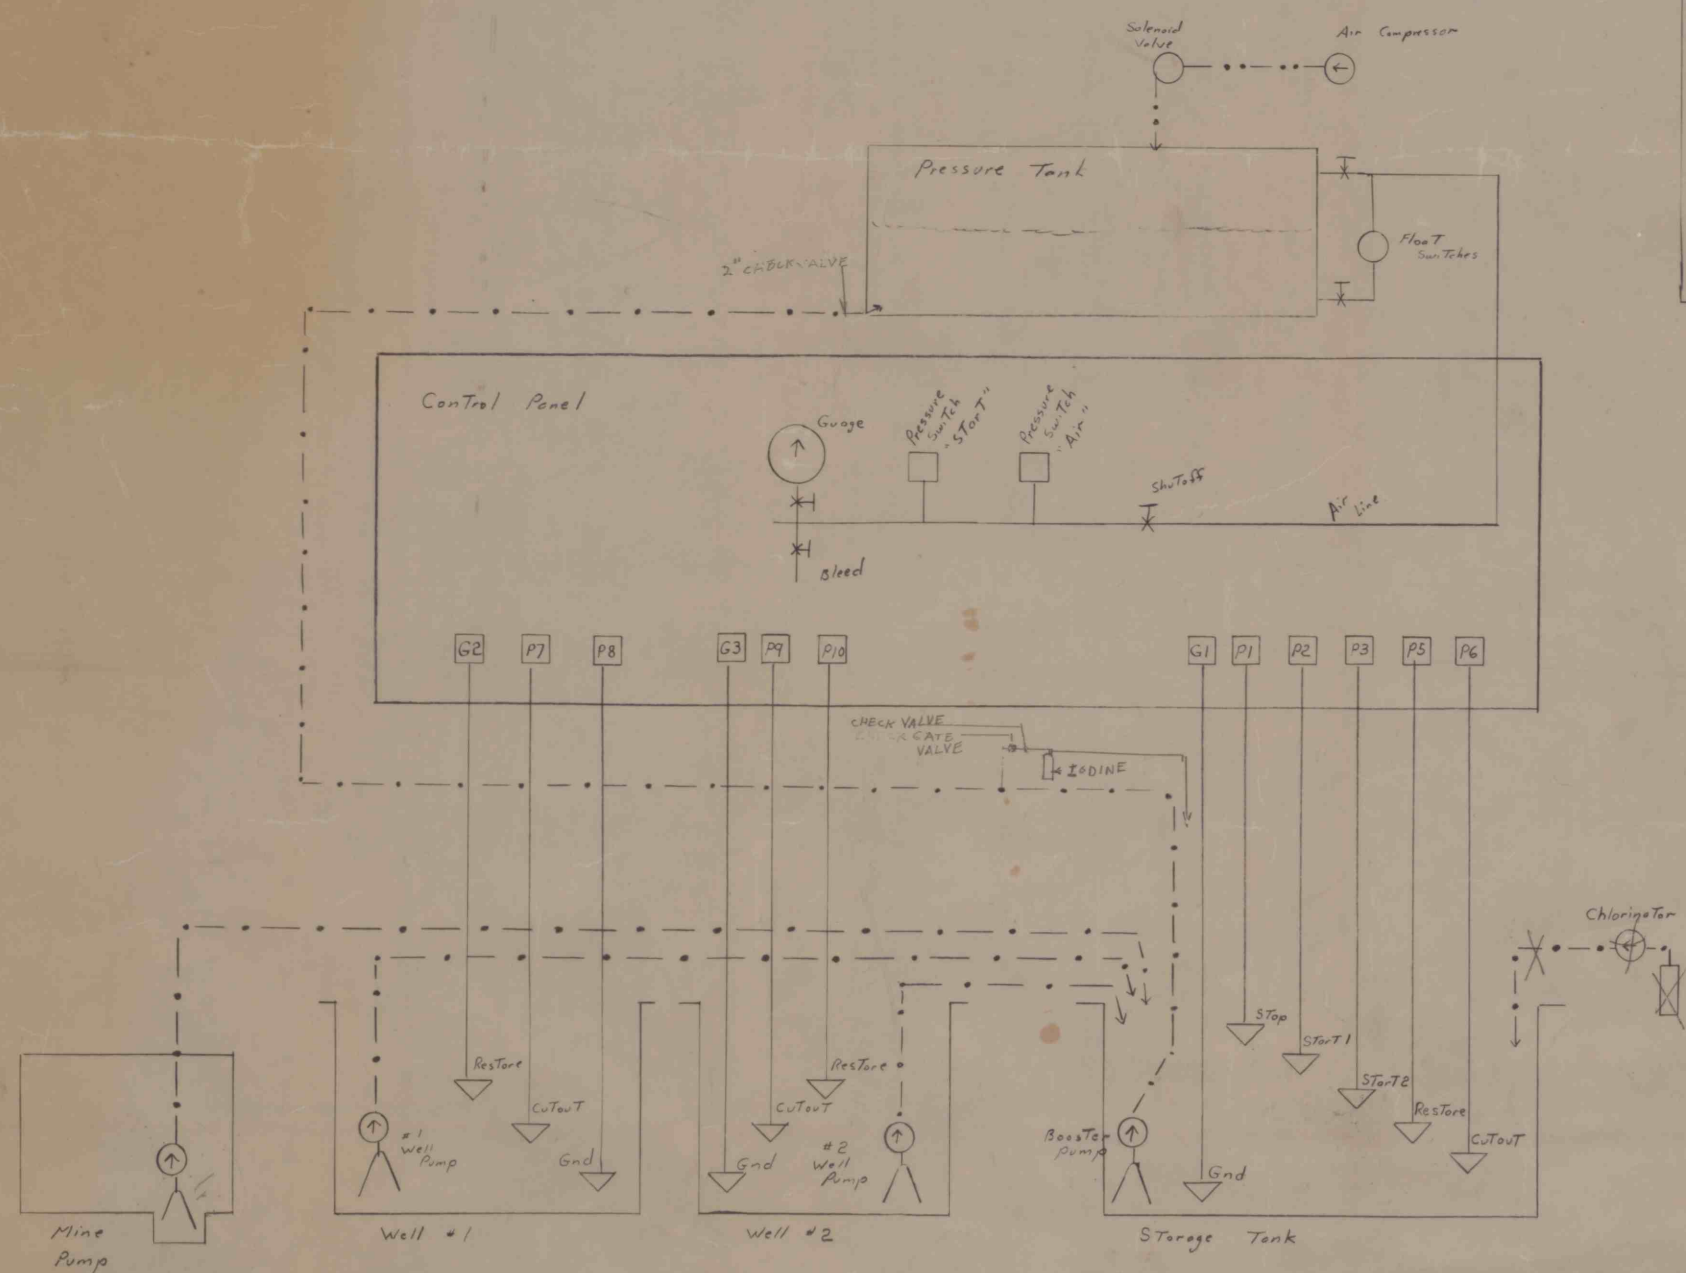

HELVETIA COAL CO.
ENGINEERING DEPT., INDIANA, PA.
Loc #6 2 No. 4 Parts
Fresh Water Pump Control
MADE BY T Strong SCALE ~
TRACED BY DATE 1-10-78
CHECKED BY NO. 662NPH20

IMAPS # 15341