


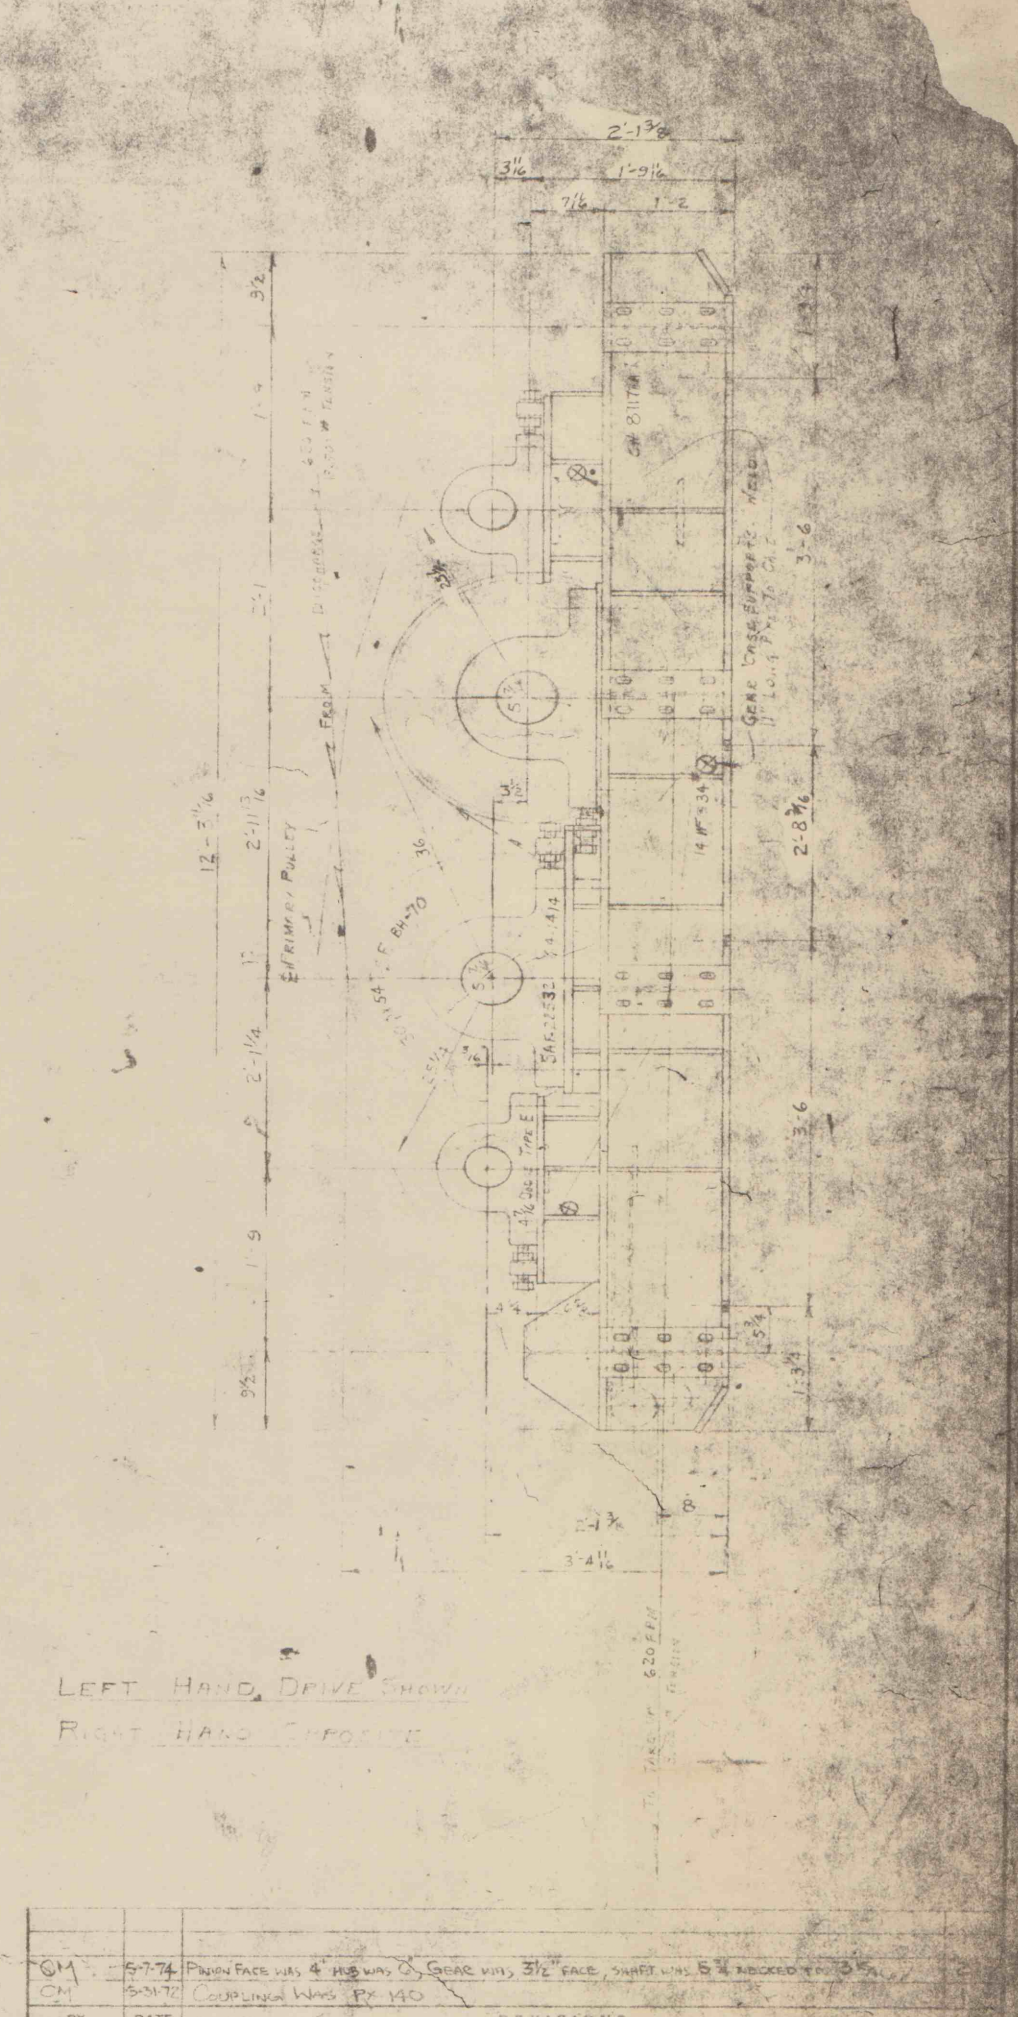

2 GEARS, 72 TEETH, 3" P.D.
200 ST. 3 TEETH, 4" FACE,
6" LONG, 10 HUB, 5 3/8 BORE,
14 X 5 1/2 KEYWAY.

IMAPS # 15357

CM	5-3172	COUPLING WAS PK 140	
BY	DATE	REVISIONS	
 CONTINENTAL CONVEYOR AND EQUIPMENT CO. WINFIELD, ALA.			
THIS DRAWING IS DESIGN AND DETAIL IS FREE PROPERTY OF CONTINENTAL CONVEYOR AND EQUIPMENT CO. IT IS TO BE USED ONLY IN CONNECTION WITH OUR SERVICE. NO REUSE OF DESIGN OR INVENTION ARE PERMITTED.		REMOTE DRIVE ASSEMBLY Q1AL 125 111 1546446 8645 FOR 10129-2 10129-2 NATIONAL MFG. CO.	8712