


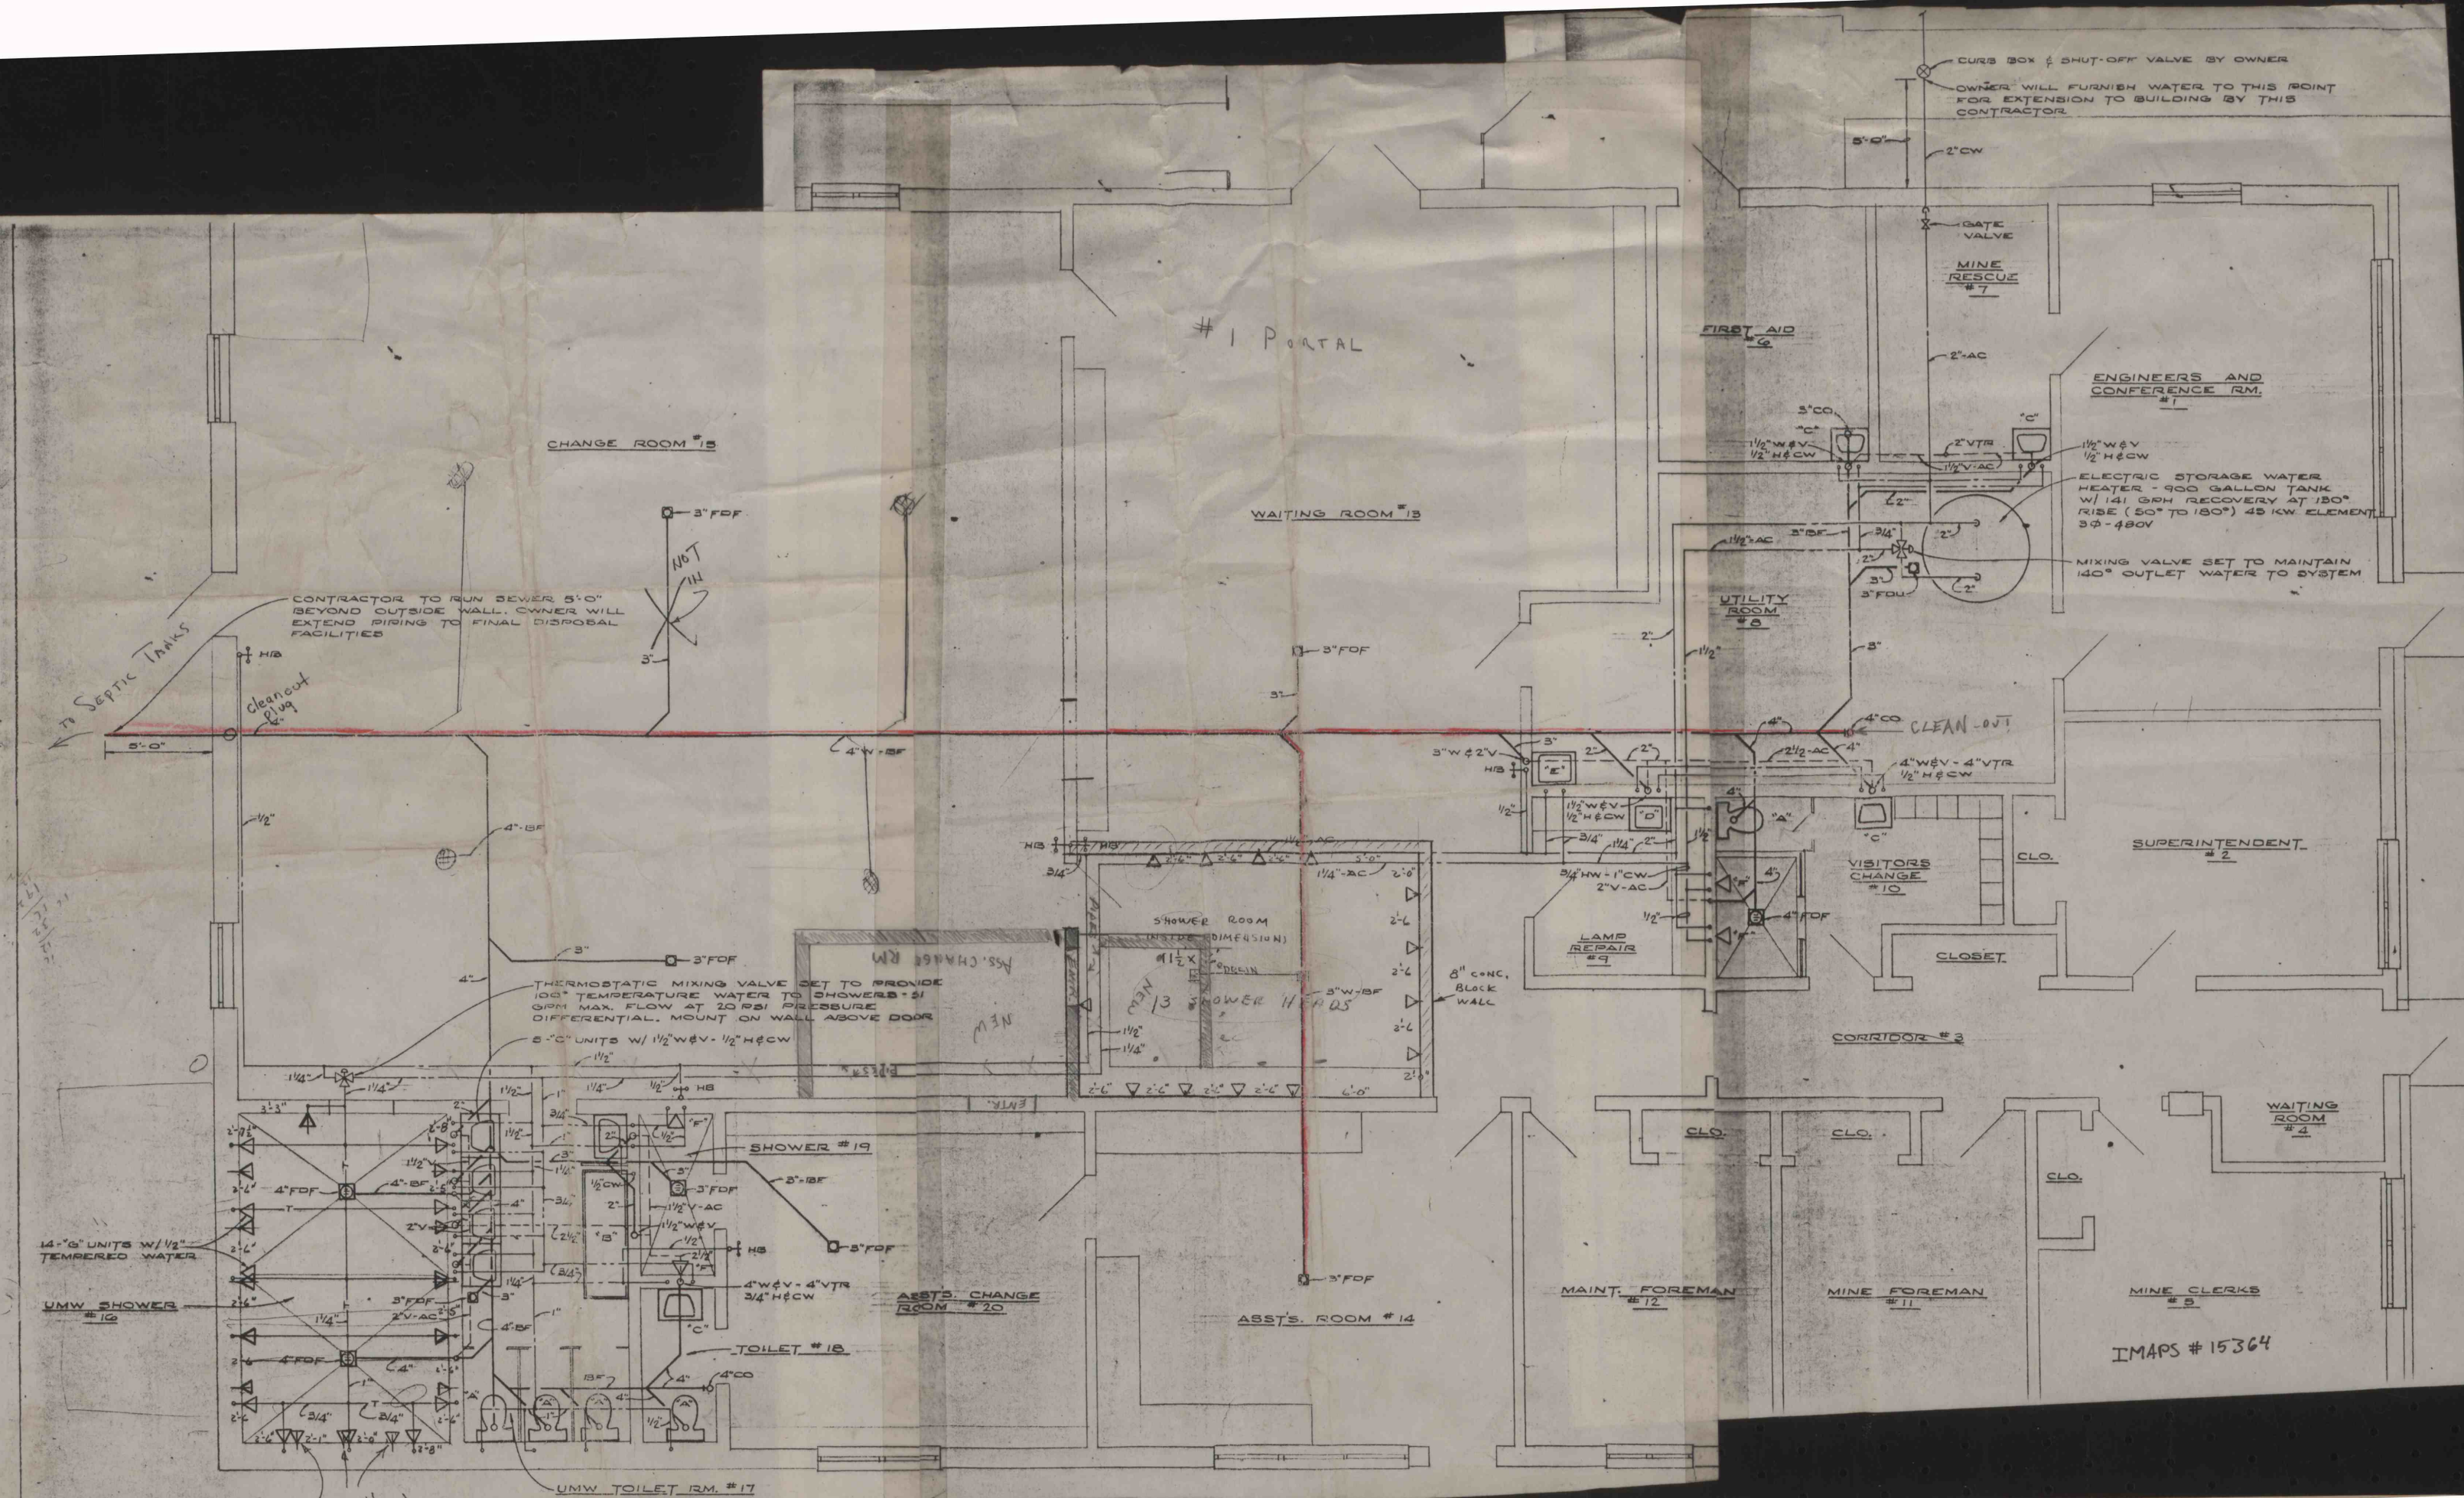

#1 PORTAL

CHANGE ROOM #15

WAITING ROOM #13

FIRST AID #6

MINE RESCUE #7

ENGINEERS AND CONFERENCE RM. #1

ELECTRIC STORAGE WATER HEATER - 900 GALLON TANK W/ 141 GPH RECOVERY AT 180° RISE (50° TO 180°) 45 KW. ELEMENT 3Φ-480V

MIXING VALVE SET TO MAINTAIN 140° OUTLET WATER TO SYSTEM

UTILITY ROOM #8

VISITORS CHANGE #10

SUPERINTENDENT #2

CORRIDOR #3

WAITING ROOM #4

MAINT. FOREMAN #12

MINE FOREMAN #11

MINE CLERKS #5

IMAPS #15364


UMW TOILET RM. #17

ASST'S. CHANGE ROOM #20

ASST'S. ROOM #14

SHOWER #19

SHOWER ROOM (INSIDE DIMENSIONS)


CONTRACTOR TO RUN SEWER 5'-0" BEYOND OUTSIDE WALL. OWNER WILL EXTEND PIPING TO FINAL DISPOSAL FACILITIES

NOT IN

CURB BOX & SHUT-OFF VALVE BY OWNER
OWNER WILL FURNISH WATER TO THIS POINT FOR EXTENSION TO BUILDING BY THIS CONTRACTOR

GATE VALVE

2" CW

2" AC

2" VTR

2" AC

2" AC

