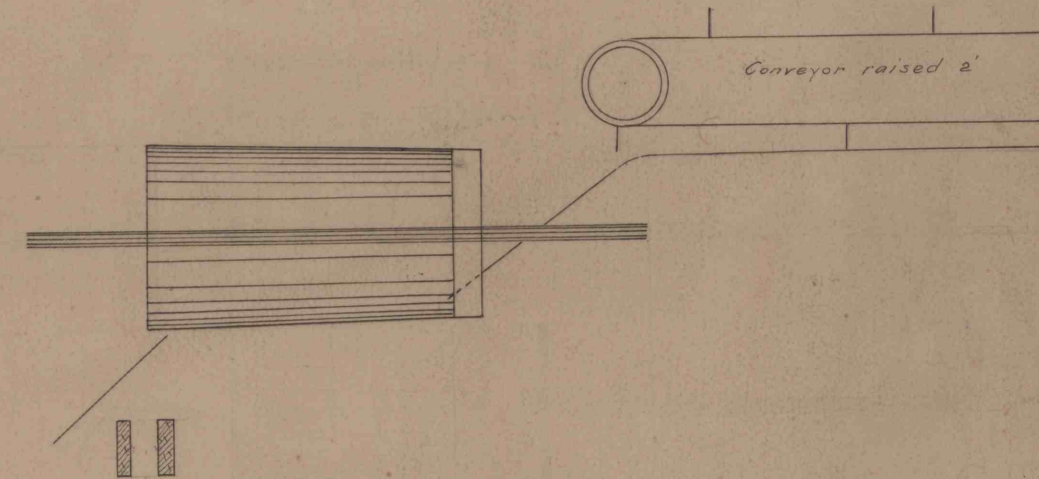
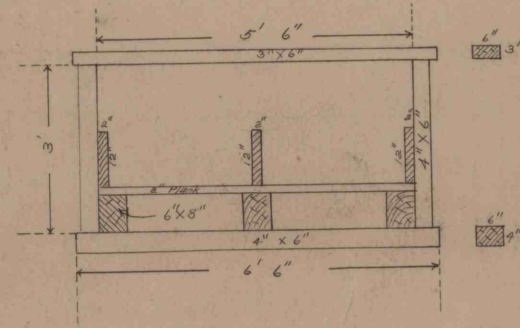


Plan for screening and preparing slack
at Byrnedale Washer, showing revolving screen
and proposed Riffle Trough with section of same.
January 12th 1965. Scale 1/4" = 1 Foot