


No. 471
A. R. M. Co. - Tracing from
B-R of Cobough Colly Co.
Traced - Jan. 17 - 1910
" by W. R. C.

— SHICK —

— BROWN —

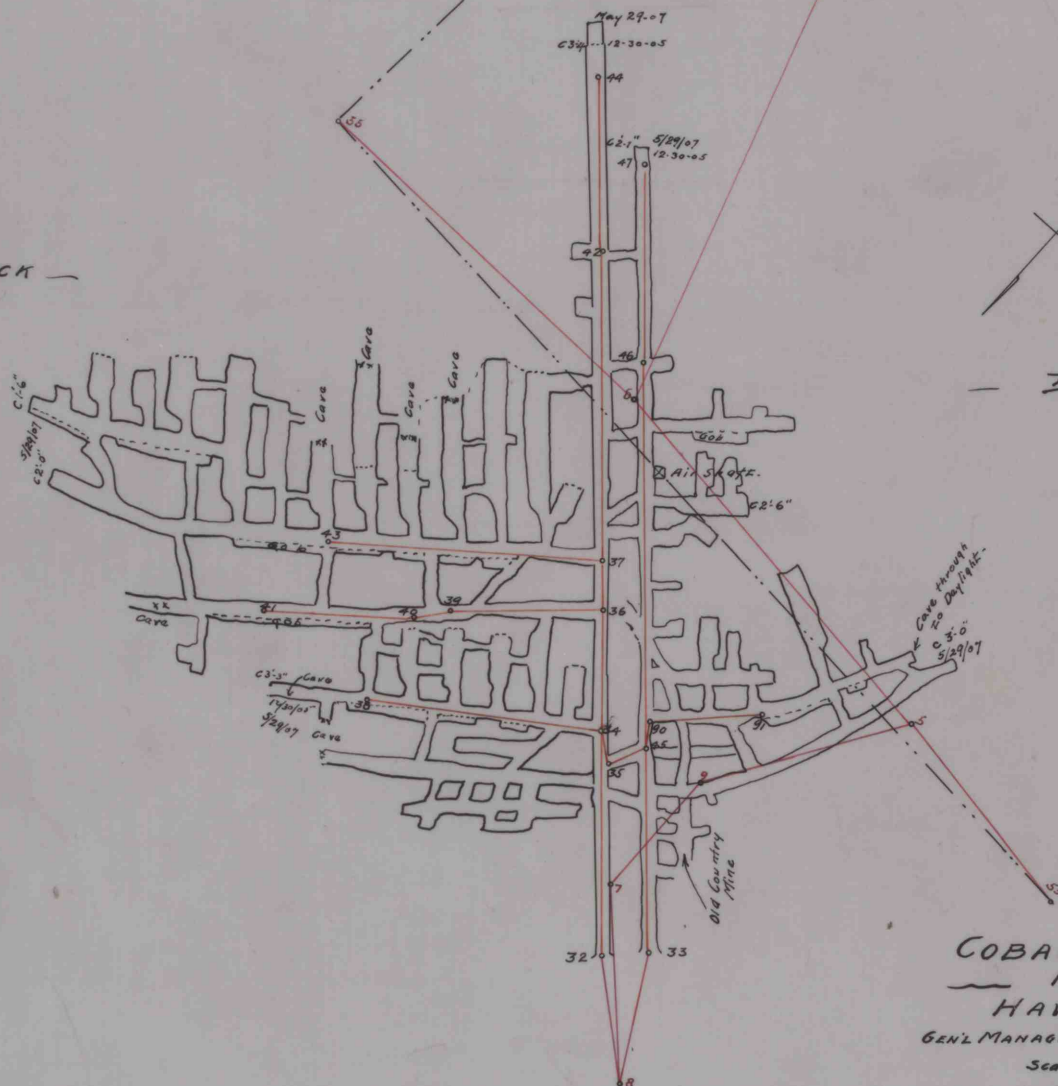

COBAUGH COLLIERY CO.
MINE No 2
HAWTHORN, PA.

GEN'L MANAGERS OFFICE. Du Bois, Pa. Jan 6. 06.
" " " " June. 07.
Scale 1" = 100'

MAPS # 15382