


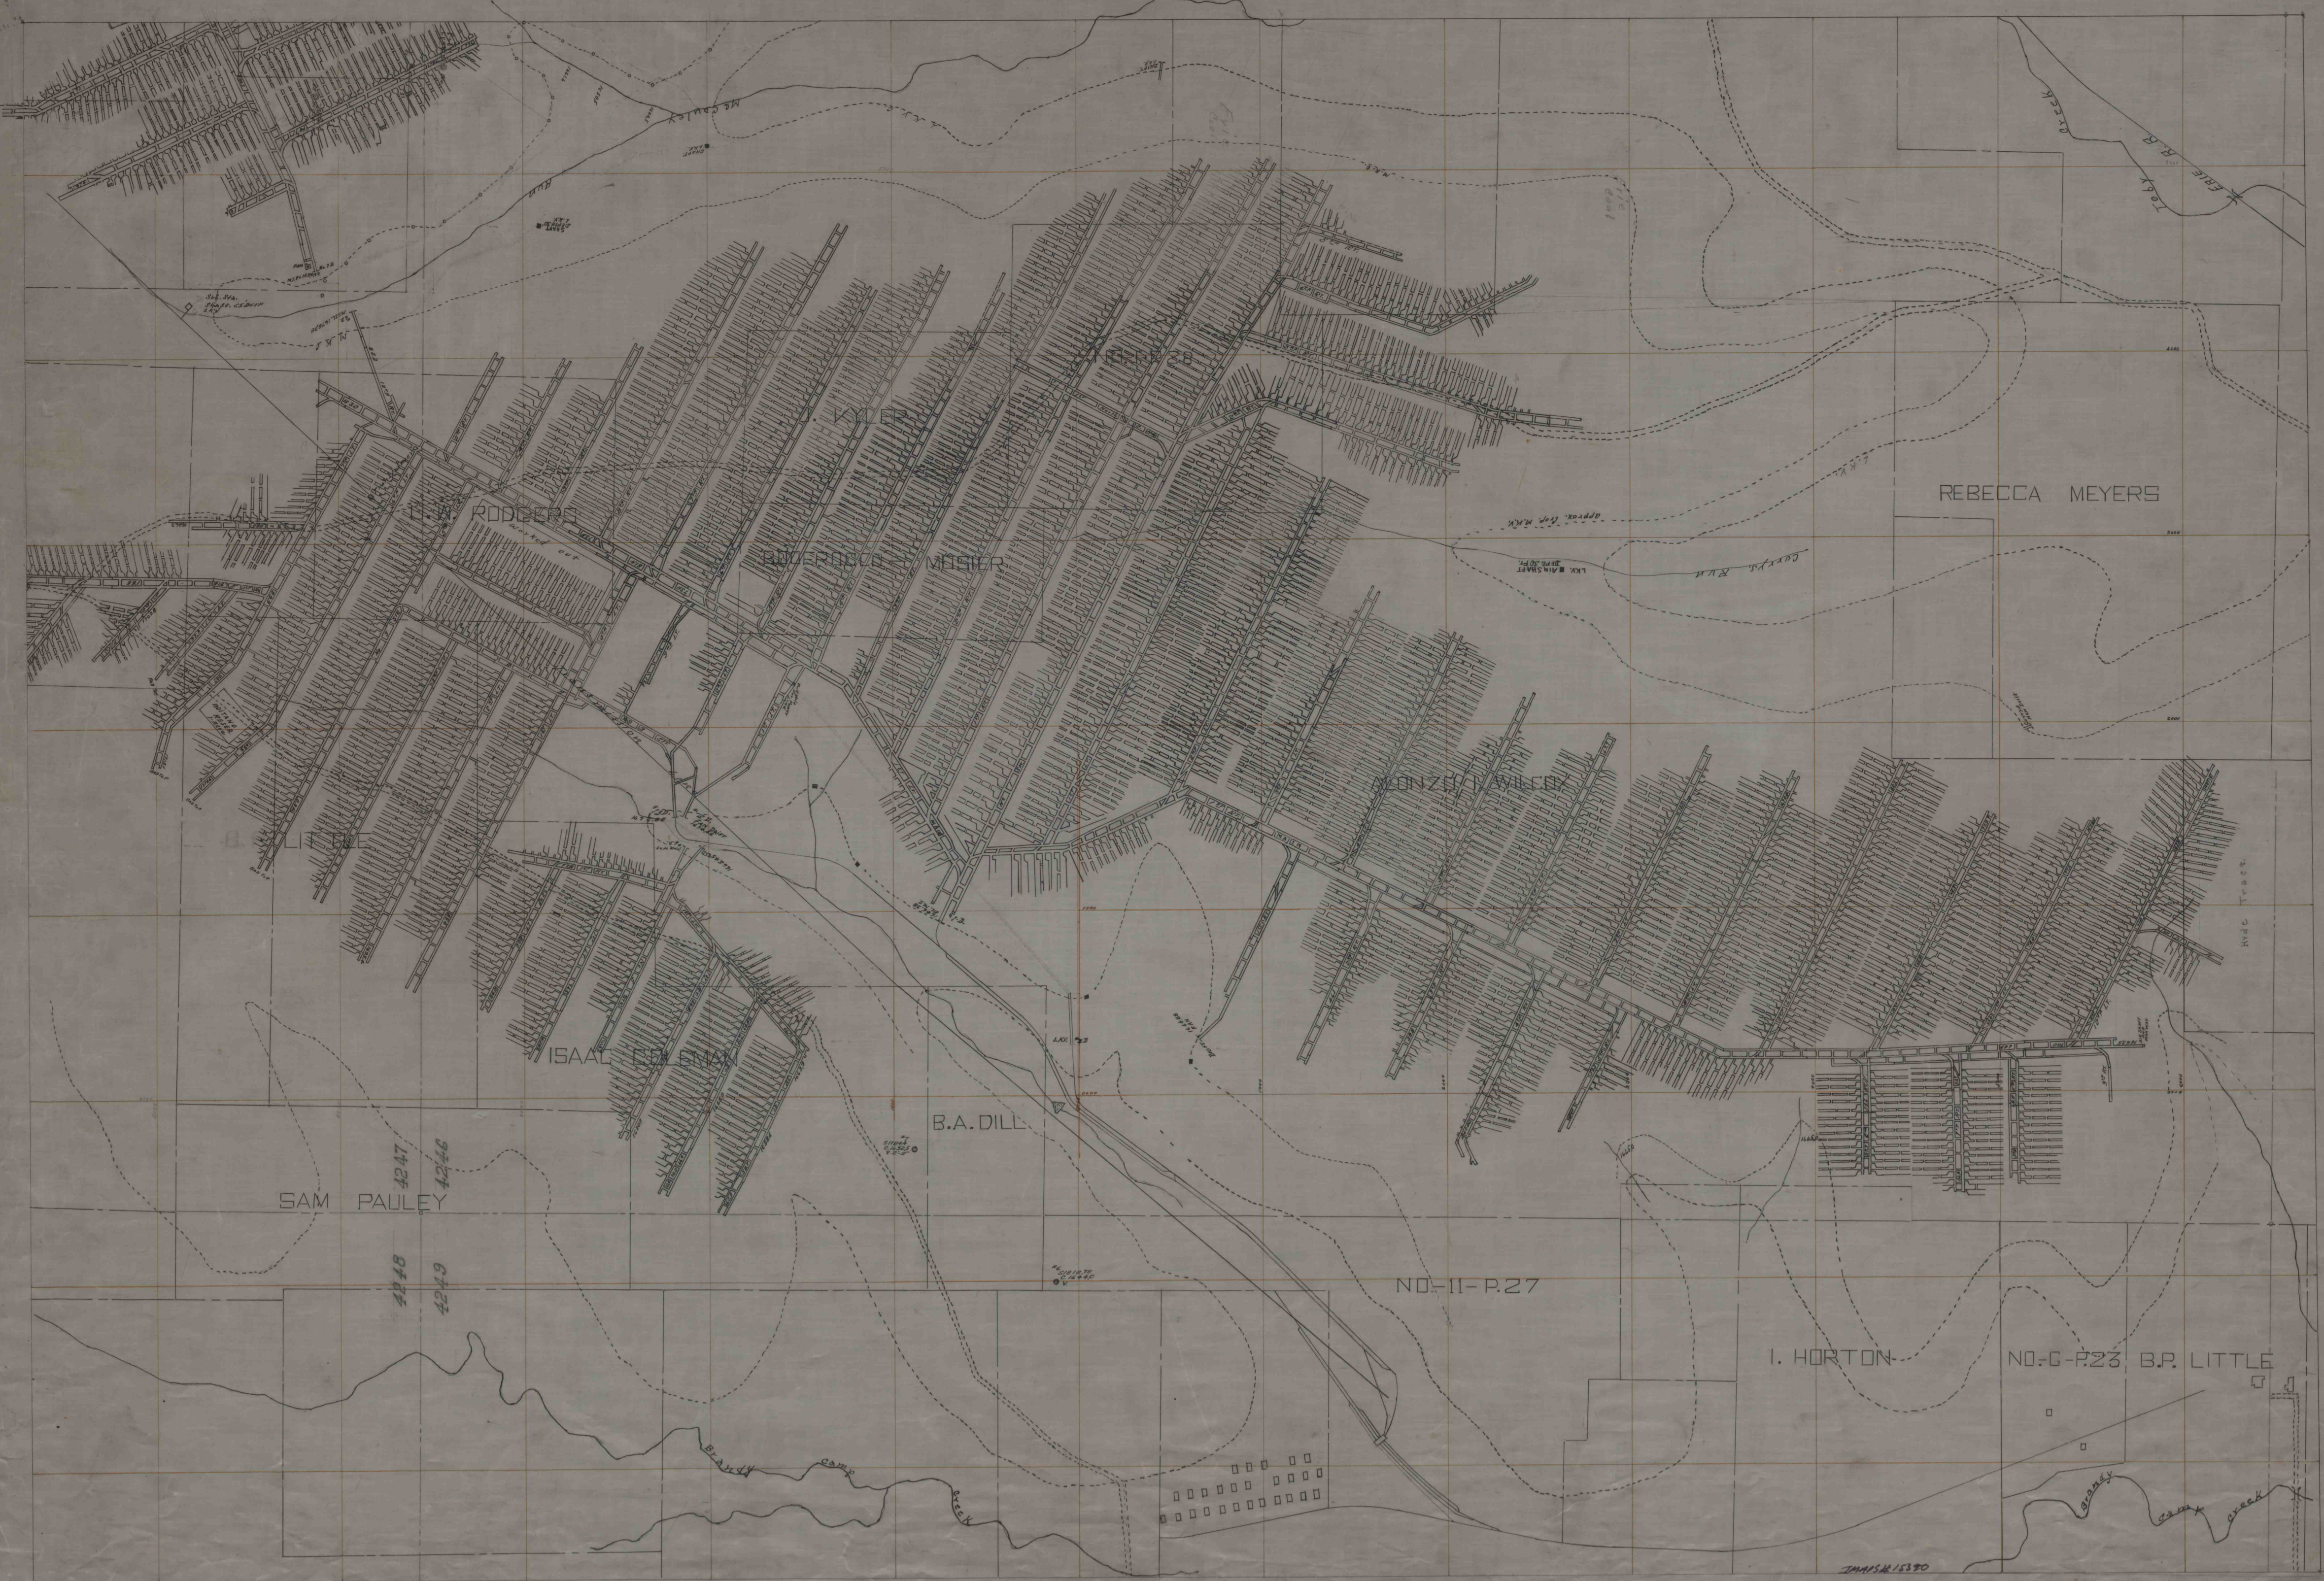

SAM PAULEY

4246
4247
4248
4249


B.A. DILL

NO-II-P.27

I. HORTON

NO-G-P.23 B.P. LITTLE

REBECCA MEYERS

