565-4

N.W. M. & E. Co.
DAGUS MINES, PA.

Sketch of No 2 Slope new Workings with reference to N.W. M. & E. Co. old workings and Meredith Run Coal Co. old workings.
Scale 1" = 400'

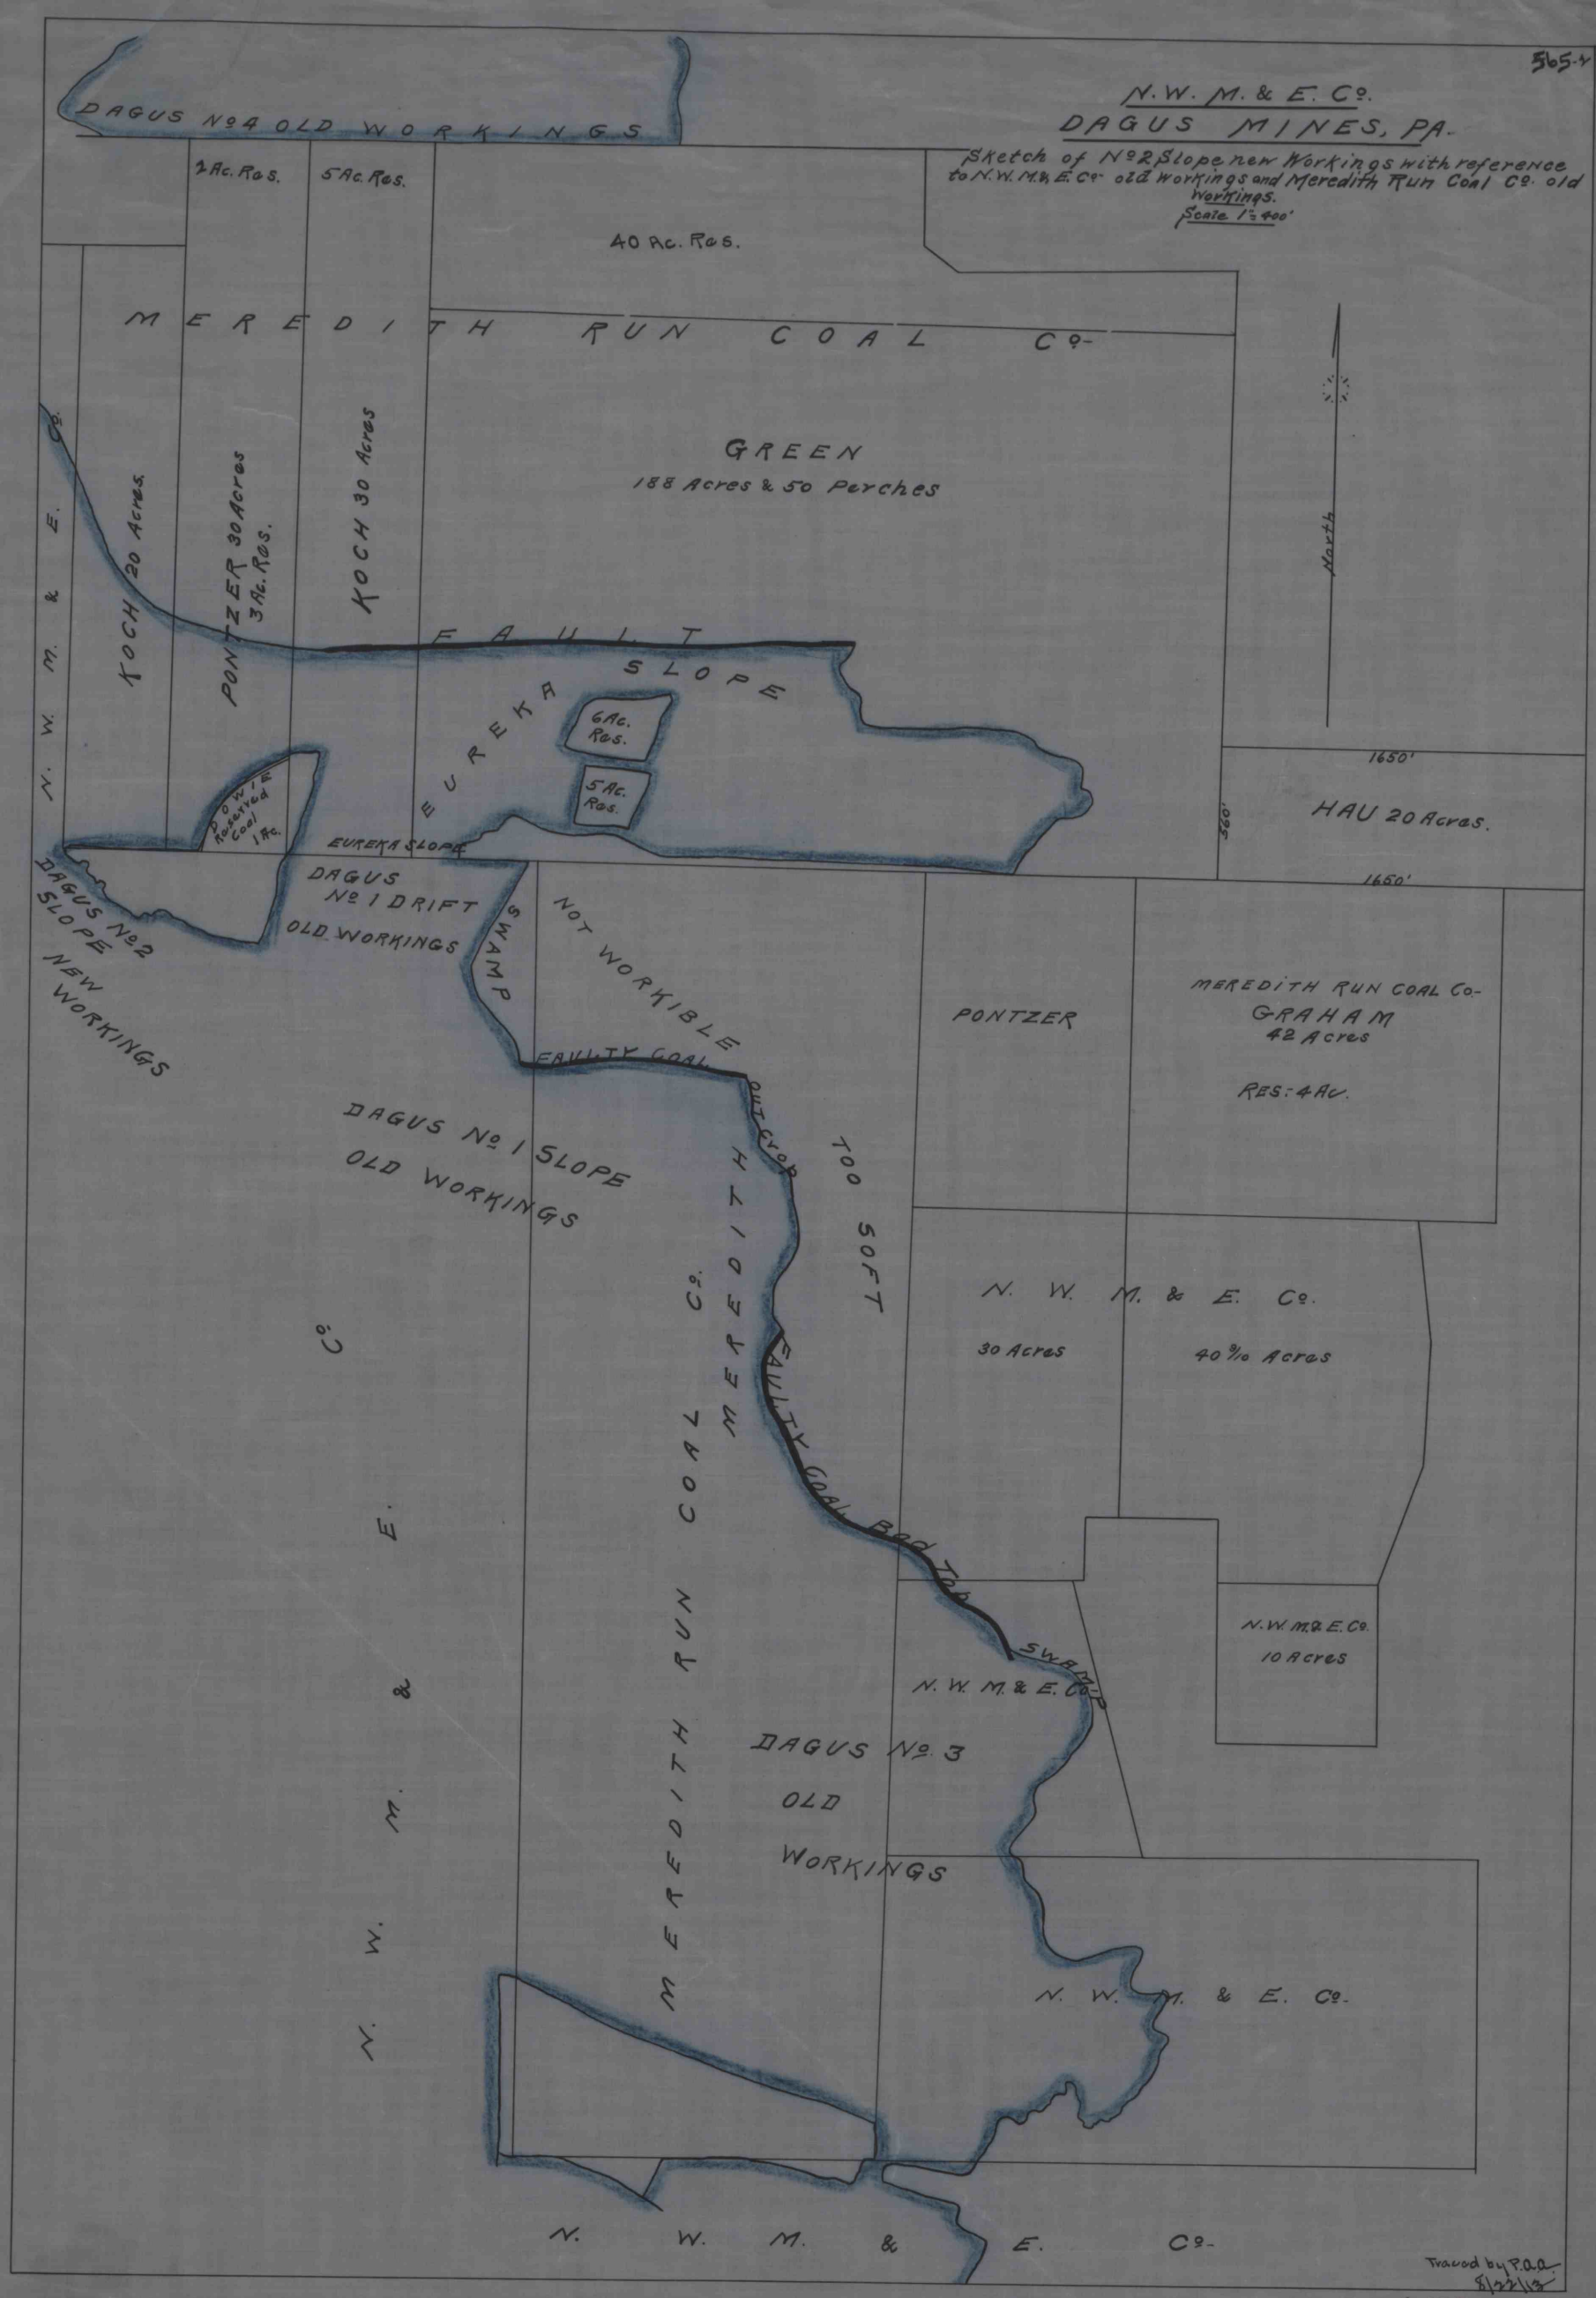

Traced by P.O.C.
8/22/13

IMAPS # 15398