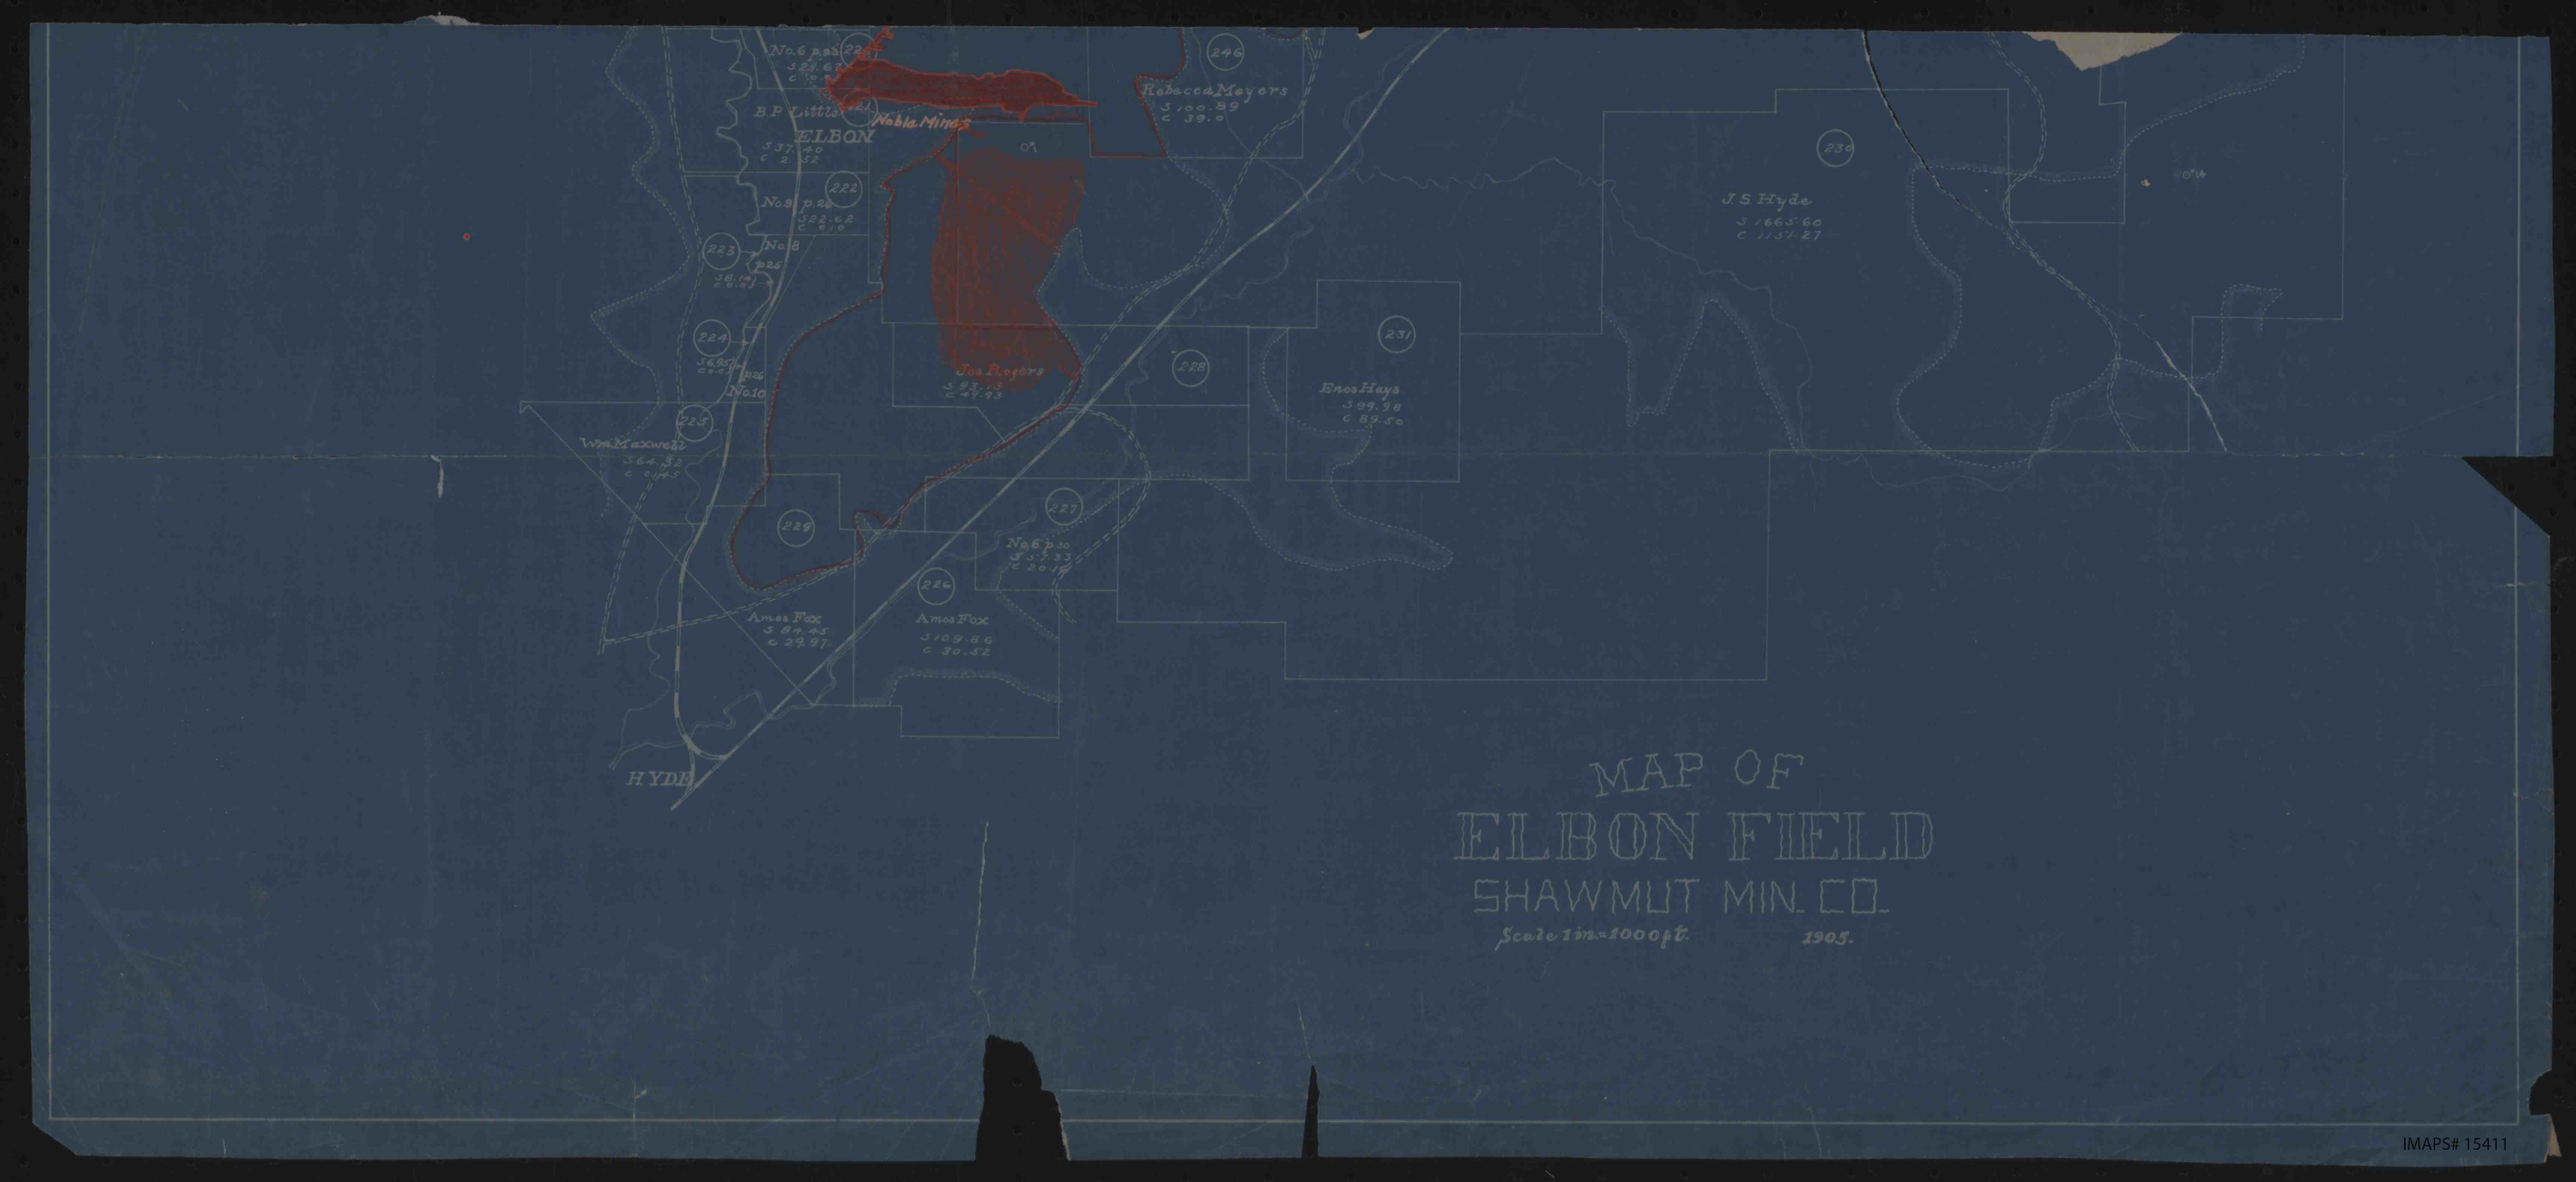
MAP OF
ELBON FIELD
SHAWMUT MIN. CO.
Scale 1 in.=1000 ft.
1905.
ELBON
Noble Mines
B.P. Little
No.6 p.23
No.9 p.26
No.8 p.25
No.10 p.24
Rebecca Meyers
S 100.89
C 39.0
J.S. Hyde
S 1665.60
C 1137.27
Enos Hays
S 99.98
C 89.50
Jos. Rogers
S 93.13
C 49.93
Wm. Maxwell
S 64.42
C 9.45
Amos Fox
S 84.45
C 29.97
Amos Fox
S 109.86
C 30.52
No.6 p.30
S 57.33
C 20.19
HYDE
230
231
228
227
226
229
225
224
223
222
246

IMAPS# 15411