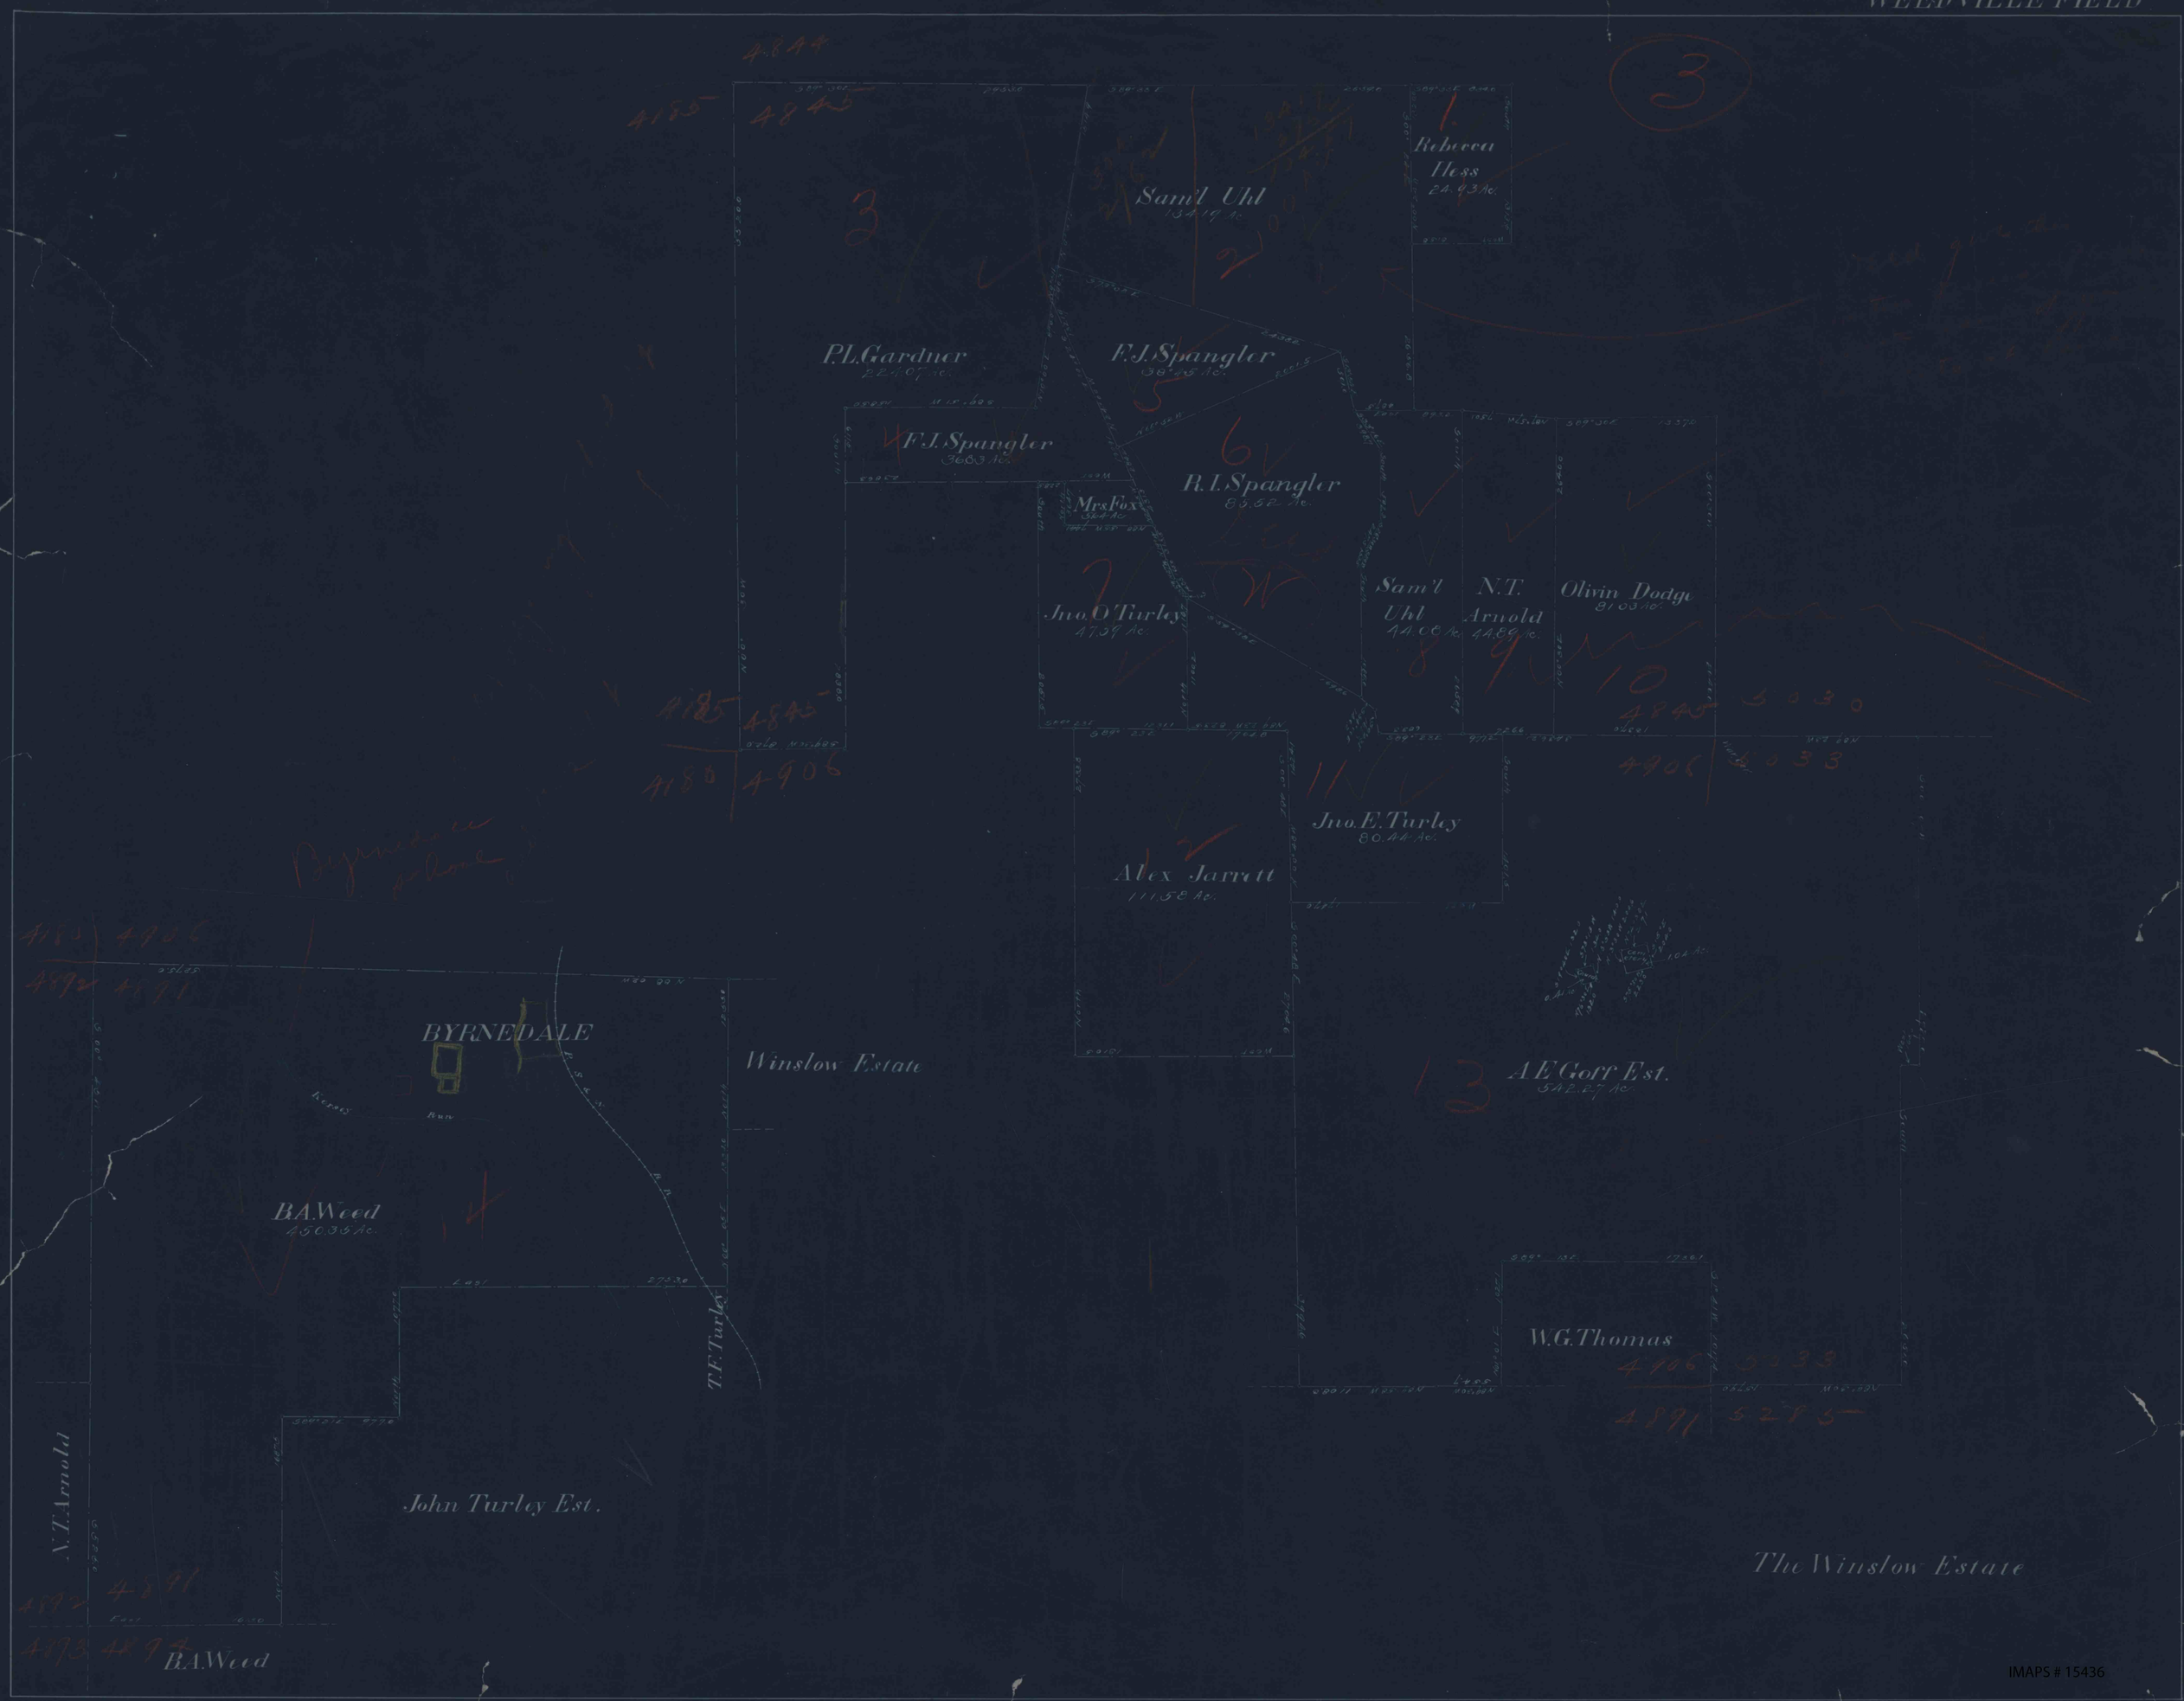
Sam'l Uhl
Rebecca Hess
24.93 Ac.
P.L. Gardner
F.J. Spangler
F.J. Spangler
3663 Ac.
R.I. Spangler
Mrs Fox
Jno. O. Turley
47.99 Ac.
Sam'l Uhl
44.08 Ac.
N.T. Arnold
44.89 Ac.
Olivin Dodge
81.03 Ac.
Jno. E. Turley
80.44 Ac.
Alex Jarrett
111.58 Ac.
BYRNEDALE
Winslow Estate
A.E. Goff Est.
542.27 Ac.
B.A. Weed
450.35 Ac.
T.F. Turley
W.G. Thomas
John Turley Est.
N.T. Arnold
B.A. Weed
The Winslow Estate

IMAPS # 15436