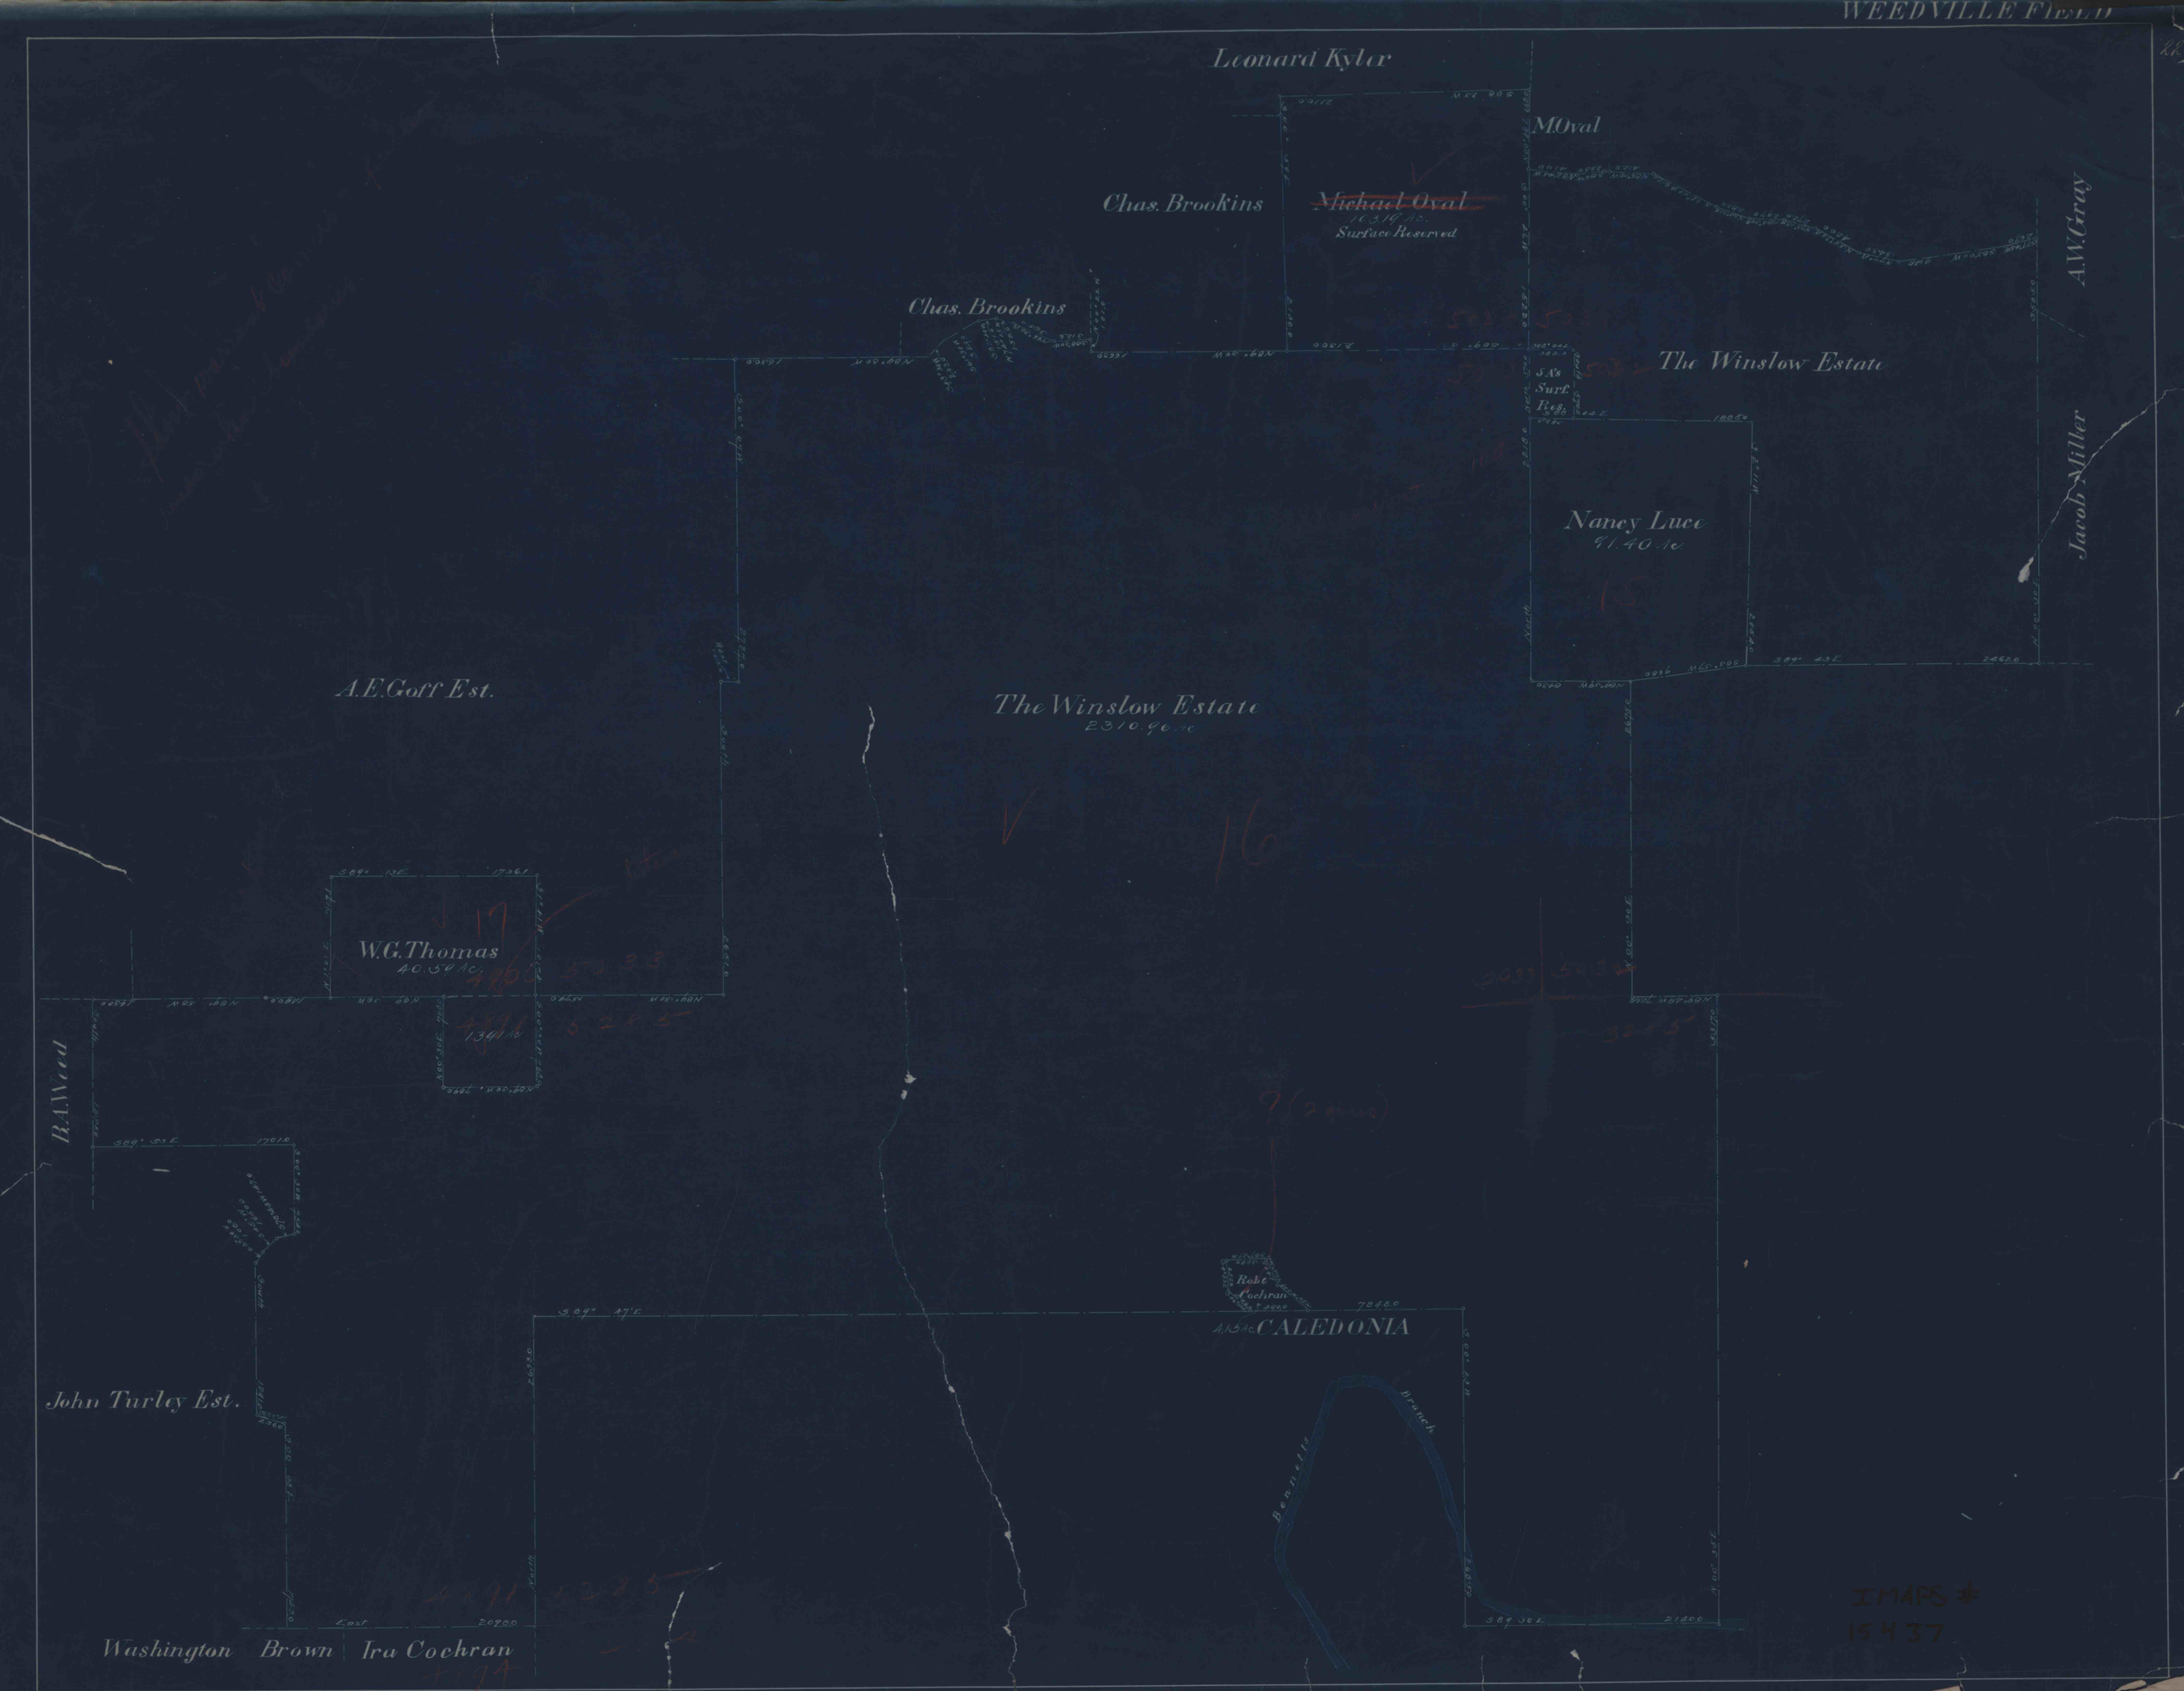
Leonard Kyler
M. Oval
Chas. Brookins
~~Michael Oval~~
16.319 Ac.
Surface Reserved
Chas. Brookins
A.M. Gray
The Winslow Estate
5 As Surf. Res.
Nancy Luce
91.40 Ac.
Jacob Miller
A.E. Goff Est.
The Winslow Estate
2310.90 Ac.
W.G. Thomas
40.54 Ac.
R.A. Weed
John Turley Est.
Robt Cochran
41.54 Ac.
CALEDONIA
Bennetts Branch
Washington Brown
Ira Cochran

IMAPS #
15437