


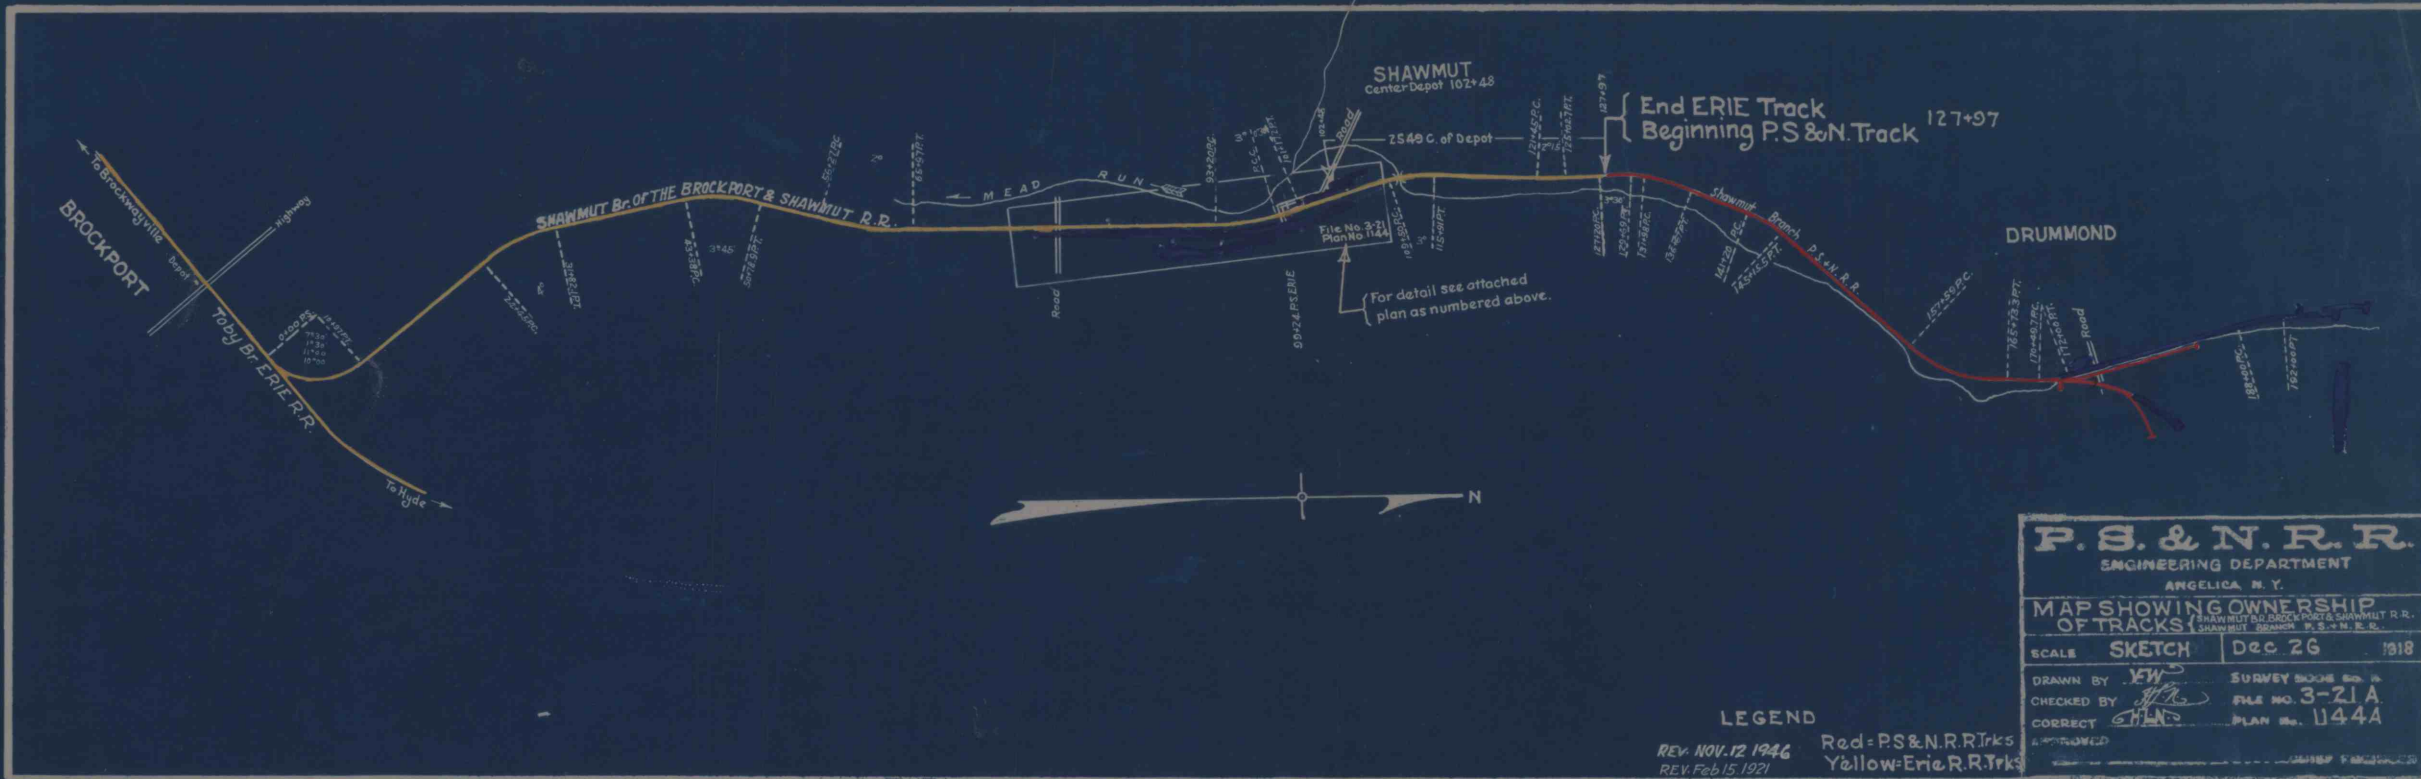

P.S. & N. R. R.			
ENGINEERING DEPARTMENT			
ANGELICA, N. Y.			
MAP SHOWING OWNERSHIP OF TRACKS SHAWMUT BR. OF BROCKPORT & SHAWMUT R.R. SHAWMUT BRANCH P.S. & N. R. R.			
SCALE	SKETCH	Dec 26	1918
DRAWN BY	JEW	SURVEY BOOK No. 4	
CHECKED BY	J.A.	FILE NO. 3-21A	
CORRECT	CHEN	PLAN No. 1144A	
APPROVED			

IMAPS# 15472