


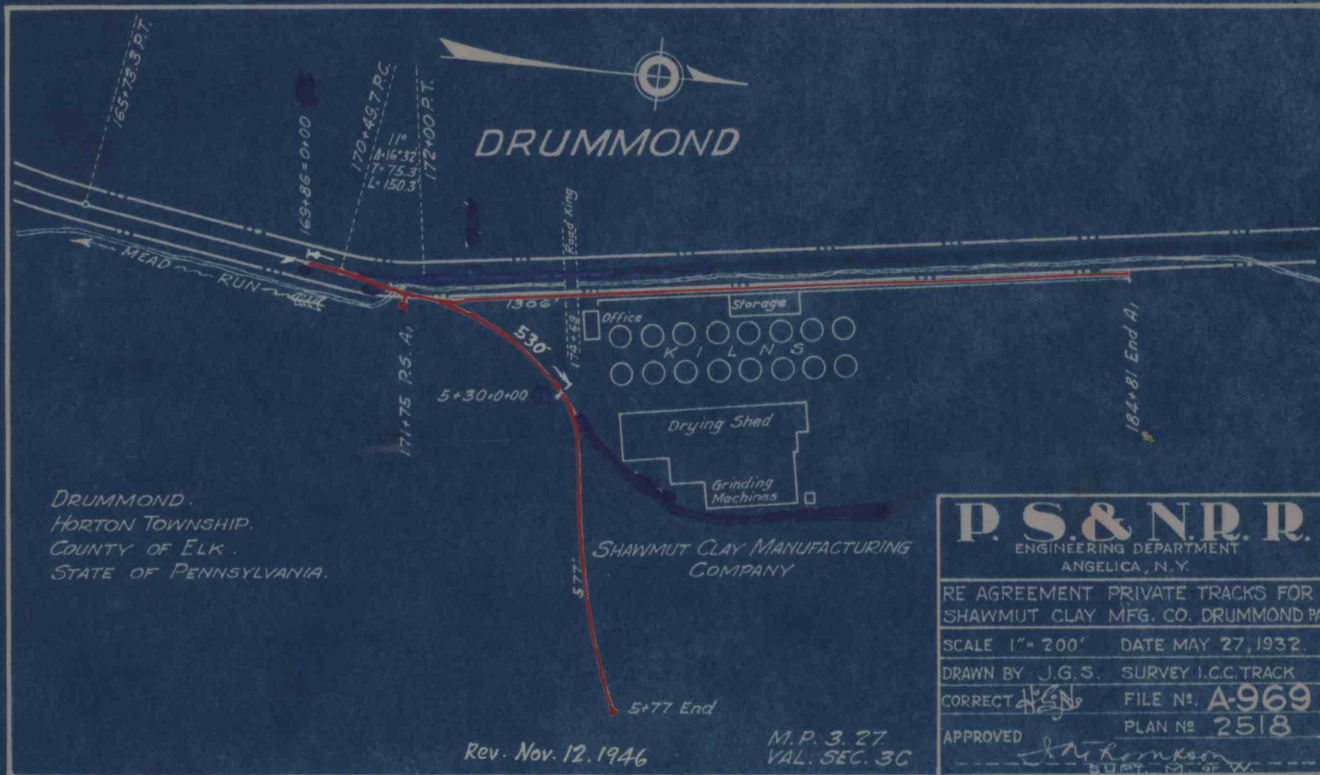

P. S. & N. R. R.

ENGINEERING DEPARTMENT
ANGELICA, N. Y.

RE AGREEMENT PRIVATE TRACKS FOR
SHAWMUT CLAY MFG. CO. DRUMMOND PA.

SCALE 1"=200' DATE MAY 27, 1932.

DRAWN BY J.G.S. SURVEY I.C.C. TRACK

CORRECT *H.G.N.* FILE NO. **A-969**

APPROVED *J. H. Kornborn* PLAN NO. **2518**

--- Supt. Eng. W. ---

IMAPS 15475