

SCANNED


#33 Lands of Shawmut
Horton Twp. / Elk County

104 15483

SHAWMUT MINING CO.
Lands of Shawmut Mining Company
in
Horton Twp. - Elk Co. Pa.
Surveyed July 1938

SHAWMUT MINING CO.
Lands of Shawmut Mining Company
Fox Twp. - Elk Co. Pa.
Surveyed July 1938

LACKING COAL THICKNESS INFORMATION

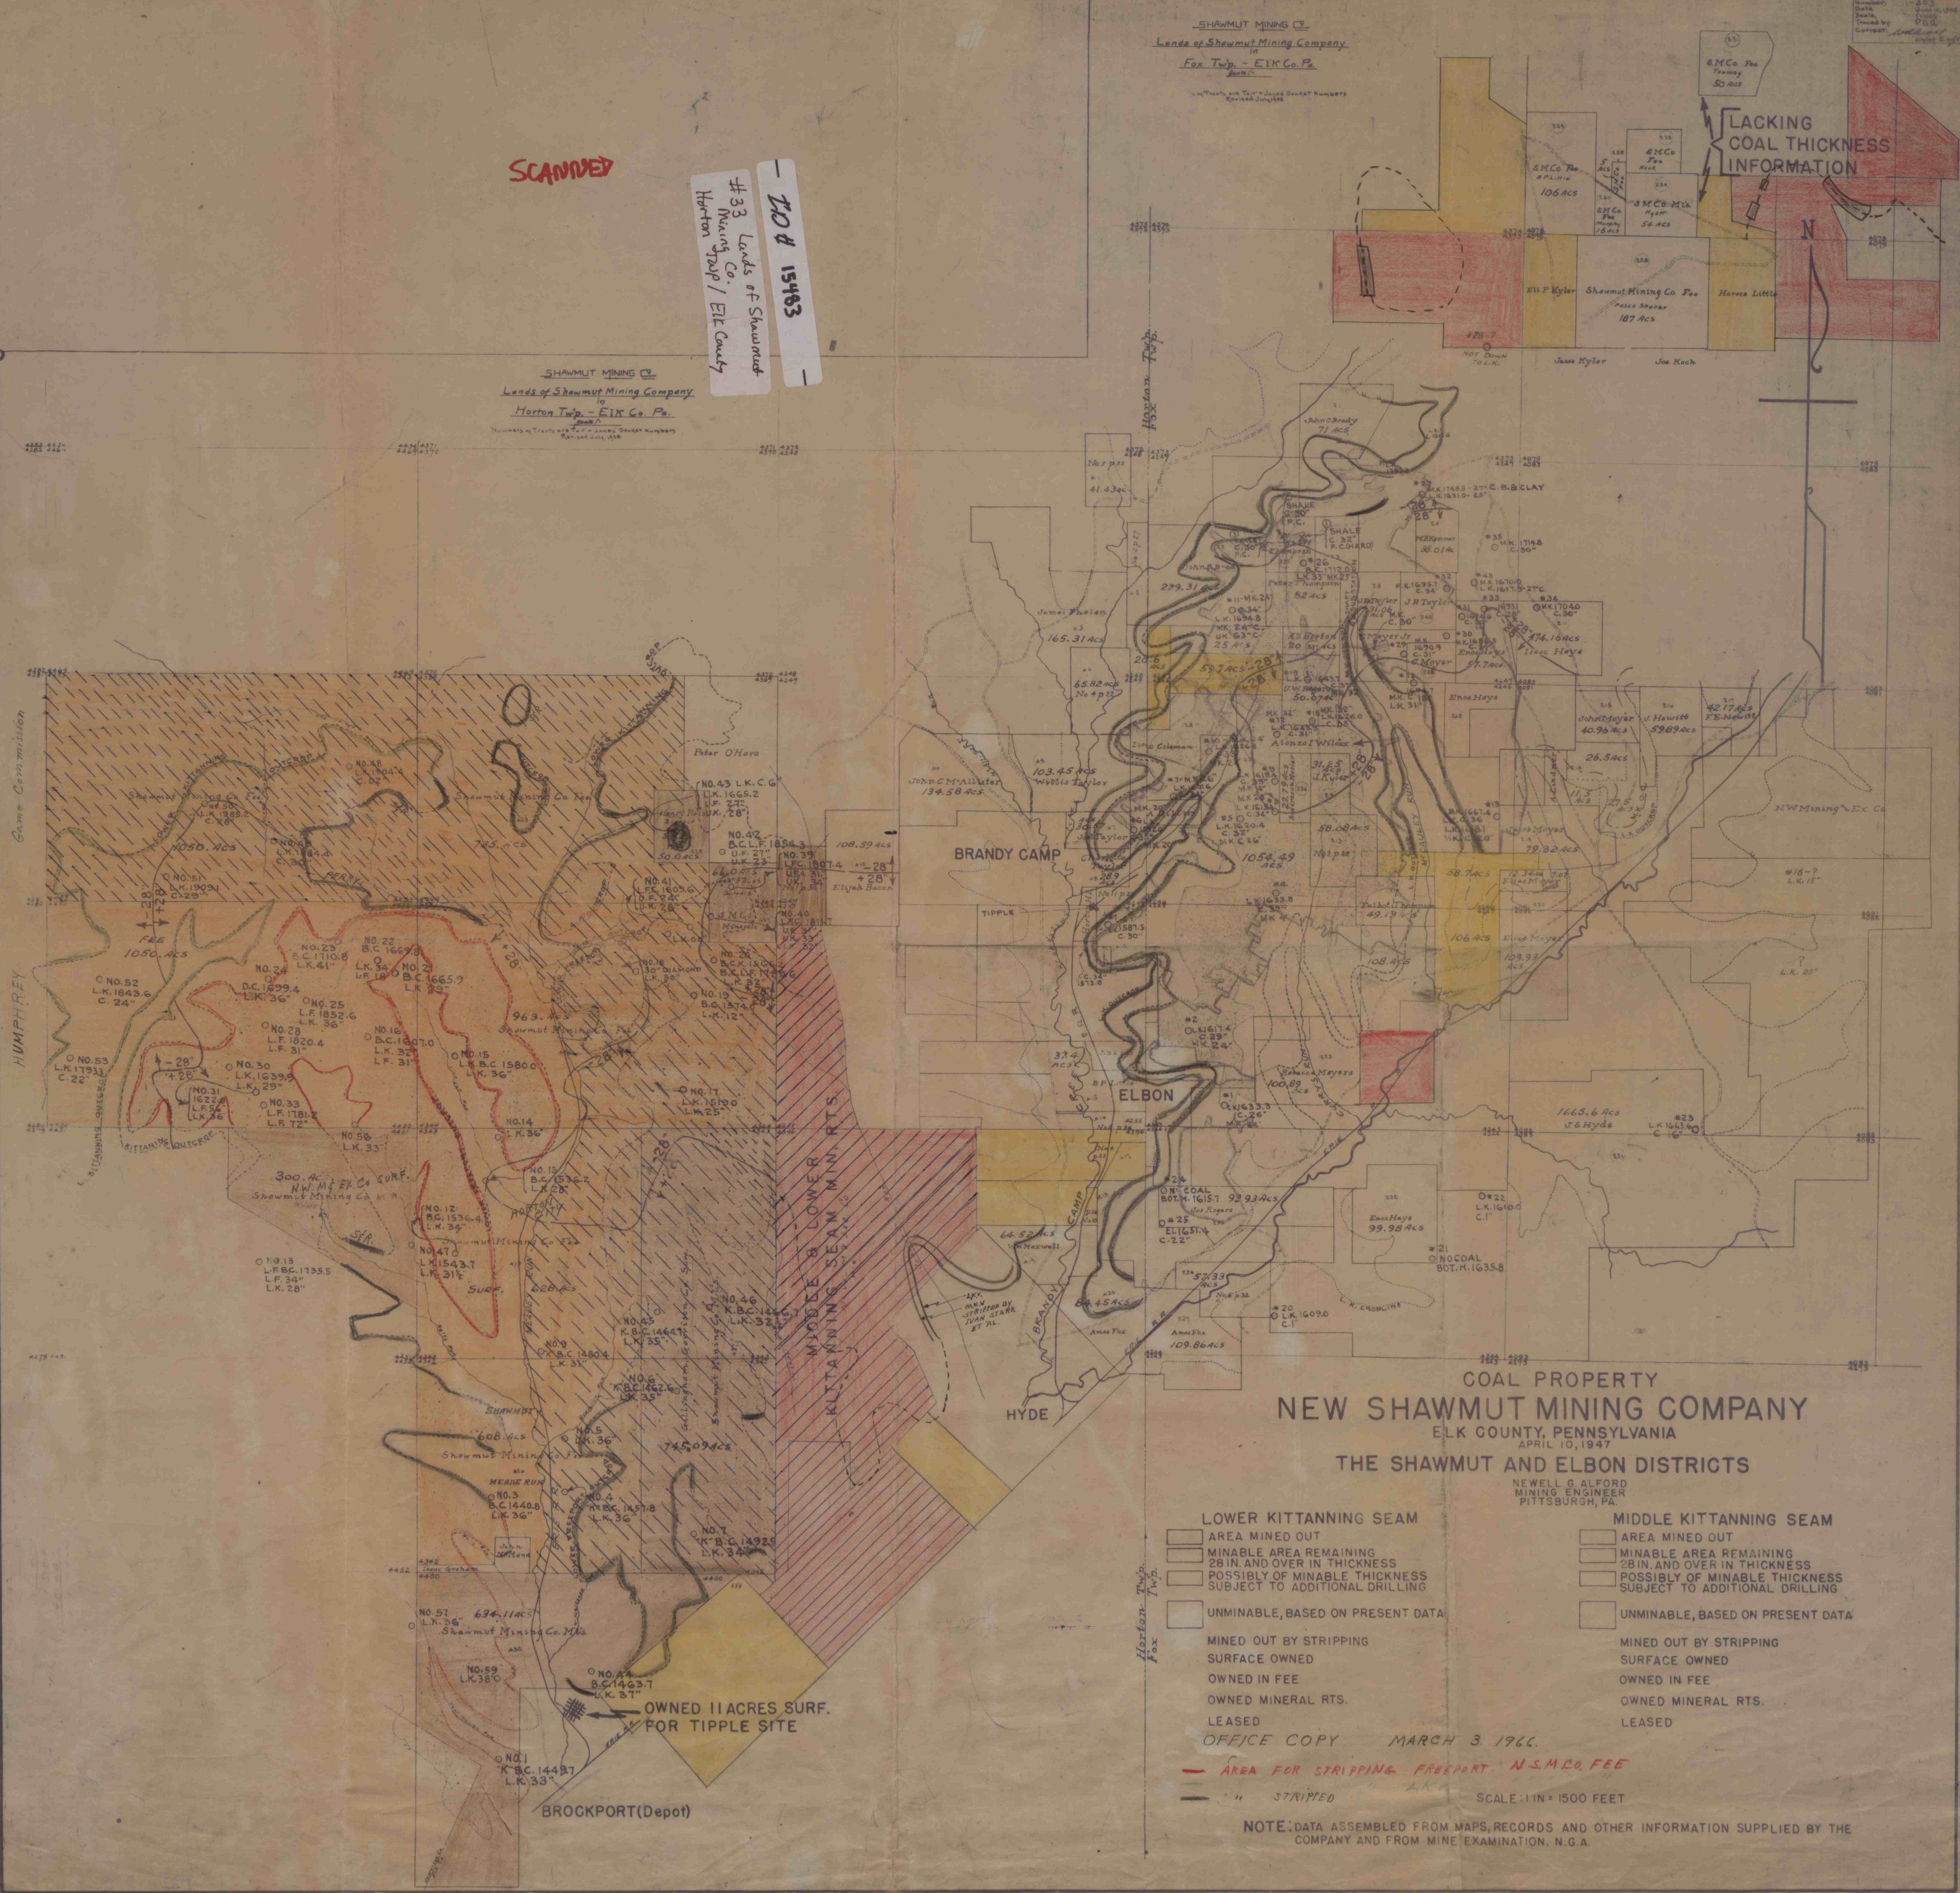

IMAPS #15483